


PARENT PARCEL: 10-00-021-000-059

CHILD PARCEL: ACREAGE CORR PER SURVEYOR THOMAS SIMON

STARTING POINT: MONUMENT BOX @ INTERSECTION OF C/LS OF HALE RD & PARSONS RD

23-05159-A

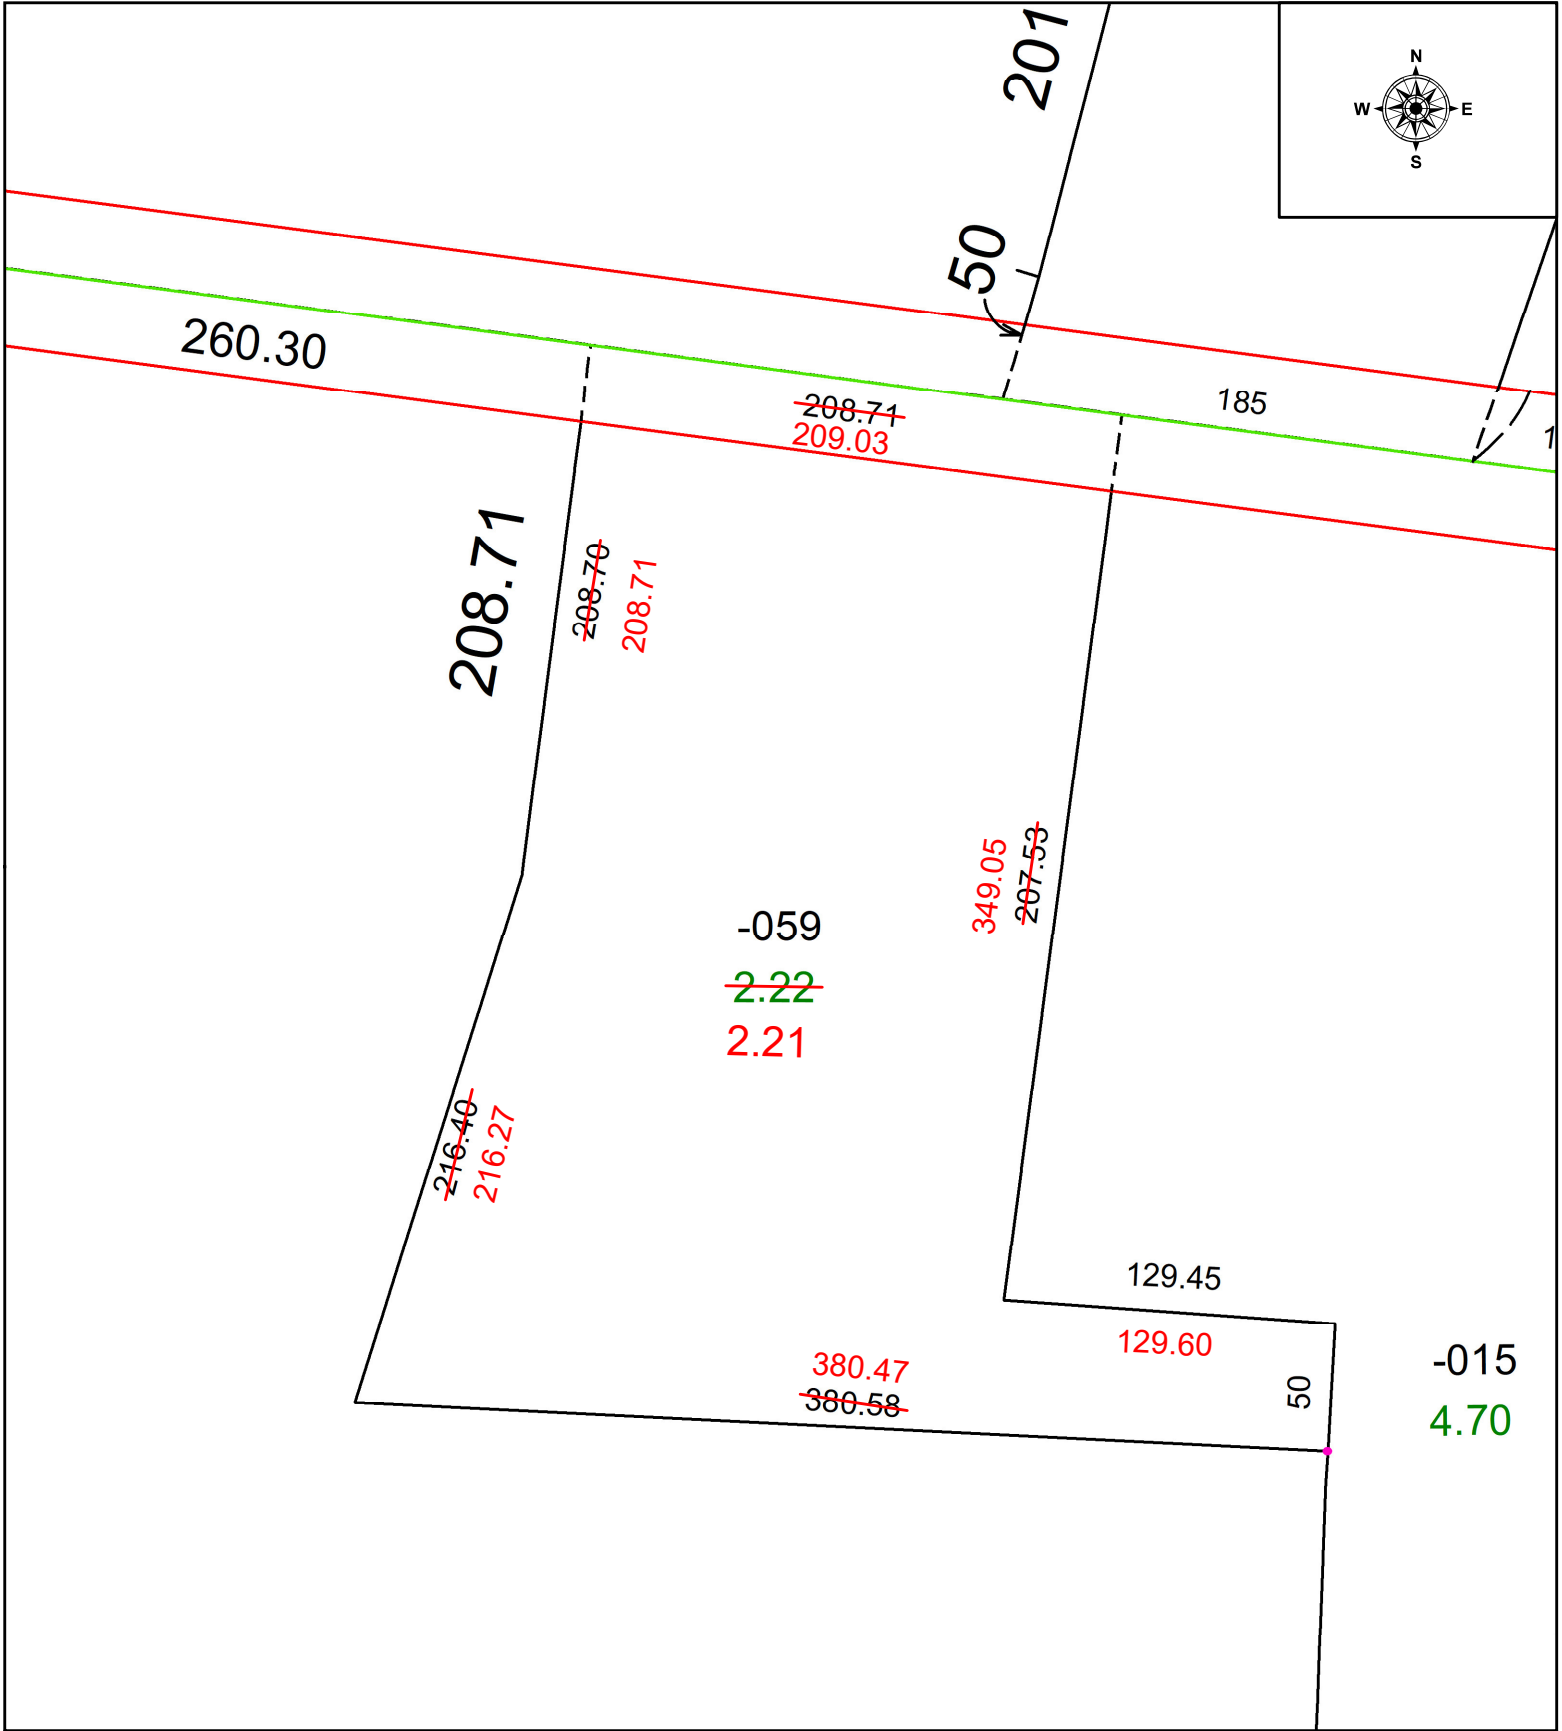

SPLITS/DEEDS PROCESSED
 LORAIN COUNTY TAX MAP DEPARTMENT
 226 MIDDLE AVE. ELYRIA, OH

SURVEYED BY: THOMAS SIMON SURVEY # 51016
 CLOSURE: 1: 246852
 MAP PAGE(S): 10-00-021
 APPROVED BY: WRZ DATE: 9/27/2023
 SCALE: 1" = 75 PRIOR INSTRUMENT: DV 1215 PG 5