


PARENT PARCEL: ADD TO DUP. GAS WELL API # 34093607170

CHILD PARCEL: 15-00-056-630-001


STARTING POINT: NA

23-05167-A

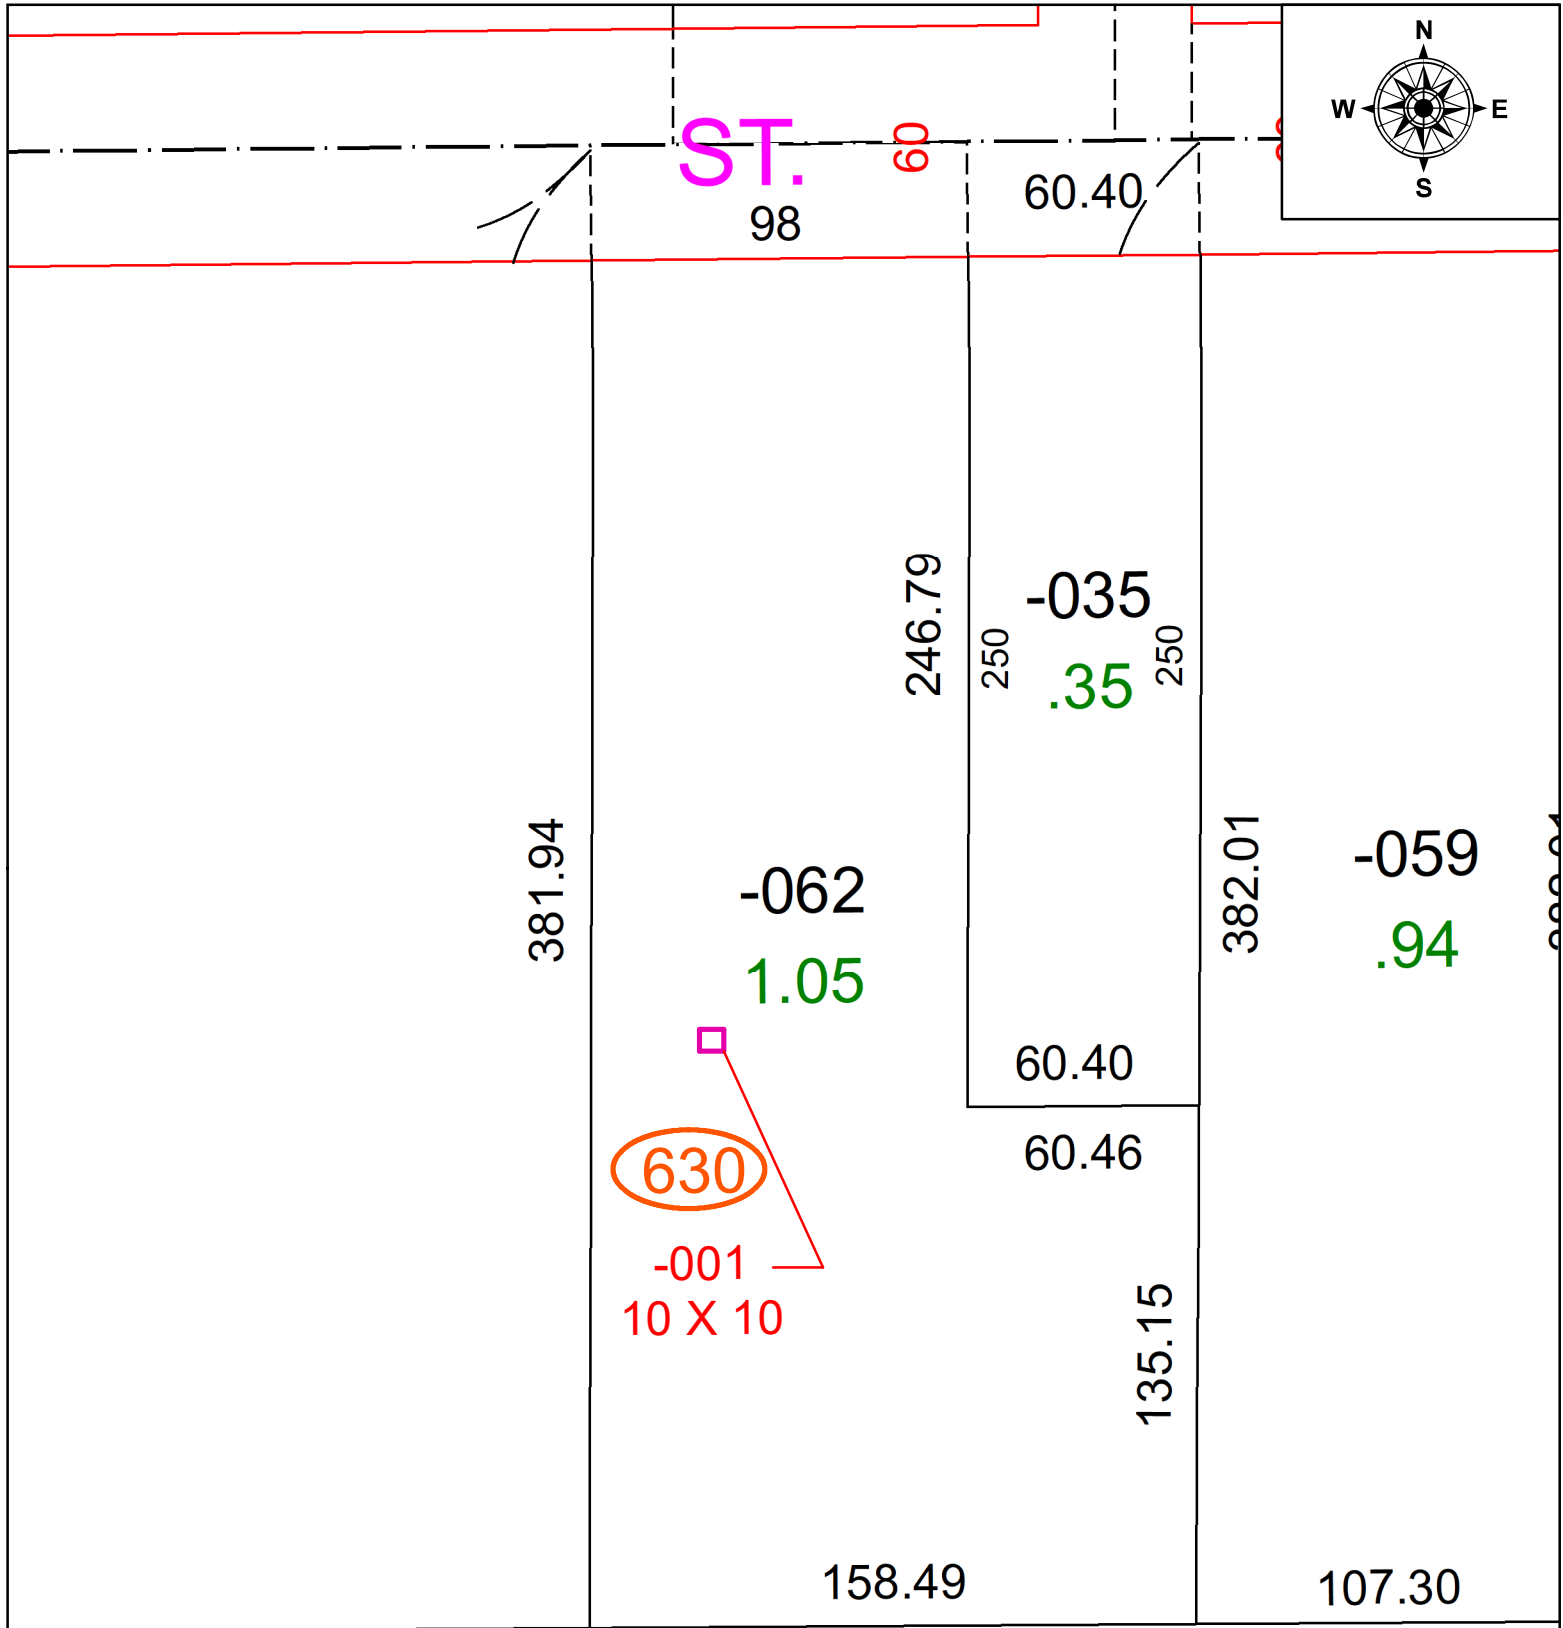

719 50

35. 68

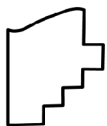

**SPLITS/DEEDS PROCESSED**  
 LORAIN COUNTY TAX MAP DEPARTMENT  
 226 MIDDLE AVE. ELYRIA, OH

SURVEYED BY: NA  
 CLOSURE: NA  
 MAP PAGE(S): 11-00-025  
 APPROVED BY: TJS DATE: 10/11/2023  
 SCALE: 1" = 50' PRIOR INSTRUMENT: NA