
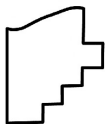
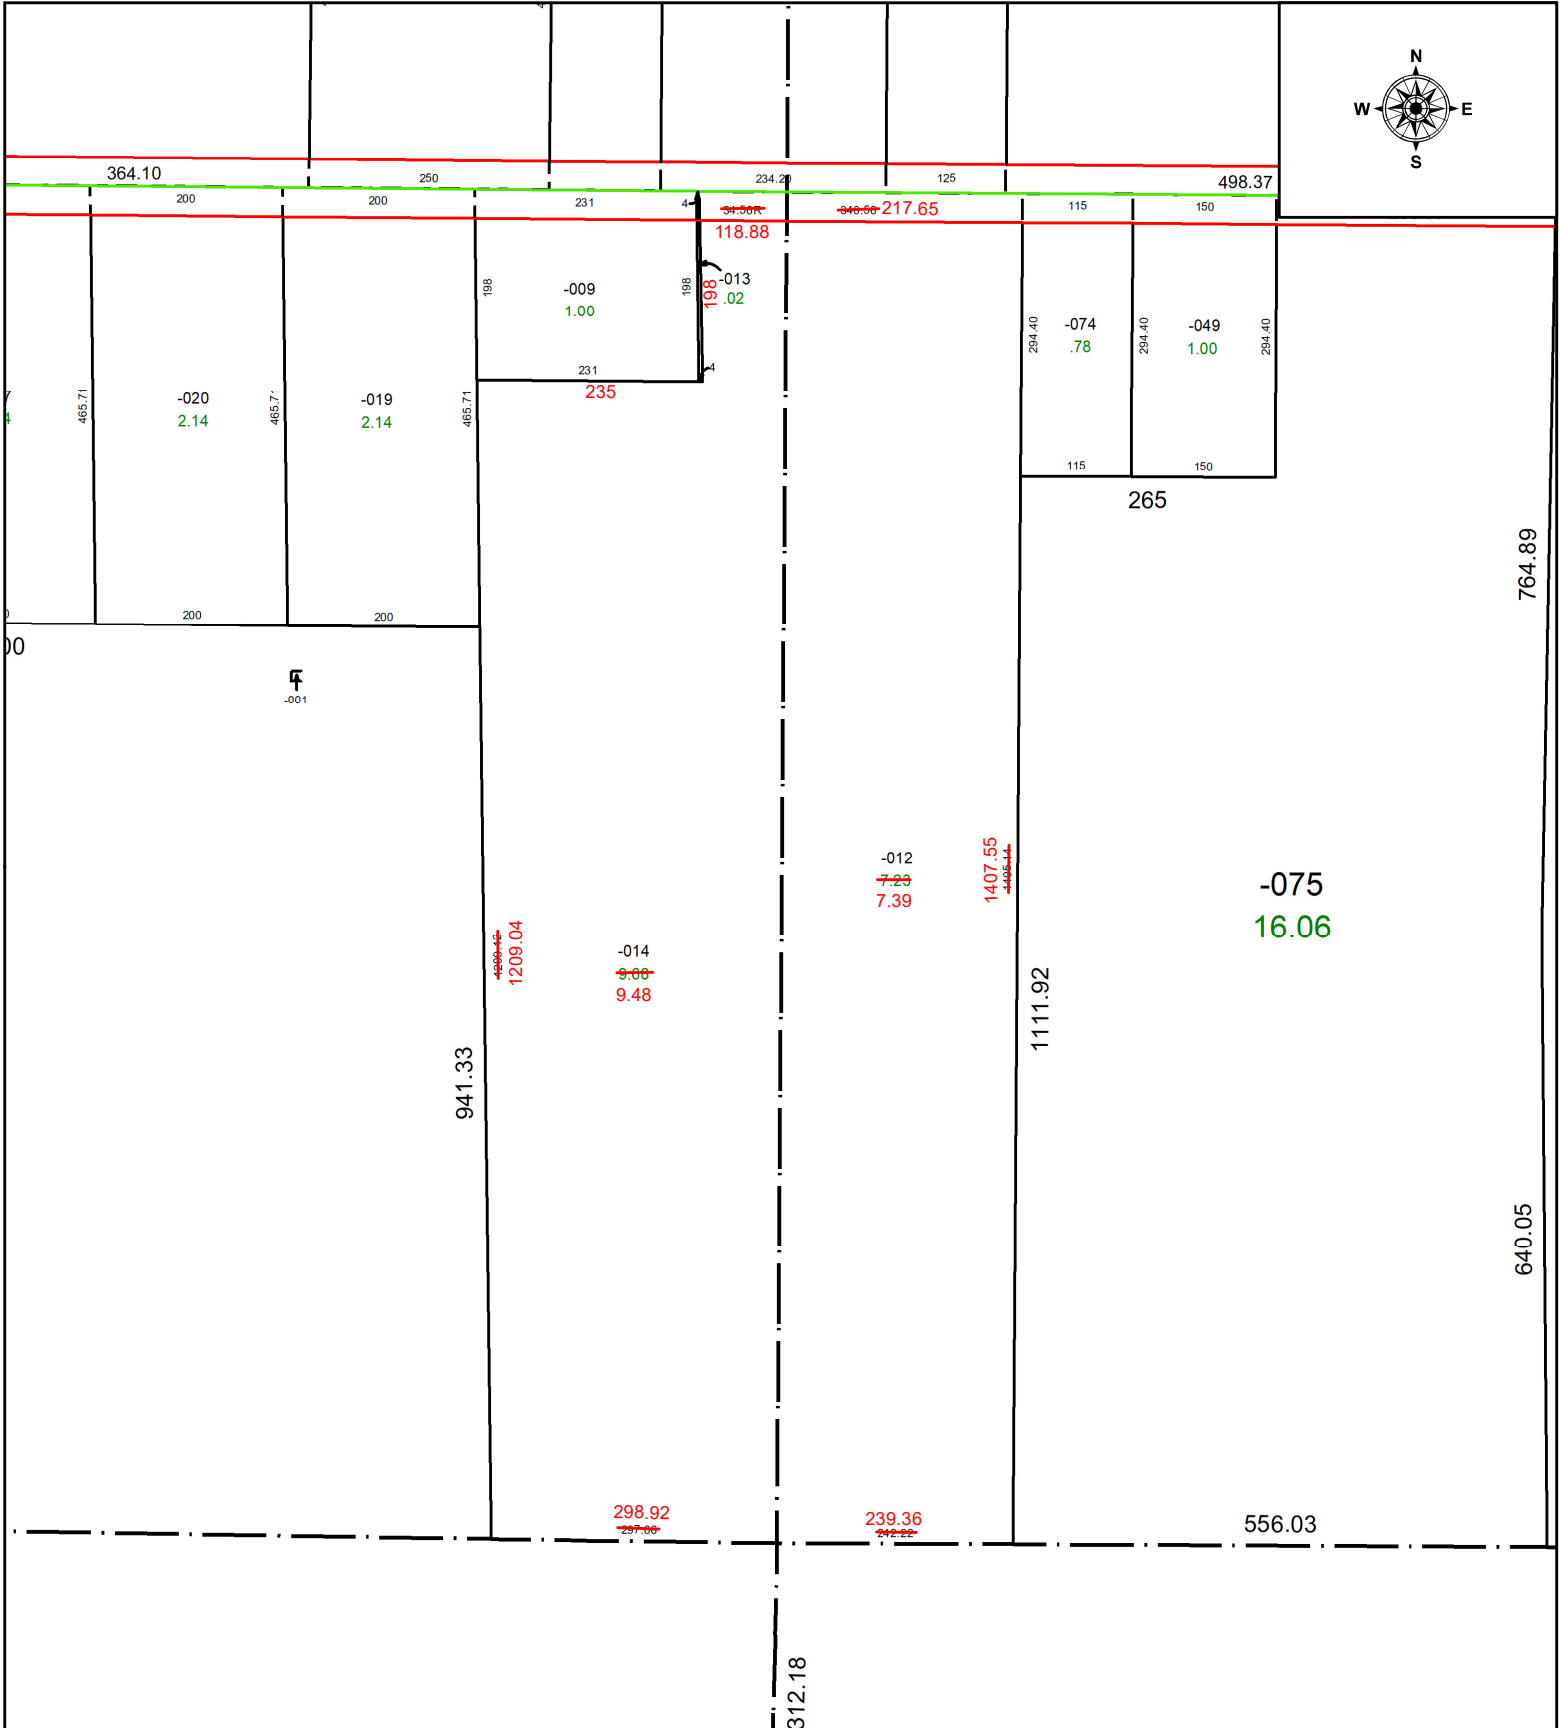


PARENT PARCEL: 12-00-059-000-014 & 12-00-042-000-012

CHILD PARCEL: AC CORR PER SURVEYOR JOHN DECHANT JR

STARTING POINT: MONUMENT BOX @ C/LS OF OSBORNE RD & JAQUAY RD

23-05168-A

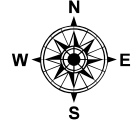

SPLITS/DEEDS PROCESSED
 LORAIN COUNTY TAX MAP DEPARTMENT
 226 MIDDLE AVE. ELYRIA, OH

SURVEYED BY: JOHN DECHANT JR. SURVEY # 51024
 CLOSURE: 1: 540900
 MAP PAGE(S): 12-00-059 & 12-00-042
 APPROVED BY: WRZ DATE: 10/12/2023
 SCALE: 1" = 200 PRIOR INSTRUMENT: #2023-0931660