




PARENT PARCEL: _____

CHILD PARCEL: _____

VACATION OF PORTION OF CAROLINE AVE PER ORD. #203-23

STARTING POINT: _____

23-05171-V

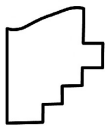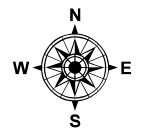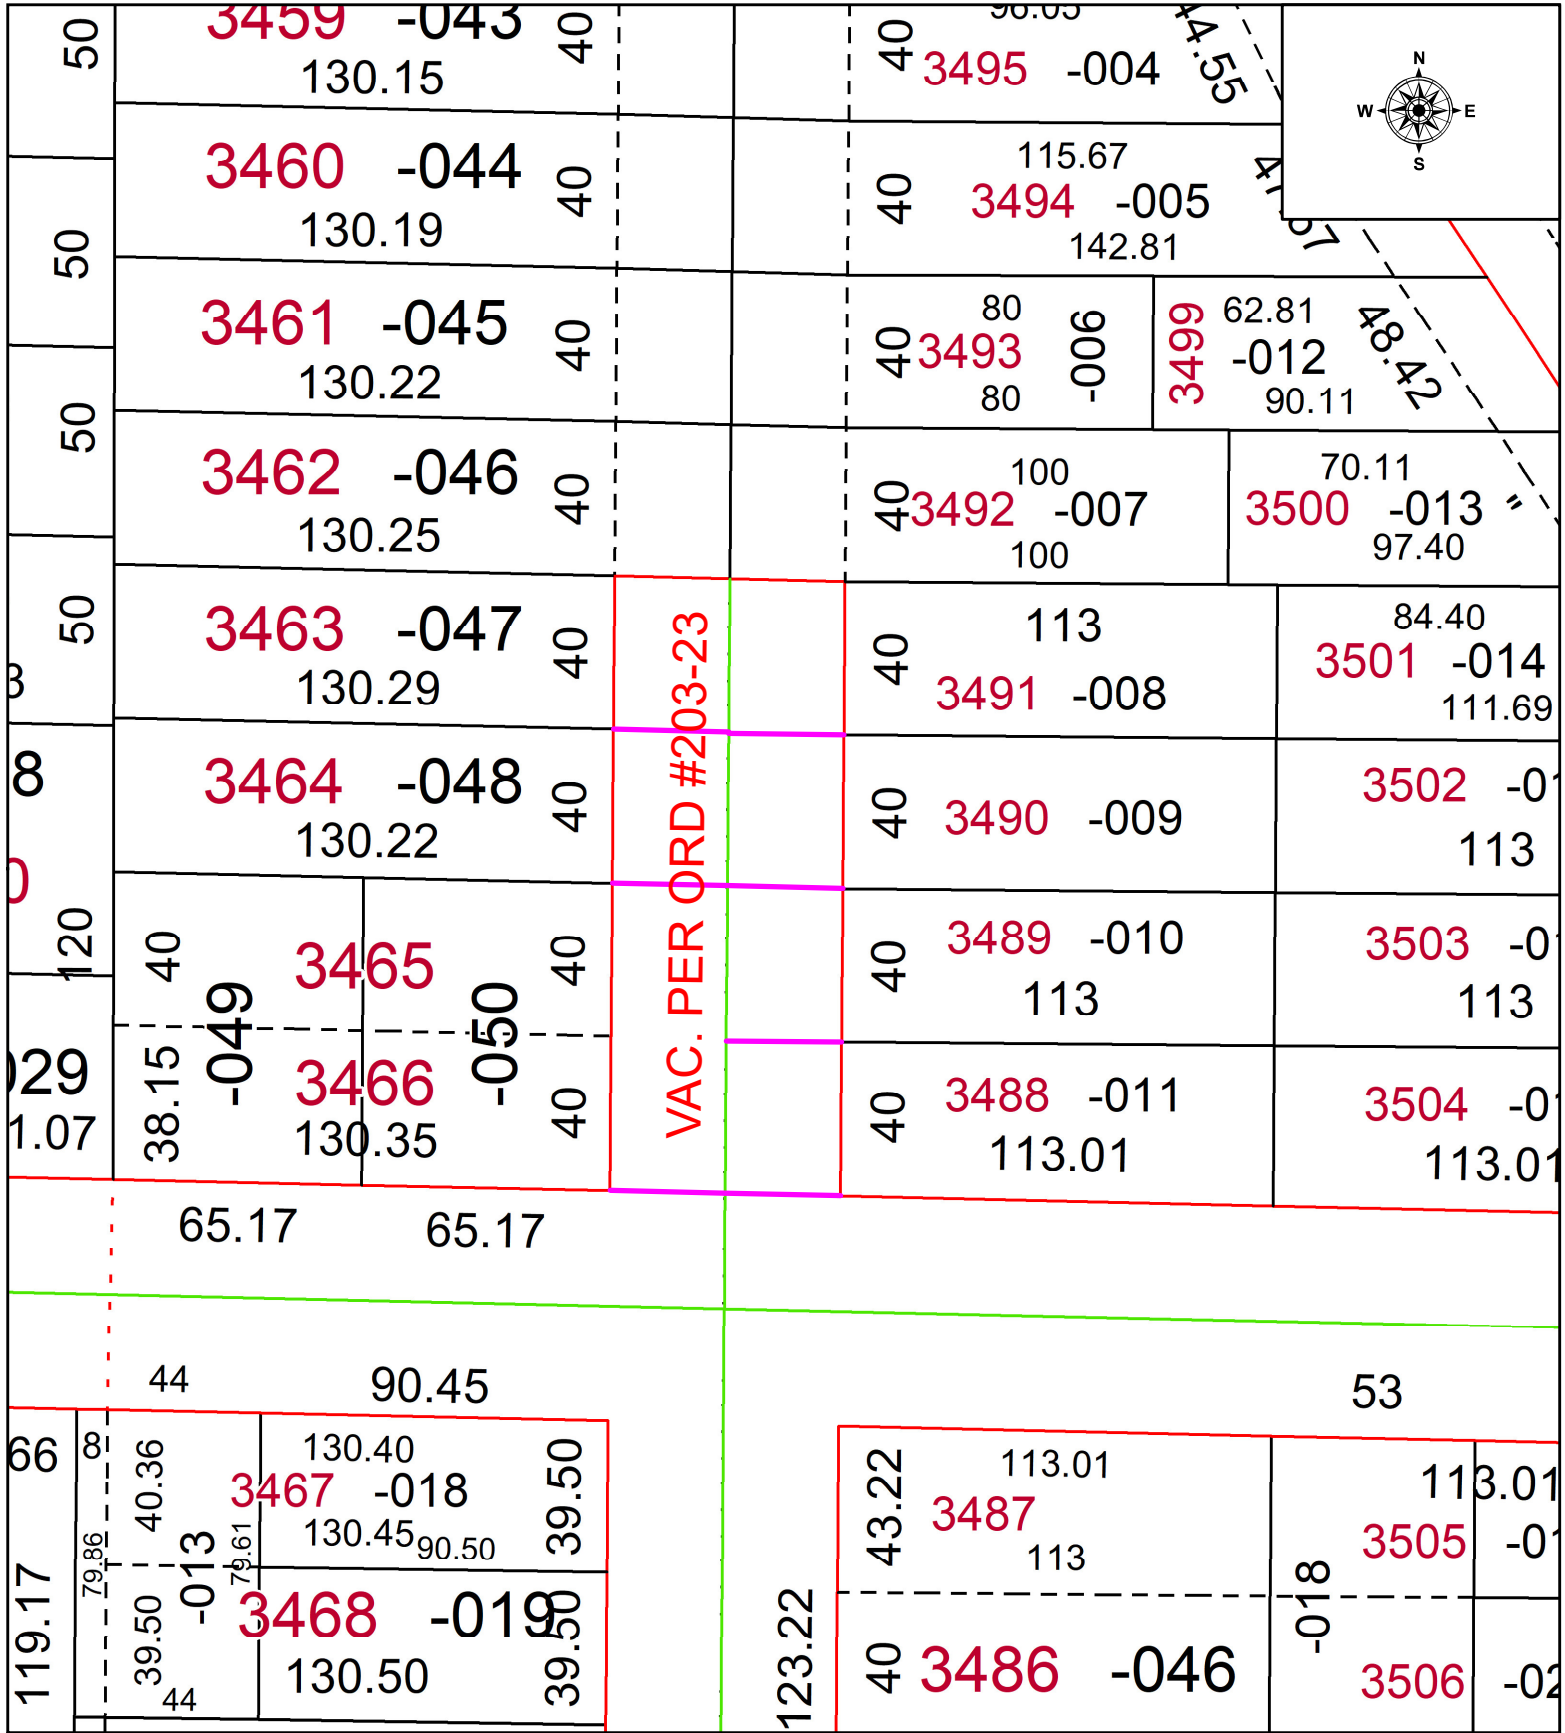

SPLITS/DEEDS PROCESSED
 LORAIN COUNTY TAX MAP DEPARTMENT
 226 MIDDLE AVE. ELYRIA, OH

SURVEYED BY: _____ N/A SURVEY # _____
 CLOSURE: _____ 1: _____
 MAP PAGE(S): _____ 02-00-093
 APPROVED BY: _____ WRZ DATE: _____ 10/16/2023
 SCALE: _____ 1" = 50 PRIORITY INSTRUMENT: _____ N/A