
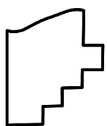


PARENT PARCEL: 07-00-044-102-027

CHILD PARCEL: AC CORR PER SURVEYOR WILFREDO BARBOSA

STARTING POINT: C/L S OF BURNS RD & CASE RD

23-05174-C

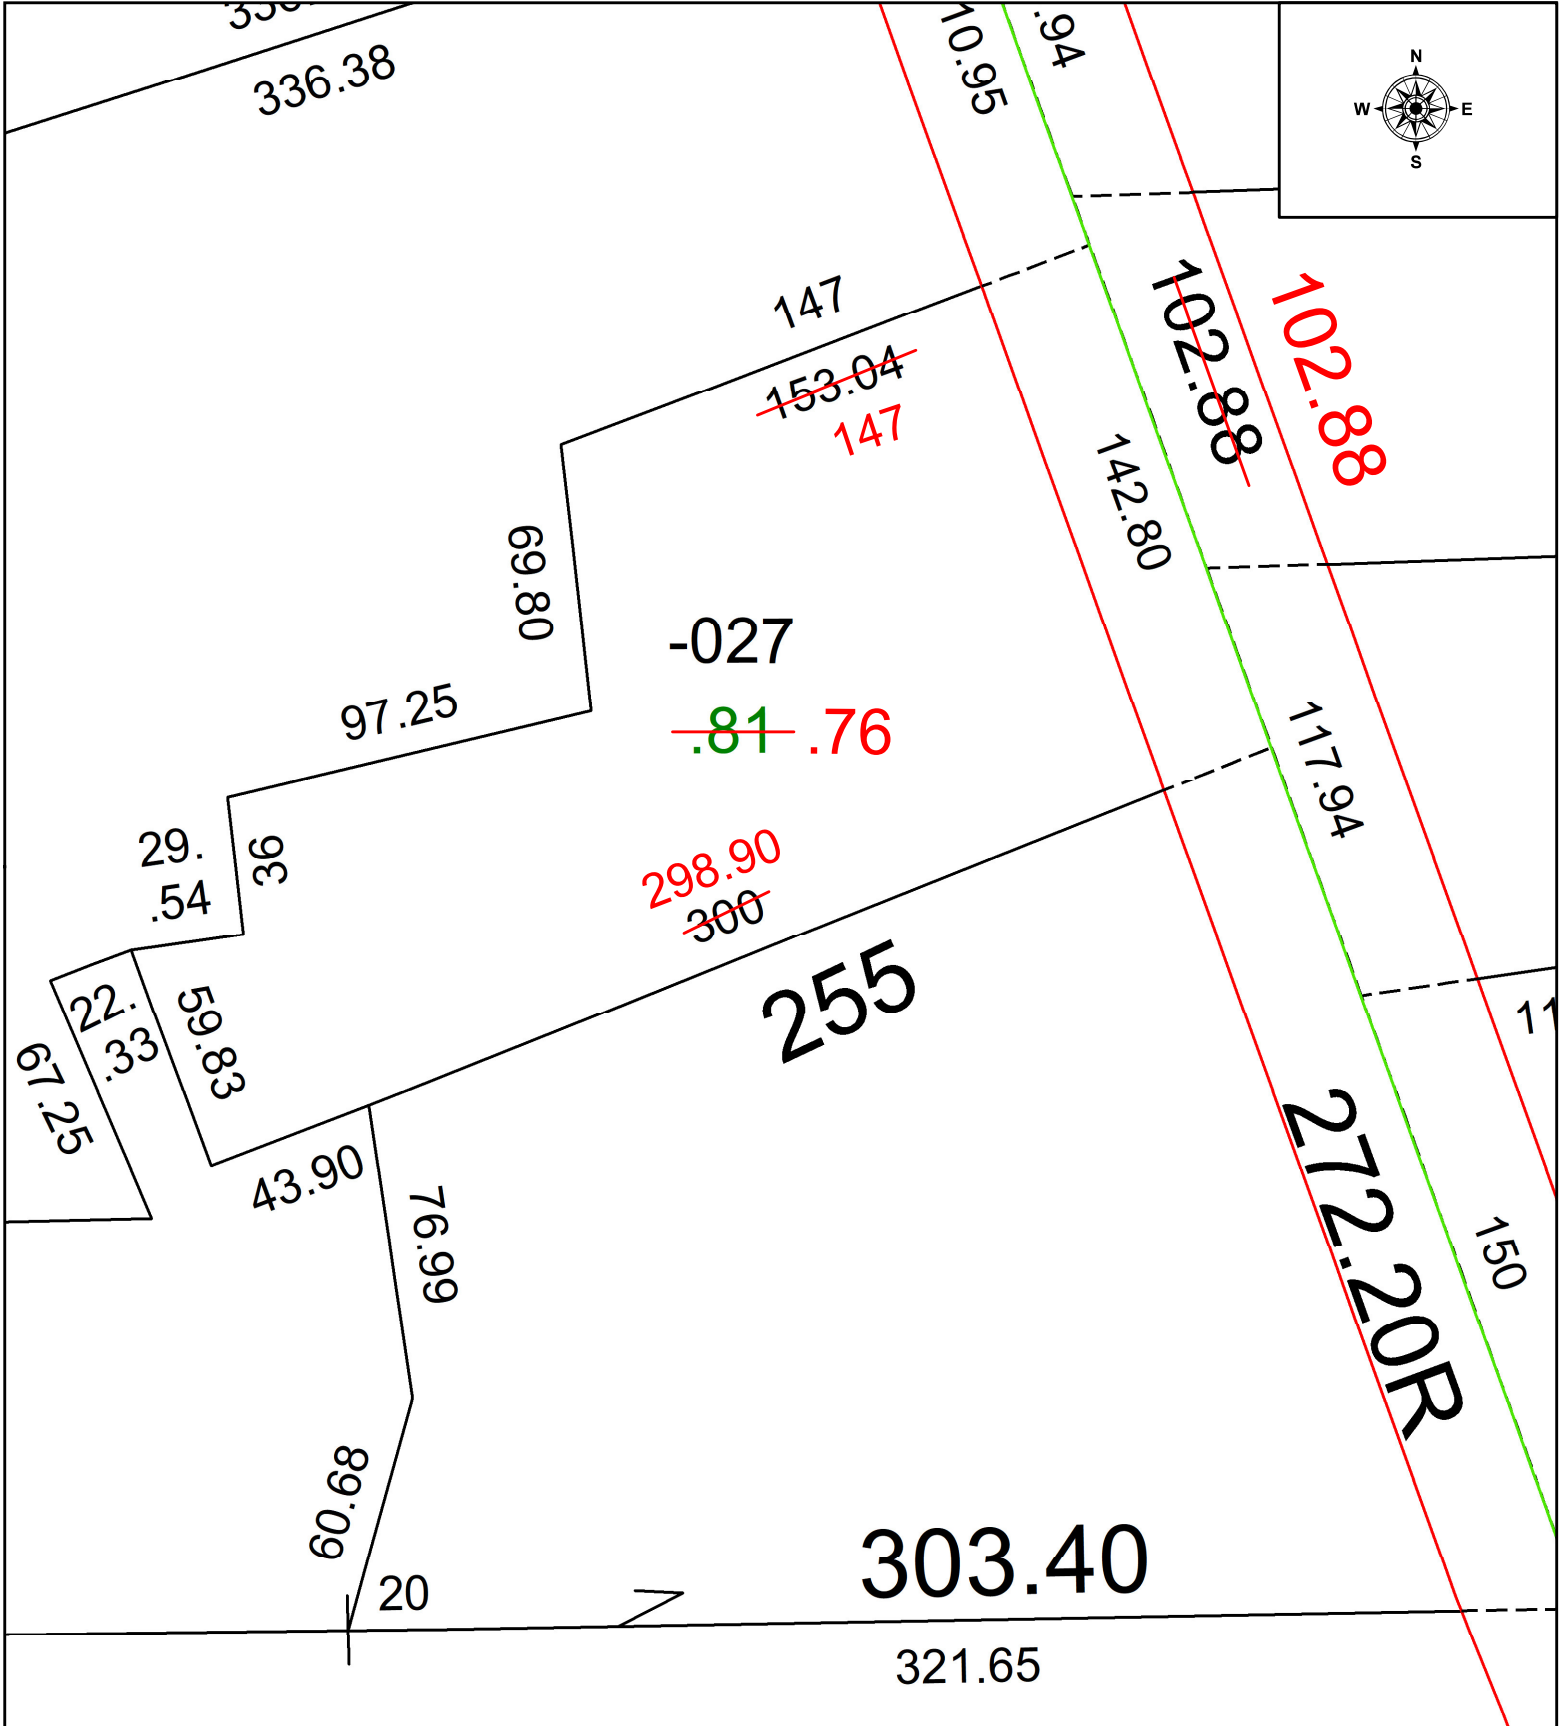

SPLITS/DEEDS PROCESSED
 LORAIN COUNTY TAX MAP DEPARTMENT
 226 MIDDLE AVE. ELYRIA, OH

SURVEYED BY: WILFREDO BARBOSA SURVEY #51028
 CLOSURE: 1: 257666
 MAP PAGE(S): 07-00-044
 APPROVED BY: WRZ DATE: 10/18/2023
 SCALE: 1" = 50 PRIOR INSTRUMENT: #2022-0893802