


PARENT PARCEL: 02-01-003-170-019


CHILD PARCEL: N/A

FRONTAGE & DEPTH TO ACREAGE

23-05177-C

STARTING POINT: SE CORNER OF S/L 1 OF HOGANS 4TH ADDITION

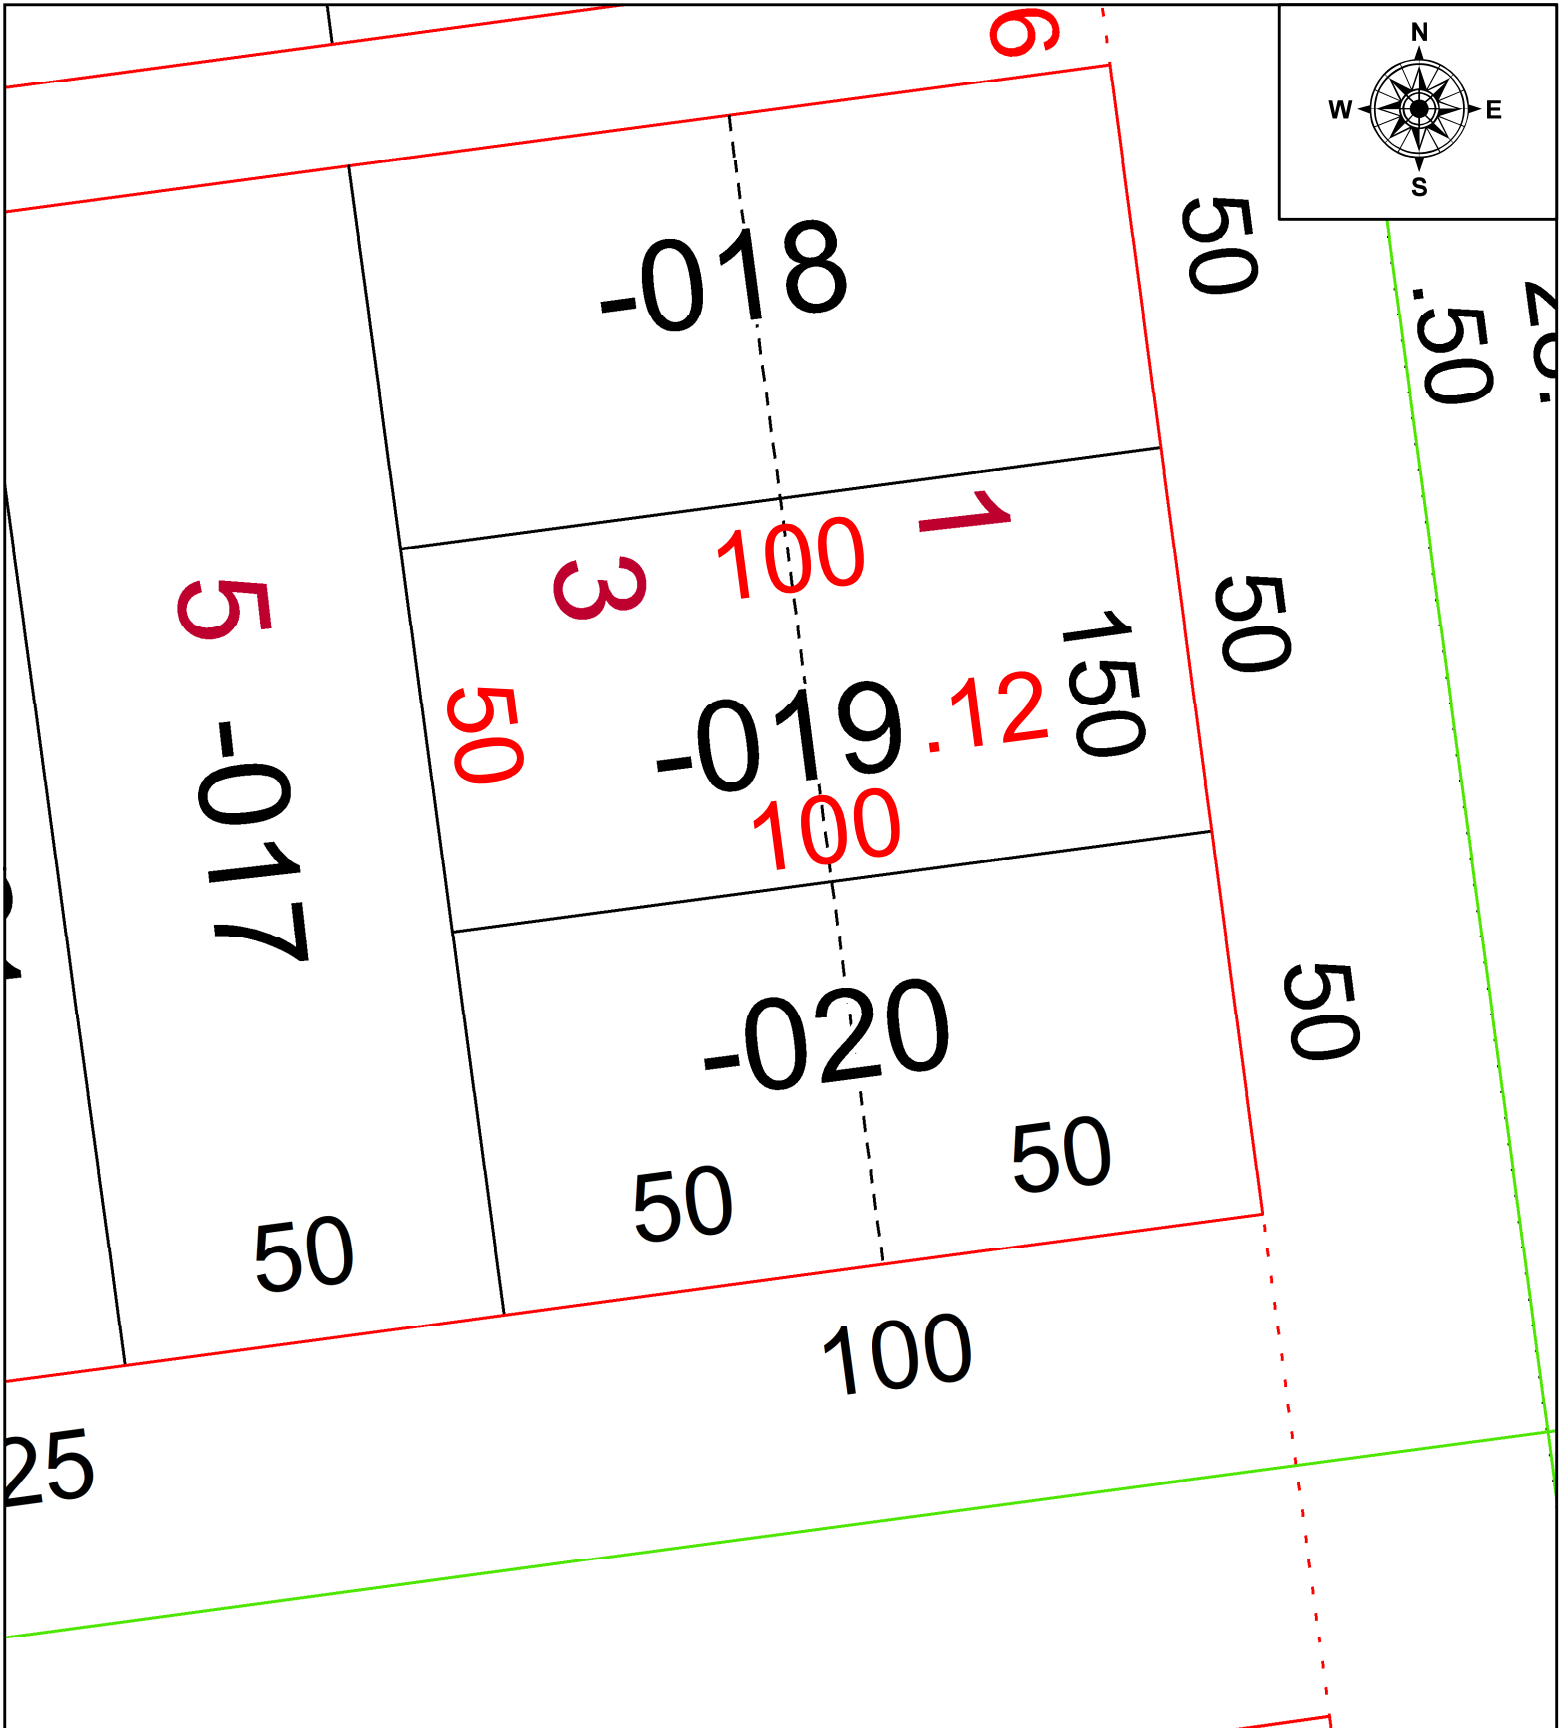

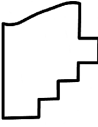 **SPLITS/DEEDS PROCESSED**
 LORAIN COUNTY TAX MAP DEPARTMENT
 226 MIDDLE AVE. ELYRIA, OH

SURVEYED BY: THOMAS A SIMON SURVEY #: 51032
 CLOSURE: 1: ∞
 MAP PAGE(S): 02-01-003
 APPROVED BY: SP DATE: 10/20/2023
 SCALE: 1" = 25' PRIOR INSTRUMENT: 2021-0851940