
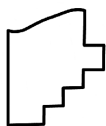
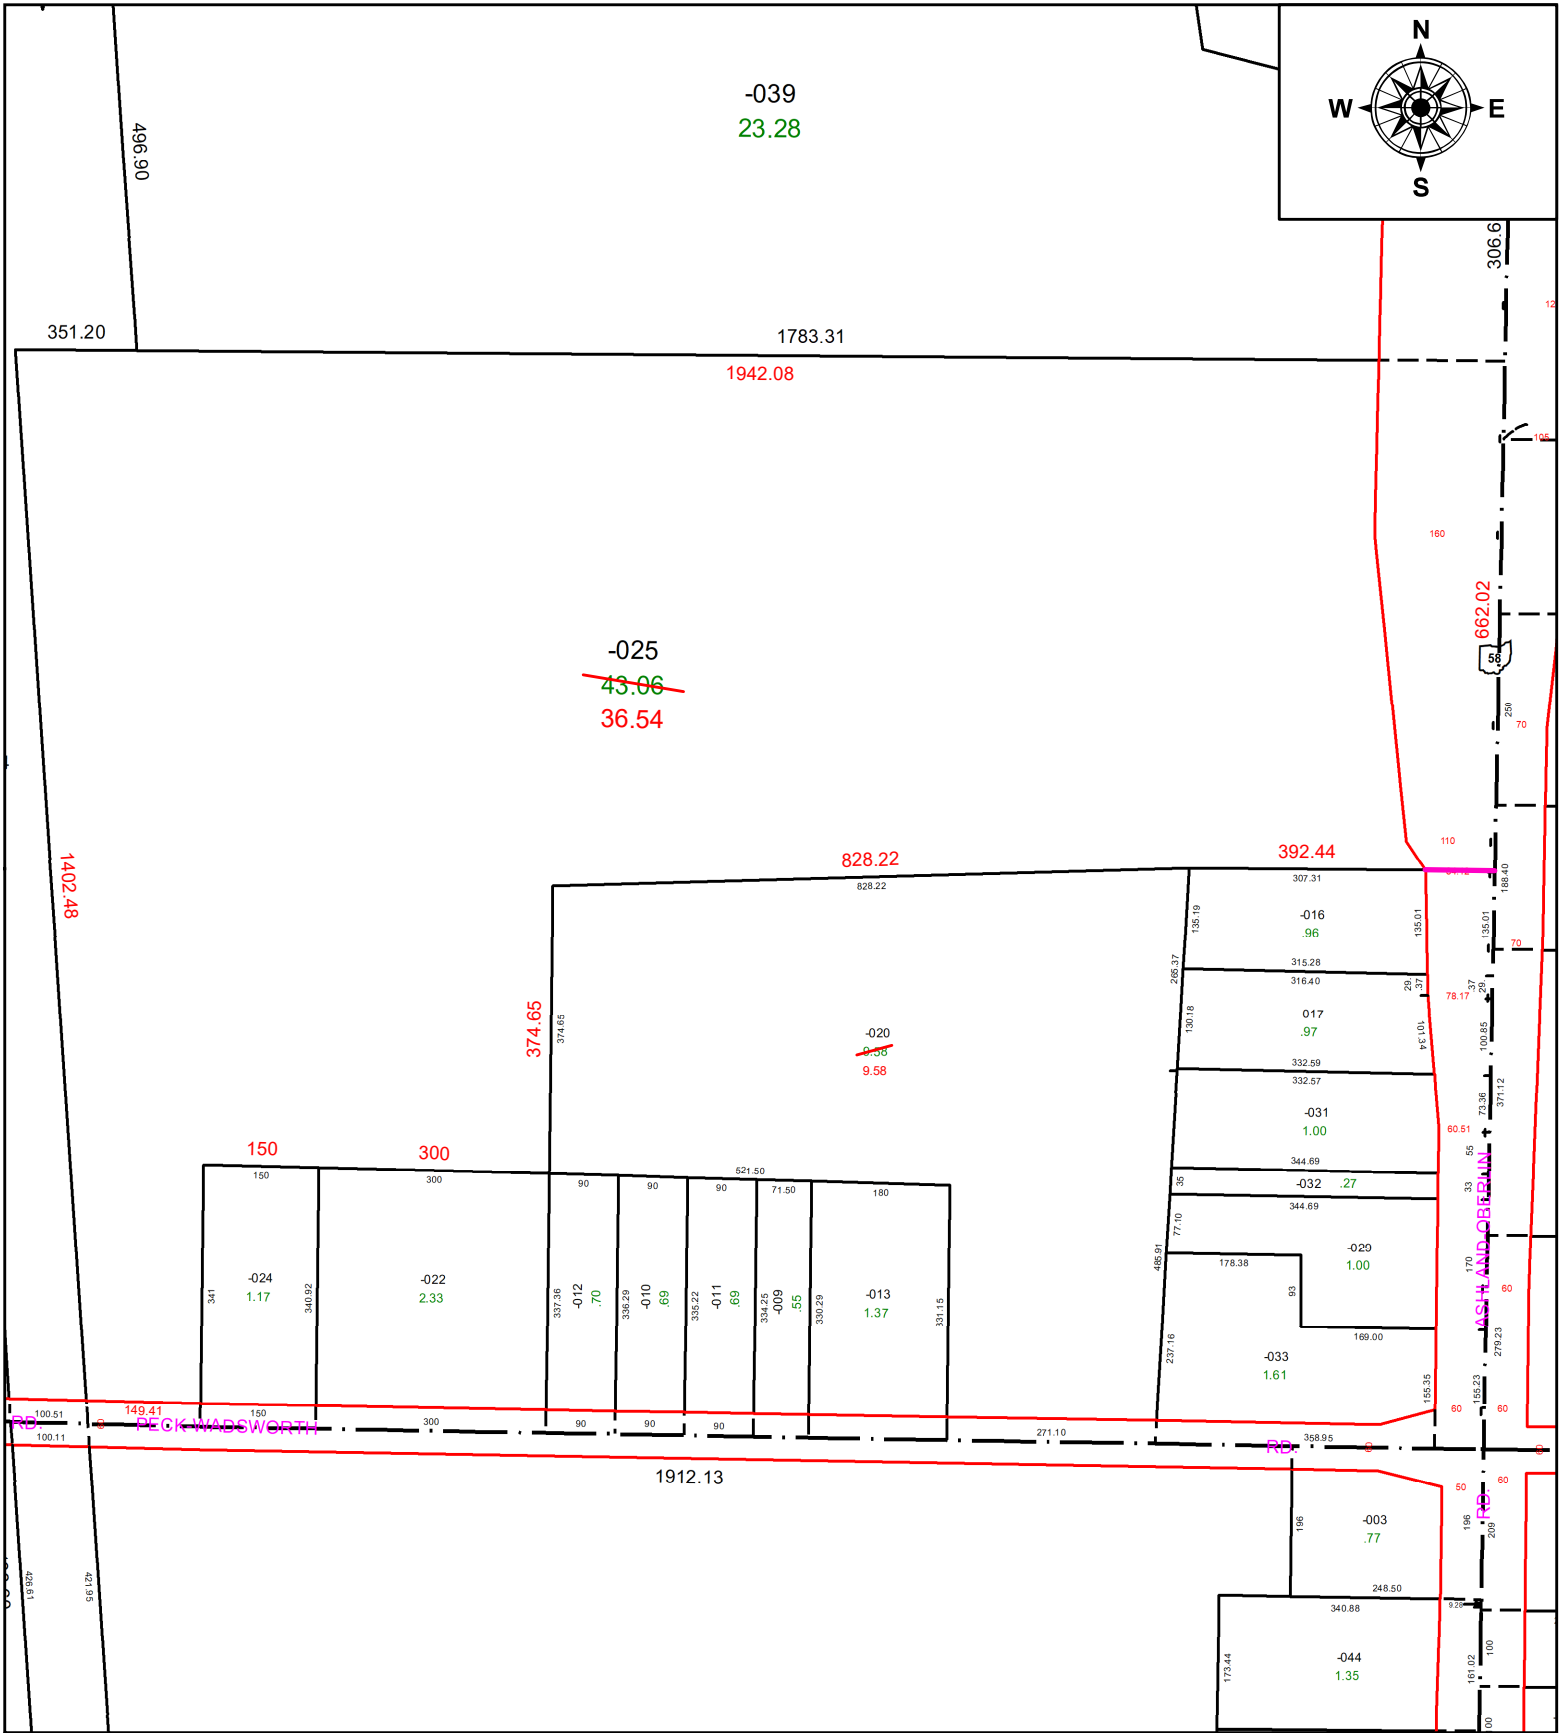


PARENT PARCEL: 18-00-030-000-025

CHILD PARCEL: AC. CORR. PER SURVEY THOMAS SNEZEK

STARTING POINT: C/L S.R. 58 & PECK WADSWORTH RD

23-05179-C

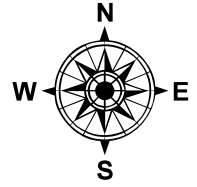

SPLITS/DEEDS PROCESSED
LORAIN COUNTY TAX MAP DEPARTMENT
226 MIDDLE AVE. ELYRIA, OH

SURVEYED BY: THOMAS SNEZEK SURVEY #: 51035
CLOSURE: 1:4278723
MAP PAGE(S): 06-25-003
APPROVED BY: DMA DATE: 10/24/2023
SCALE: 1" = 250' PRIOR INSTRUMENT: 2021-0828344