


PARENT PARCEL: 06-24-017-900-013

CHILD PARCEL: ROAD NAME CHANGE PER CERTIFICATE OF CORR. PER INSTR. # 2023-0930929

STARTING POINT: N/A

23-05192-C

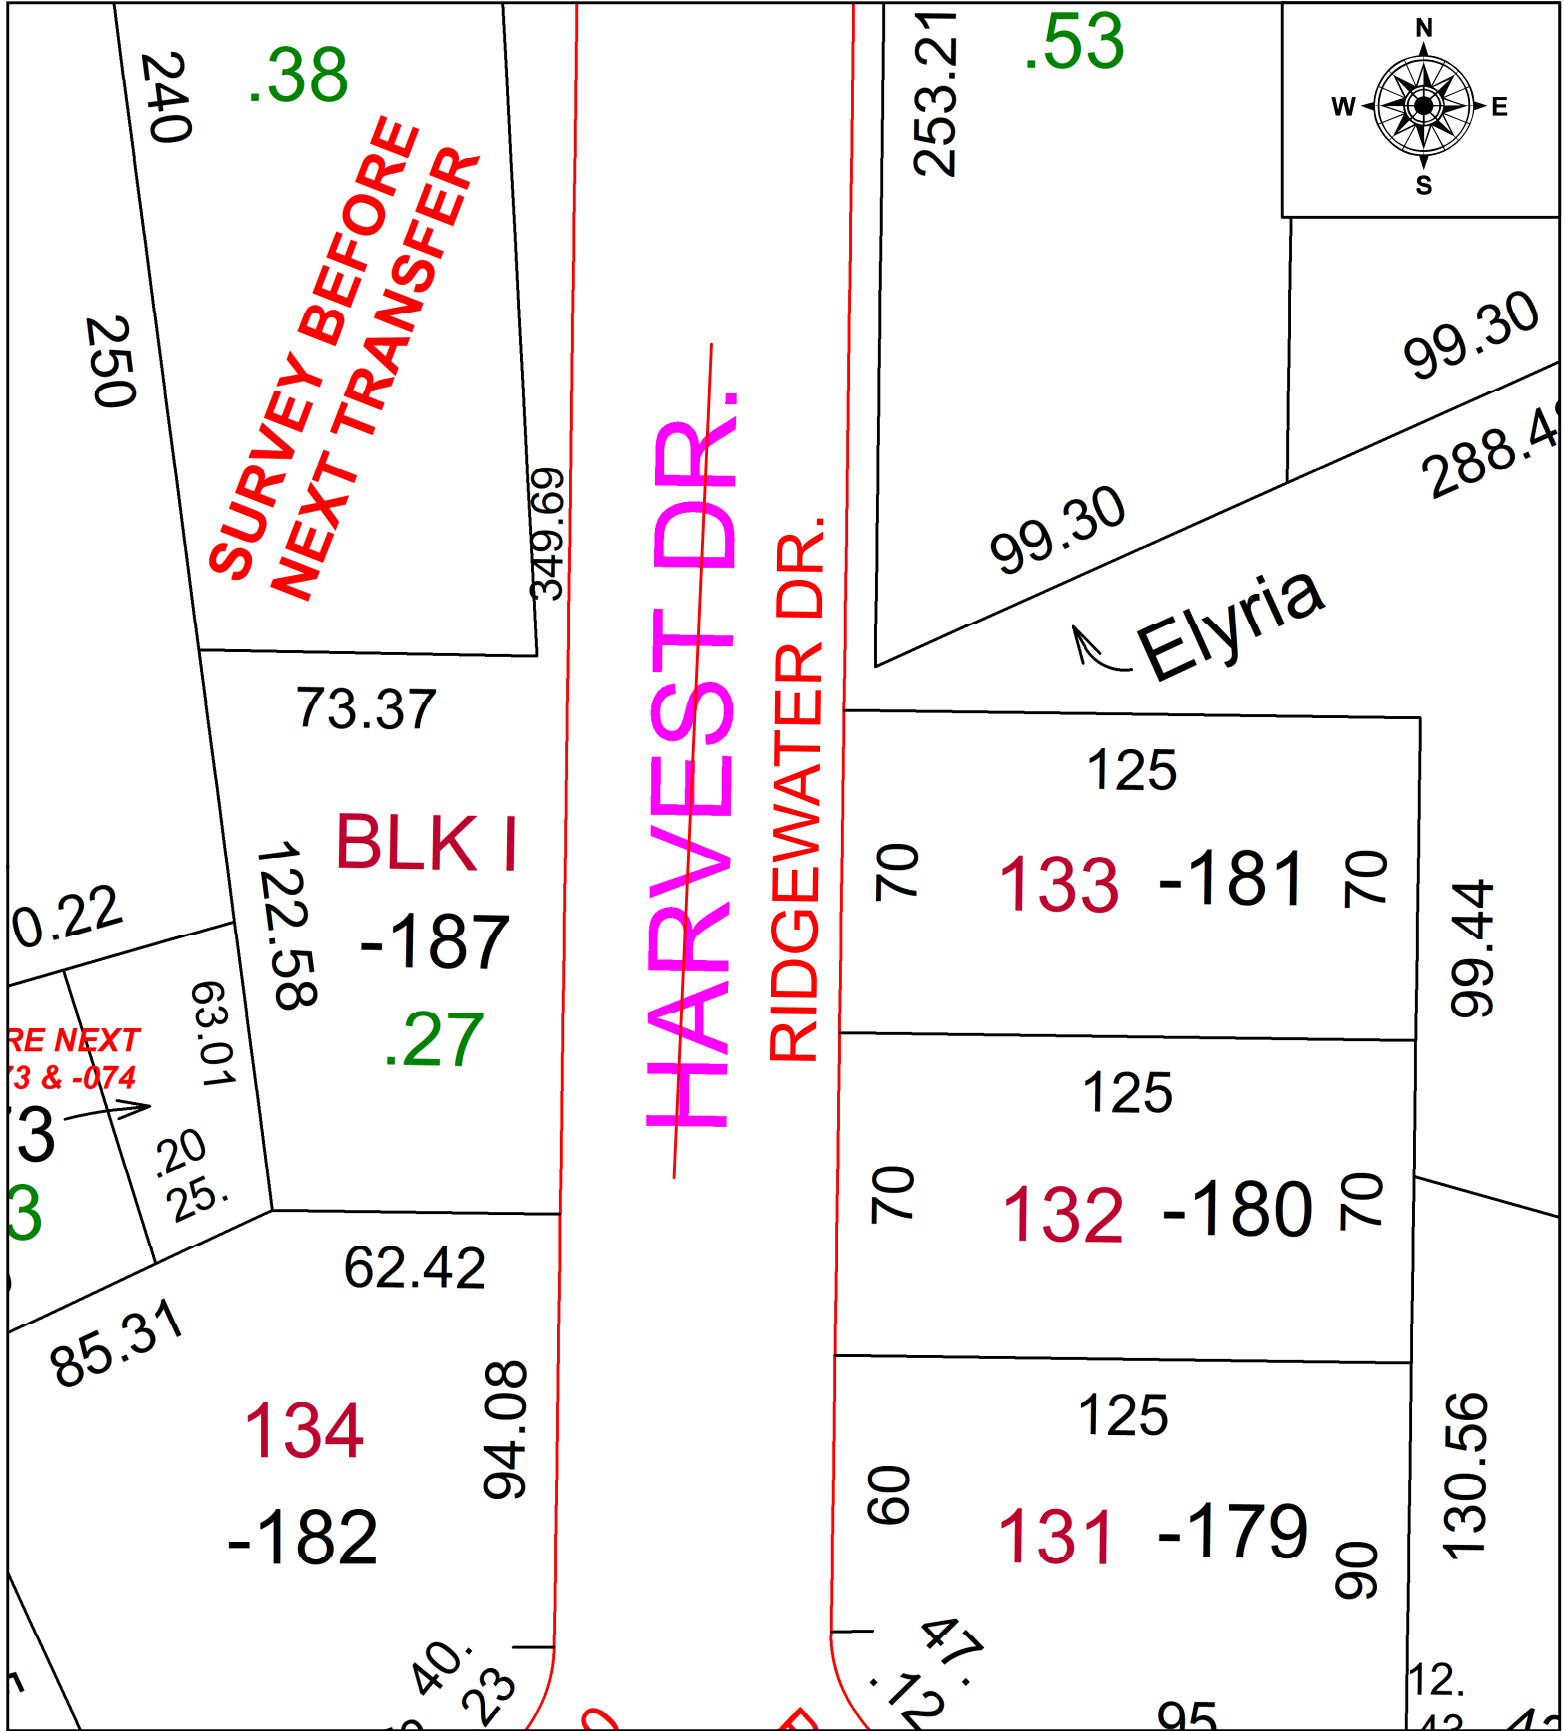

RE NEXT
3 & -074
3
3

**SURVEY BEFORE
NEXT TRANSFER**

HARVEST DR.
RIDGEWATER DR.


BLK I
-187

134
-182

133 - 181

132 - 180

131 - 179

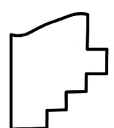

SPLITS/DEEDS PROCESSED
LORAIN COUNTY TAX MAP DEPARTMENT
226 MIDDLE AVE. ELYRIA, OH

SURVEYED BY: N/A	SURVEY #: N/A
CLOSURE: N/A	
MAP PAGE(S): 06-24-017	
APPROVED BY: DMA	DATE: 11/17/2023
SCALE: 1" = 50'	PRIOR INSTRUMENT: 2023-0921391