


PARENT PARCEL: 07-00-004-109-002

CHILD PARCEL: **AC CORR PER SURV BY WILFREDO BARBOSA**

STARTING POINT: C/L OF CHESTNUT RIDGE AND LEAR NAGLE RD

23-05194-C

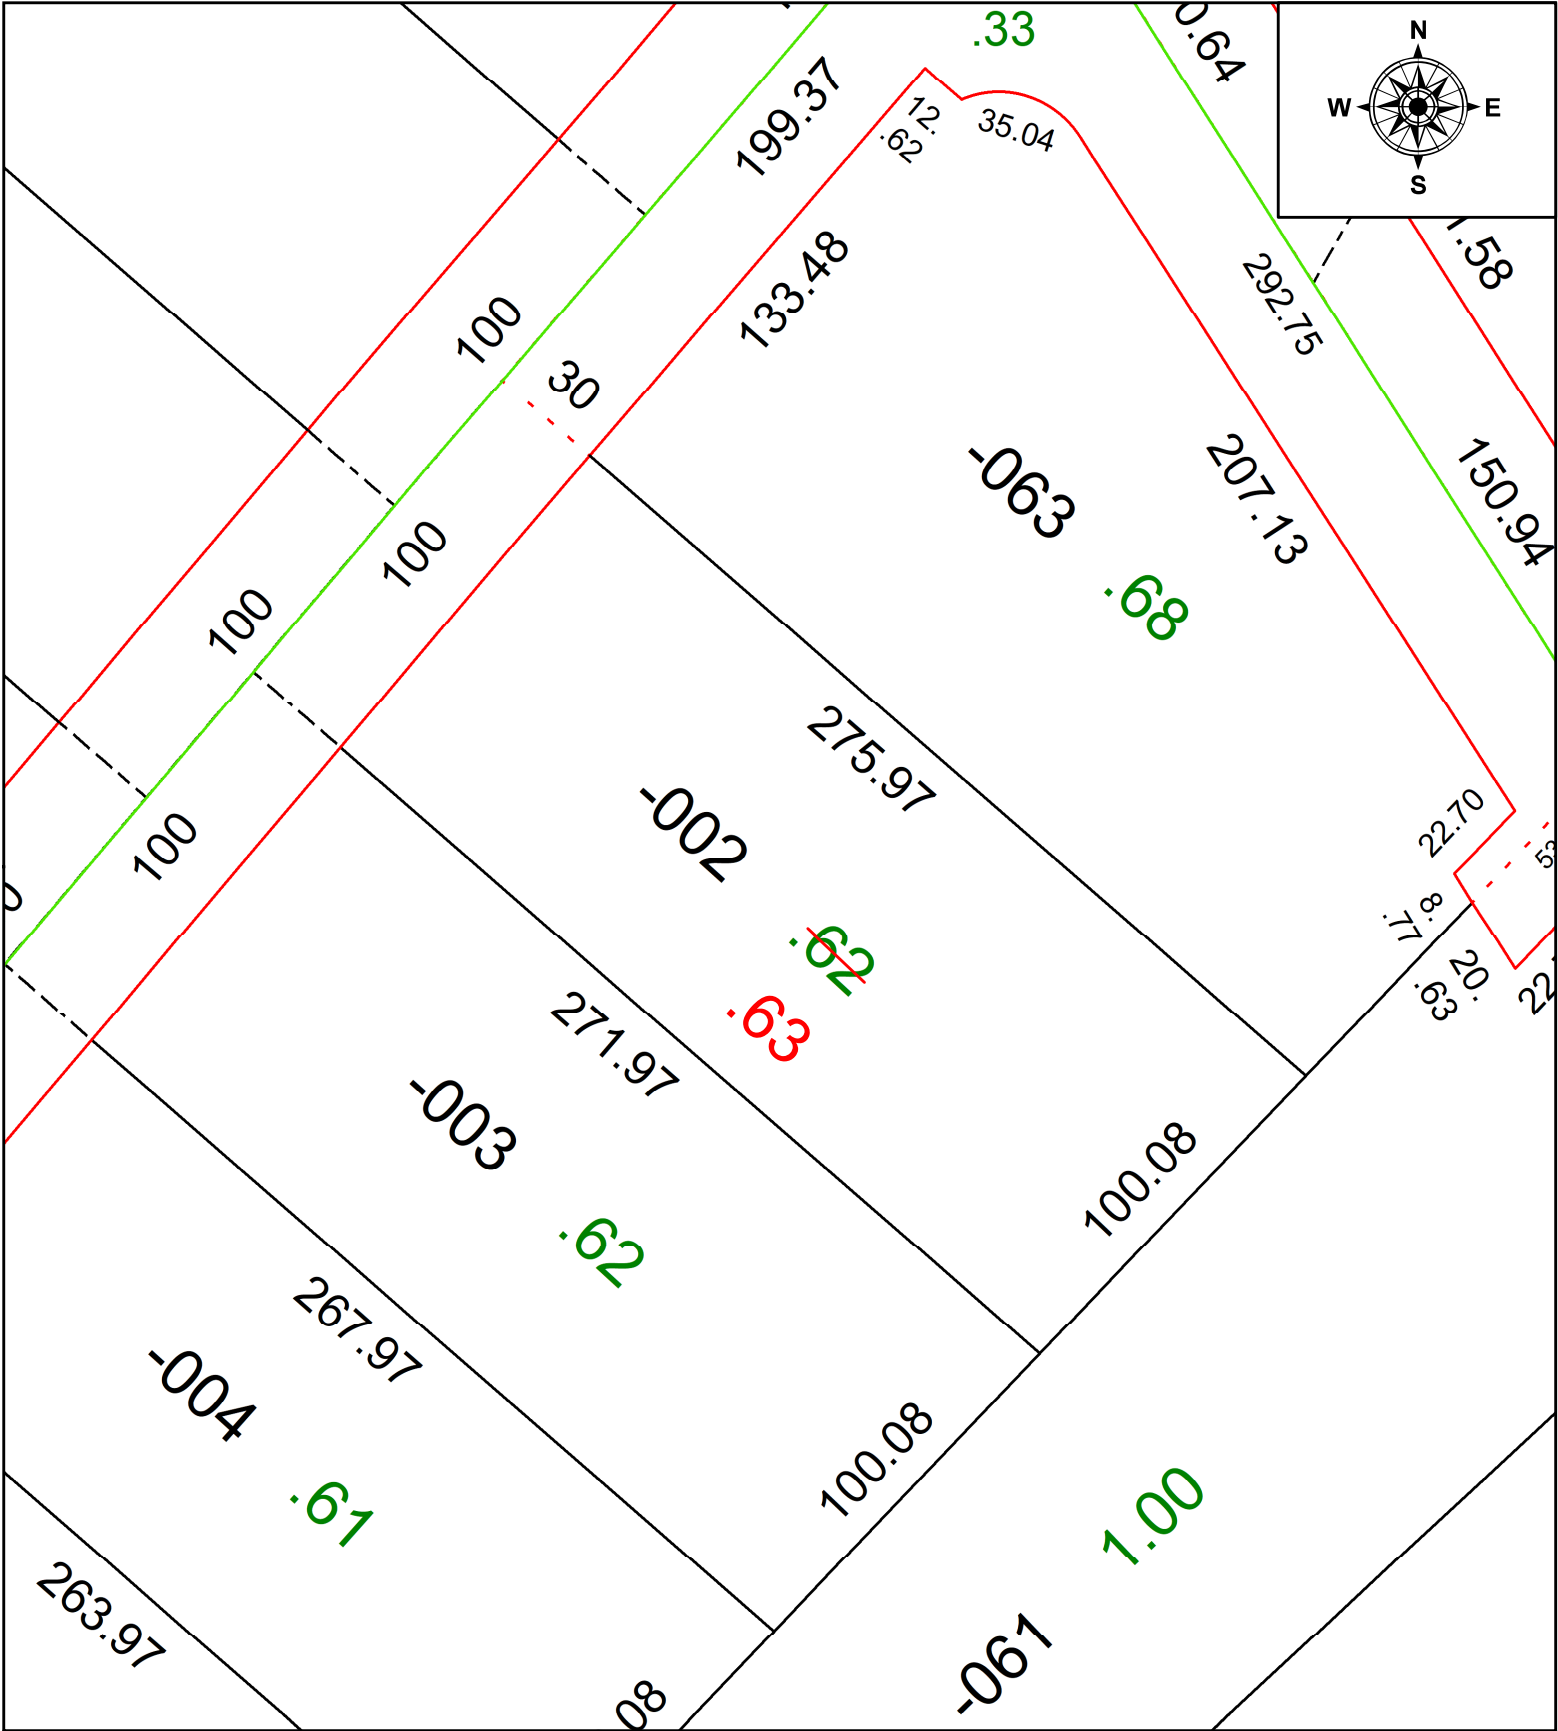

**SPLITS/DEEDS PROCESSED**  
LORAIN COUNTY TAX MAP DEPARTMENT  
226 MIDDLE AVE. ELYRIA, OH

|              |                  |                   |                   |
|--------------|------------------|-------------------|-------------------|
| SURVEYED BY: | WILFREDO BARBOSA | SURV #            | 51061             |
| CLOSURE:     | 1: 405231        |                   |                   |
| MAP PAGE(S): | 07-00-004        |                   |                   |
| APPROVED BY: | AC               | DATE:             | November 20, 2023 |
| SCALE:       | 1 in = 50 ft     | PRIOR INSTRUMENT: | 2023- 0934124     |