


PARENT PARCEL: 06-25-003-103-058

CHILD PARCEL: FRONT & DEPTH TO AC CORR PER SURV BY THOMAS A. SIMON

23-05196-C

STARTING POINT: C/L OF E RIVER RD AND S LINE OF O/L 3

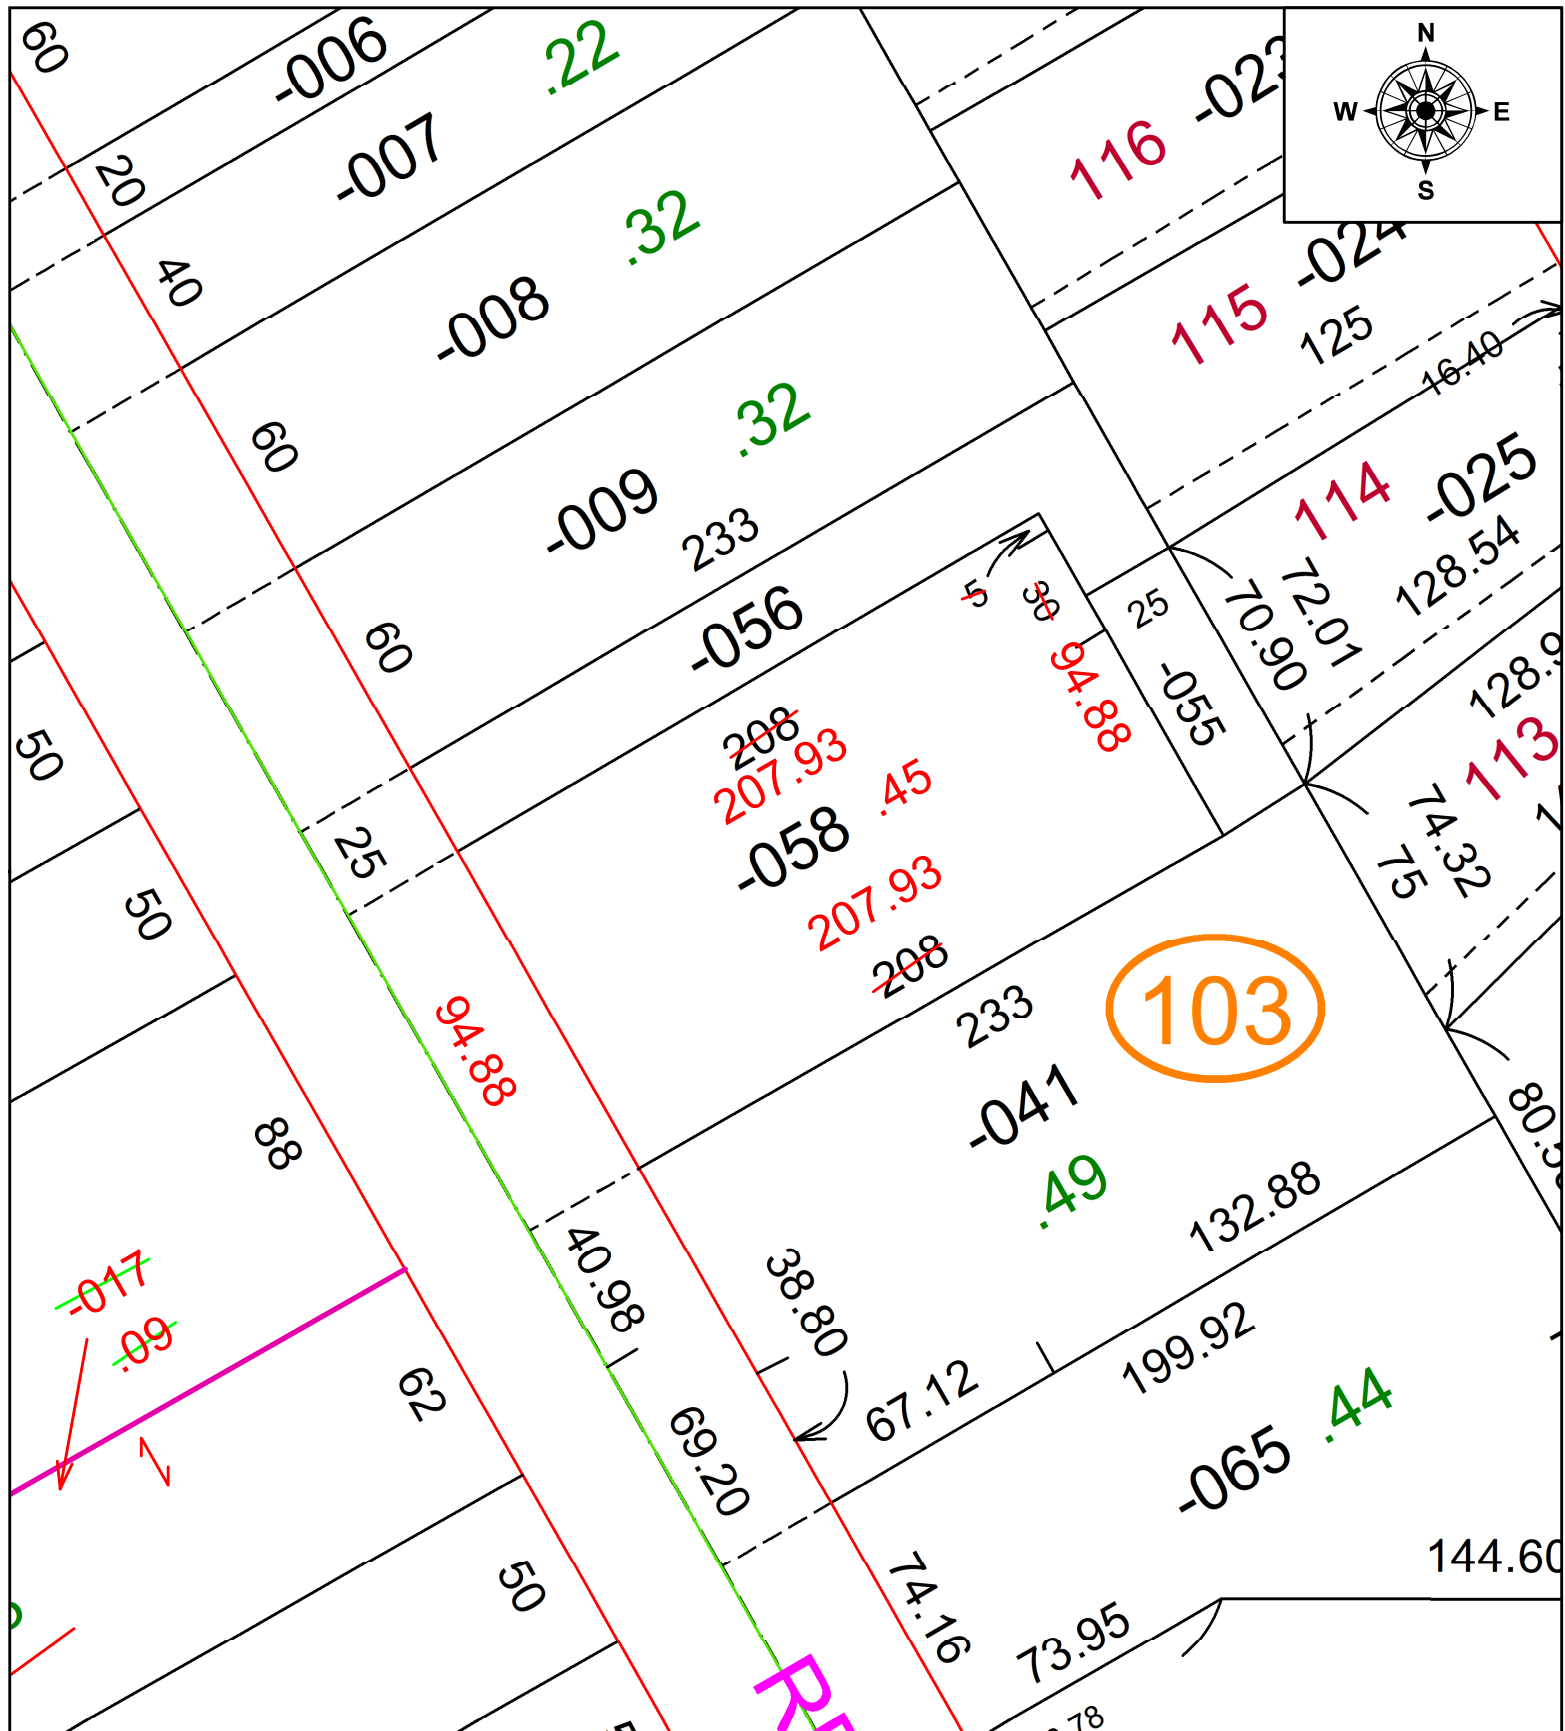

SPLITS/DEEDS PROCESSED
 LORAIN COUNTY TAX MAP DEPARTMENT
 226 MIDDLE AVE. ELYRIA, OH

SURVEYED BY:	THOMAS A. SIMON	SURV # 51063
CLOSURE:	1: 2147483648	
MAP PAGE(S):	06-25-003	
APPROVED BY:	AC	DATE: November 20, 2023
SCALE:	1 in = 50 ft	PRIOR INSTRUMENT: 2020- 0743839