


PARENT PARCEL: 09-00-086-106-005

CHILD PARCEL: AC. TO FRONTAGE & DEPTH CORR. PER PRIOR INSTR. # 1991-0136090

STARTING POINT: N/A

23-05199-C

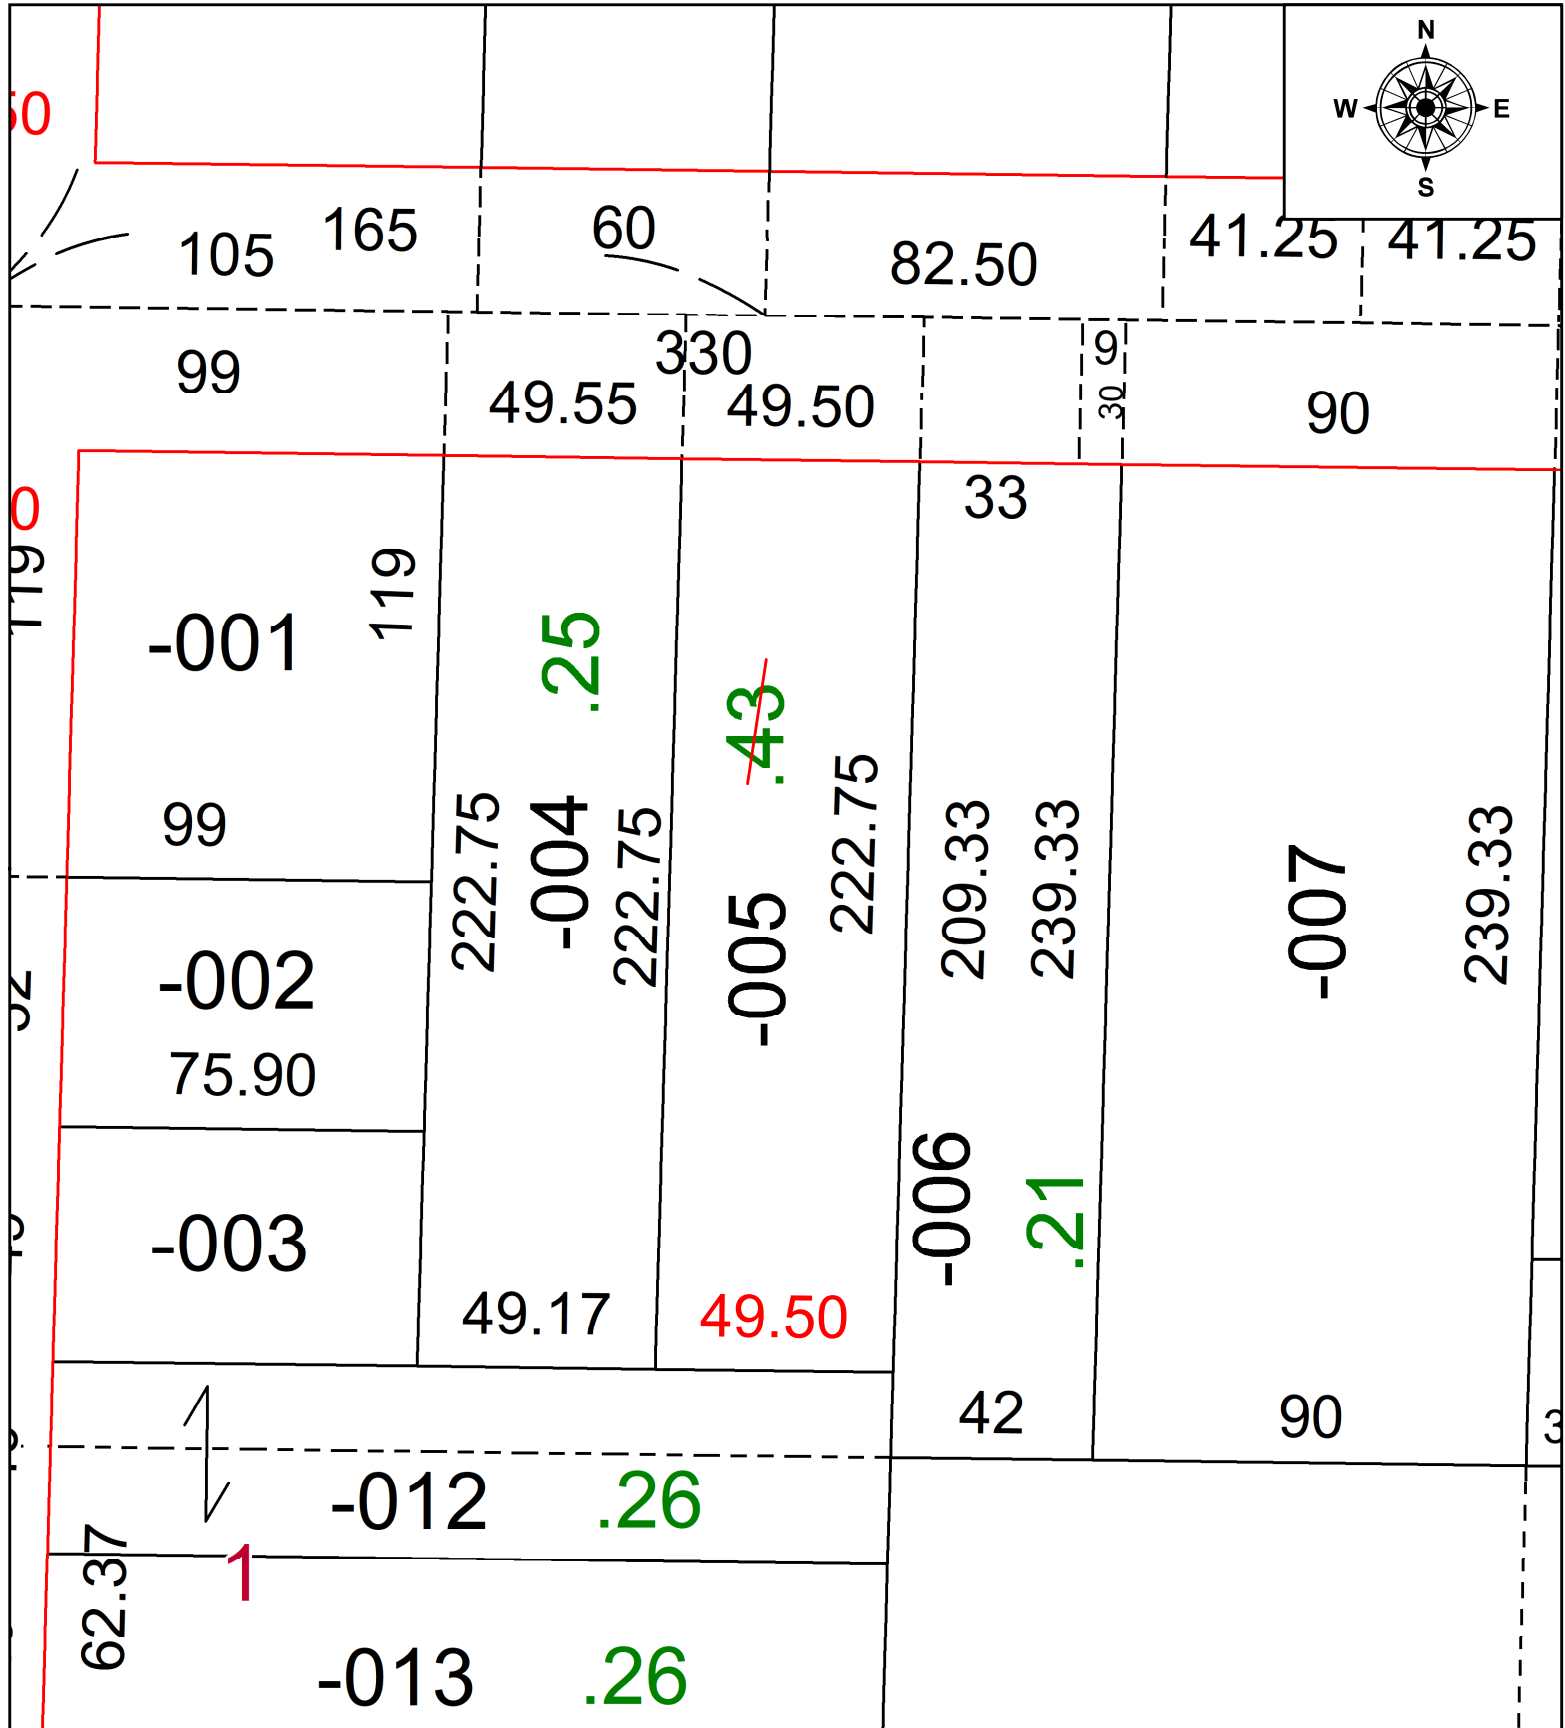

SPLITS/DEEDS PROCESSED
 LORAIN COUNTY TAX MAP DEPARTMENT
 226 MIDDLE AVE. ELYRIA, OH

SURVEYED BY: N/A SURVEY #: N/A
 CLOSURE: N/A
 MAP PAGE(S): 09-00-086
 APPROVED BY: DMA DATE: 11/21/2023
 SCALE: 1" = 40' PRIOR INSTRUMENT: 1991-0136090