


PARENT PARCEL: 09-00-084-107-007 & -037

CHILD PARCEL: MAP CORRECTION ONLY

STARTING POINT: C/L OF W COLLEGE ST AND PROSPECT ST

23-05204-C

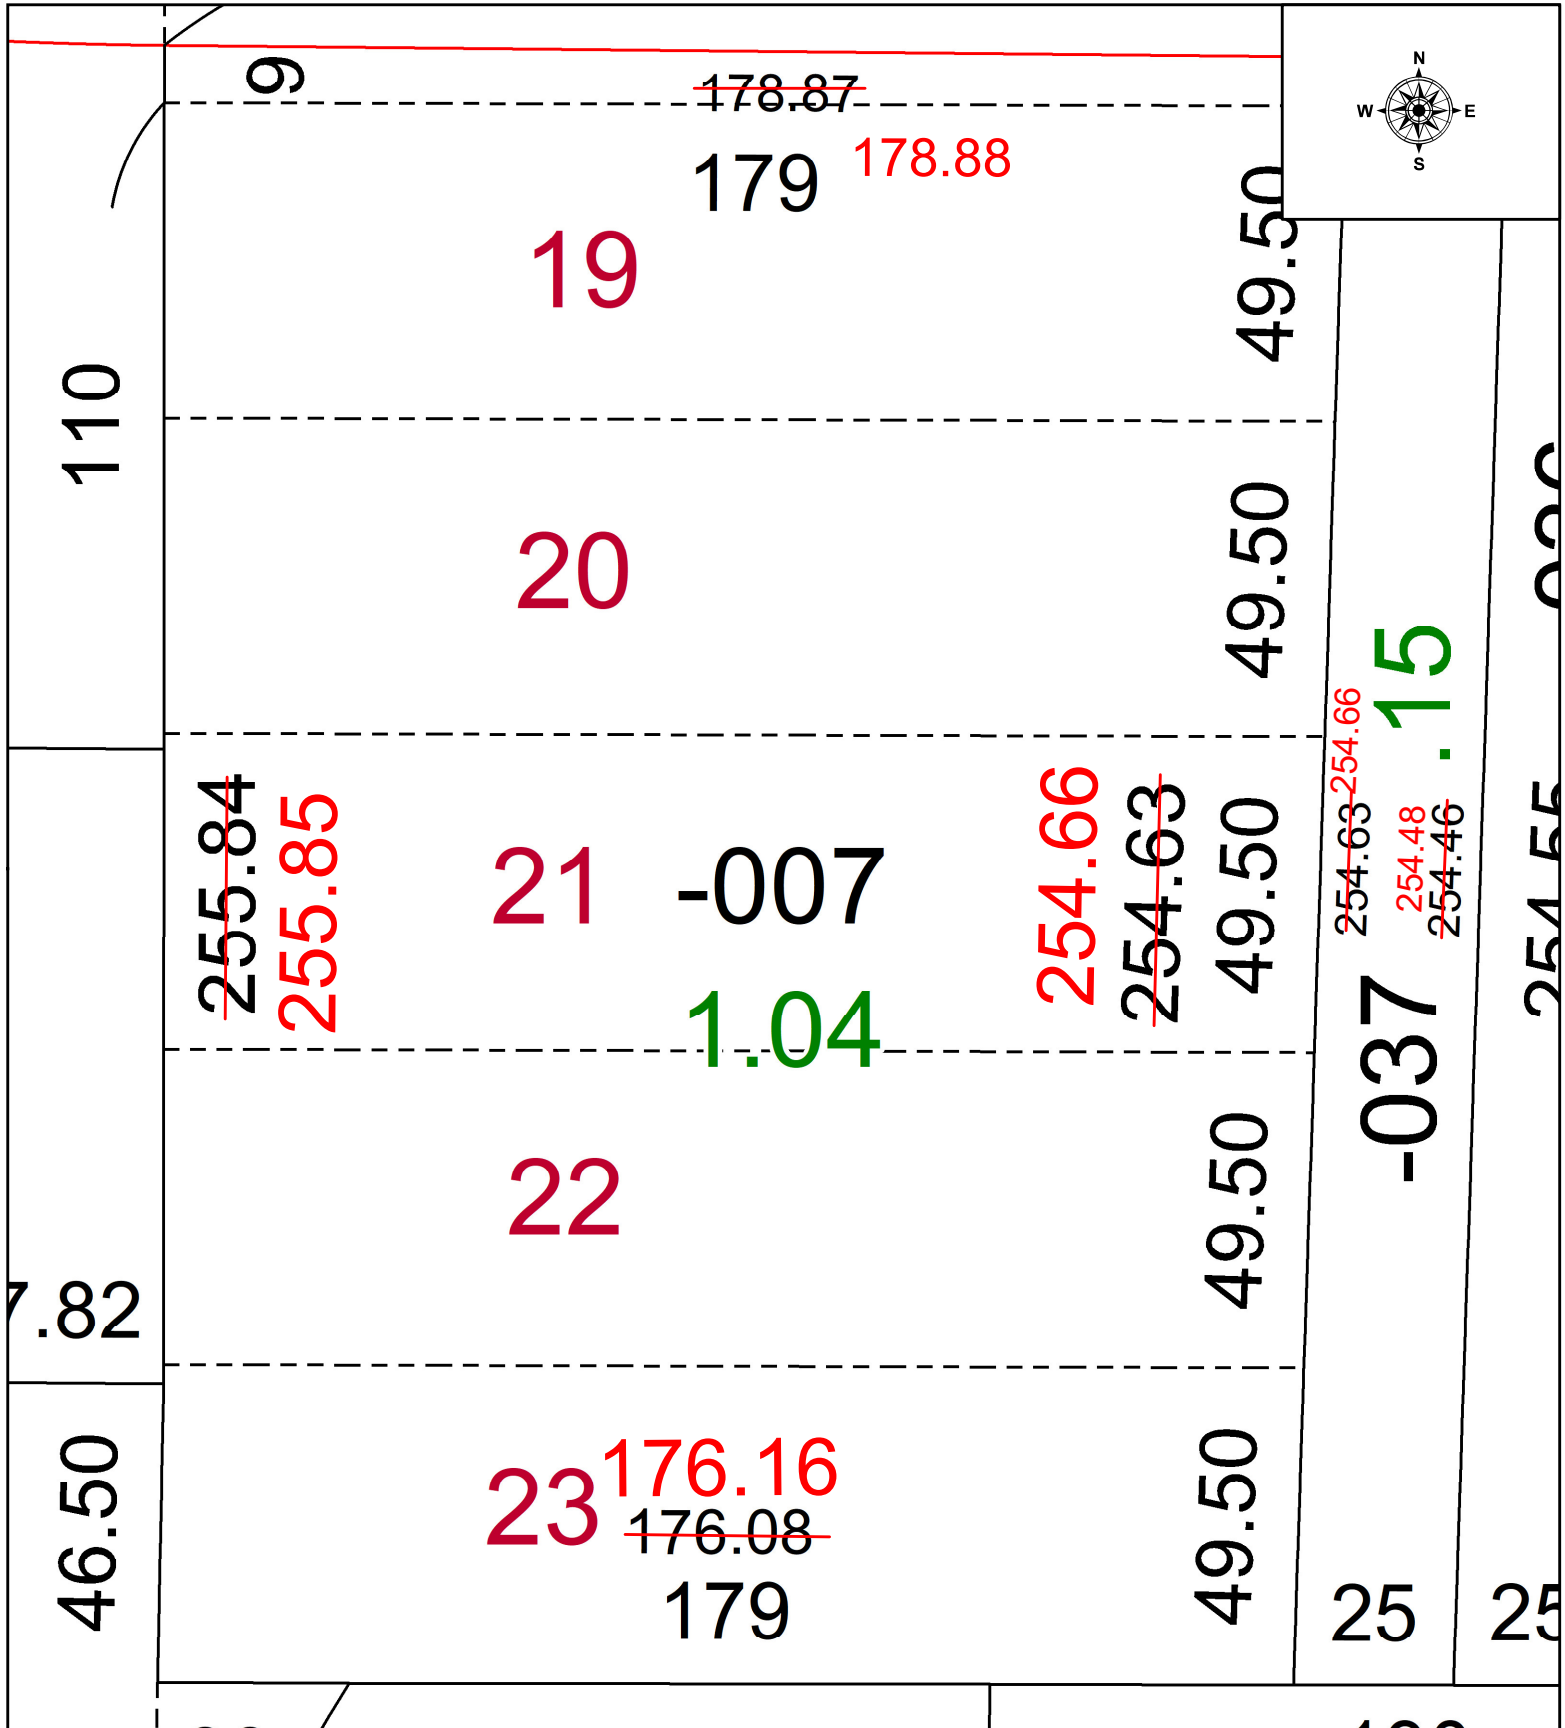

SPLITS/DEEDS PROCESSED
 LORAIN COUNTY TAX MAP DEPARTMENT
 226 MIDDLE AVE. ELYRIA, OH

SURVEYED BY: RICHARD FREDRICKSON SURVEY # 51075
 CLOSURE: 1: 100789
 MAP PAGE(S): 09-00-084
 APPROVED BY: WRZ DATE: 12/4/2023
 SCALE: 1" = 30 PRIOR INSTRUMENT: #2023-0937406