
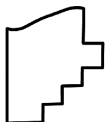
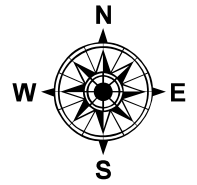


PARENT PARCEL: 06-25-145-000-005

CHILD PARCEL: FRONT & DEPTH TO AC CORR PER SURV BY THOMAS A. SIMON

23-05207-C

STARTING POINT: C/L OF GLENWOOD ST AND HARRISON ST

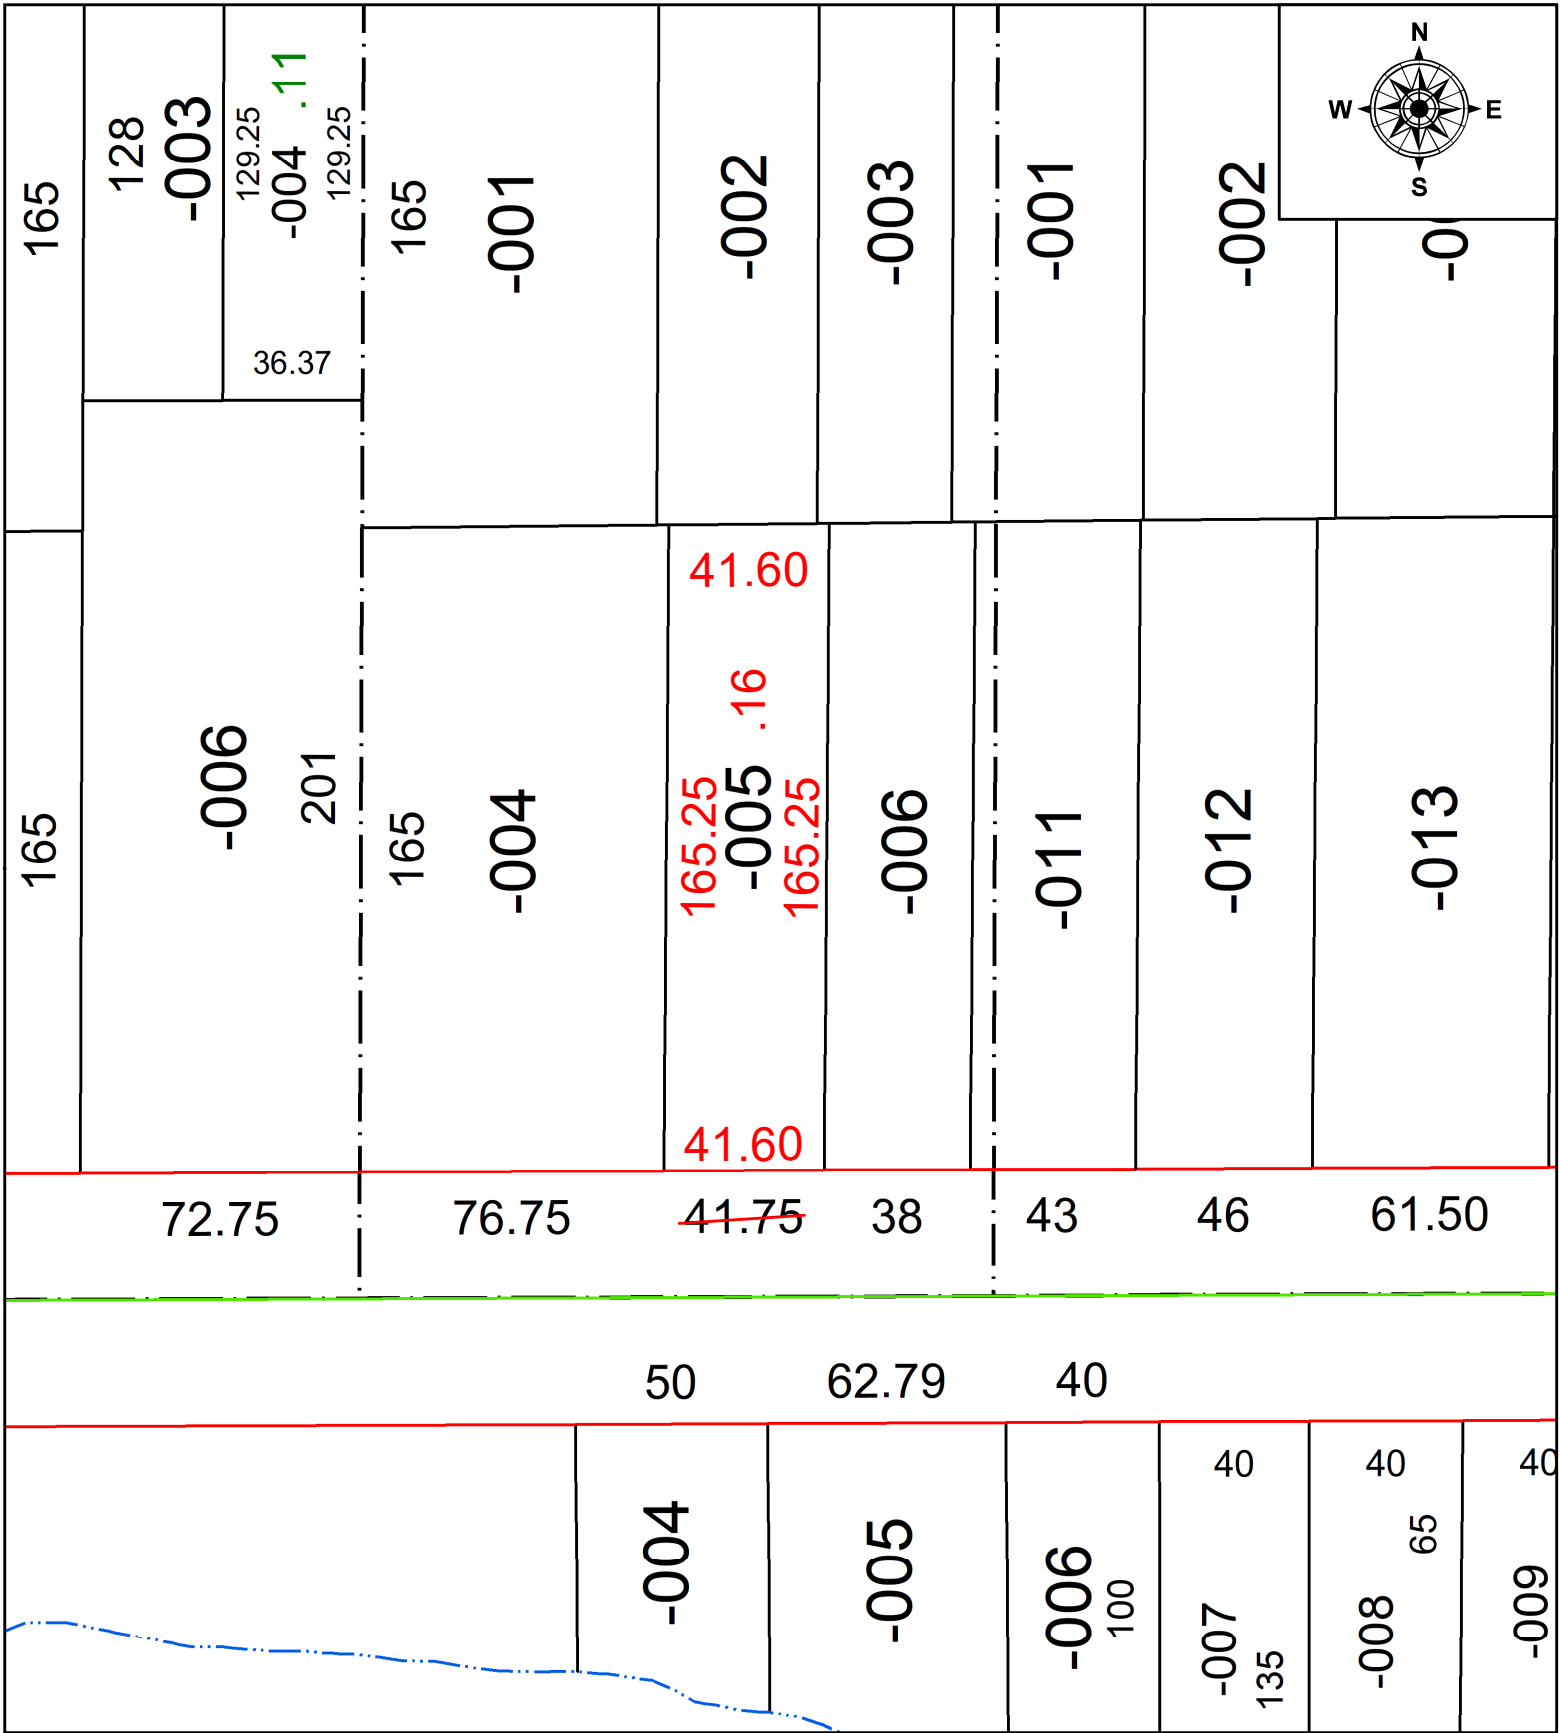

SPLITS/DEEDS PROCESSED
 LORAIN COUNTY TAX MAP DEPARTMENT
 226 MIDDLE AVE. ELYRIA, OH

SURVEYED BY: THOMAS A. SIMON SURV # 51078
 CLOSURE: 1: 2147483648
 MAP PAGE(S): 06-25-145
 APPROVED BY: AC DATE: December 07, 2023
 SCALE: 1 in = 50 ft PRIOR INSTRUMENT: 2001- 0771337