


PARENT PARCEL: 02-02-006-103-026

CHILD PARCEL: FRONT & DEPTH TO AC CORR PER SURV BY THOMAS A. SIMON

23-05213-C

STARTING POINT: SW CORNER OF S/L 53 AND N LINE OF TOWER BLV

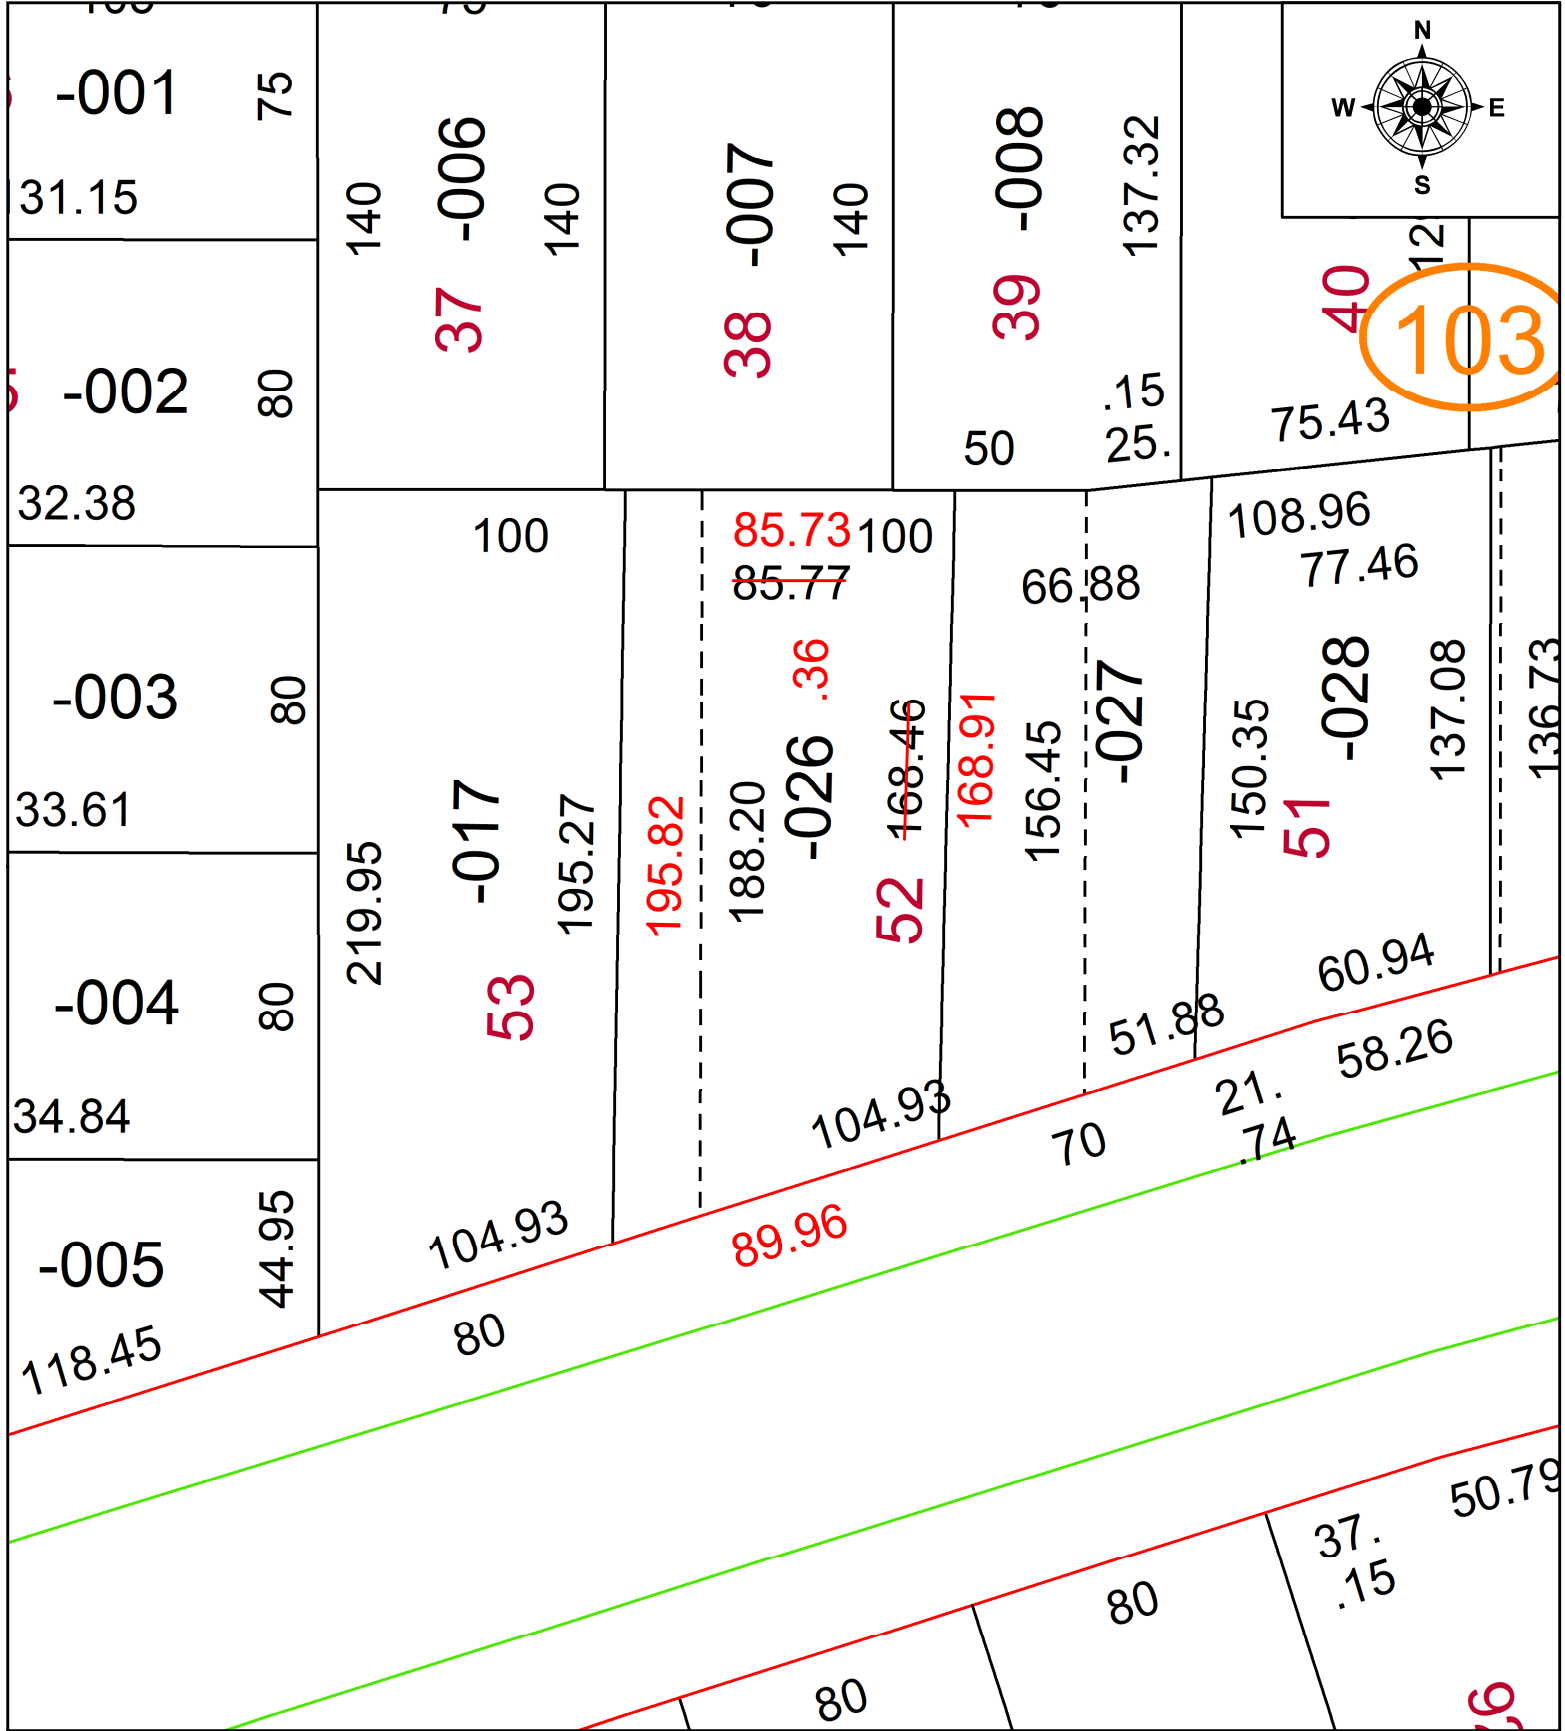

SPLITS/DEEDS PROCESSED
 LORAIN COUNTY TAX MAP DEPARTMENT
 226 MIDDLE AVE. ELYRIA, OH

SURVEYED BY: THOMAS A. SIMON SURV # 51083
 CLOSURE: 1: 68398
 MAP PAGE(S): 02-02-006
 APPROVED BY: AC DATE: December 12, 2023
 SCALE: 1 in = 50 ft PRIOR INSTRUMENT: 2023- 0922380