
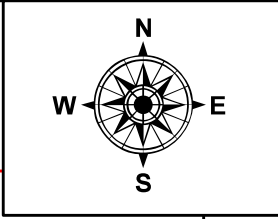


PARENT PARCEL: 05-00-023-119-003

CHILD PARCEL: FRONT & DEPTH TO AC CORR PER SURV BY KYLE R. DANALS

STARTING POINT: N LINE OF PARK AVE AND SE CORNER OF S/L 94

23-05216-C

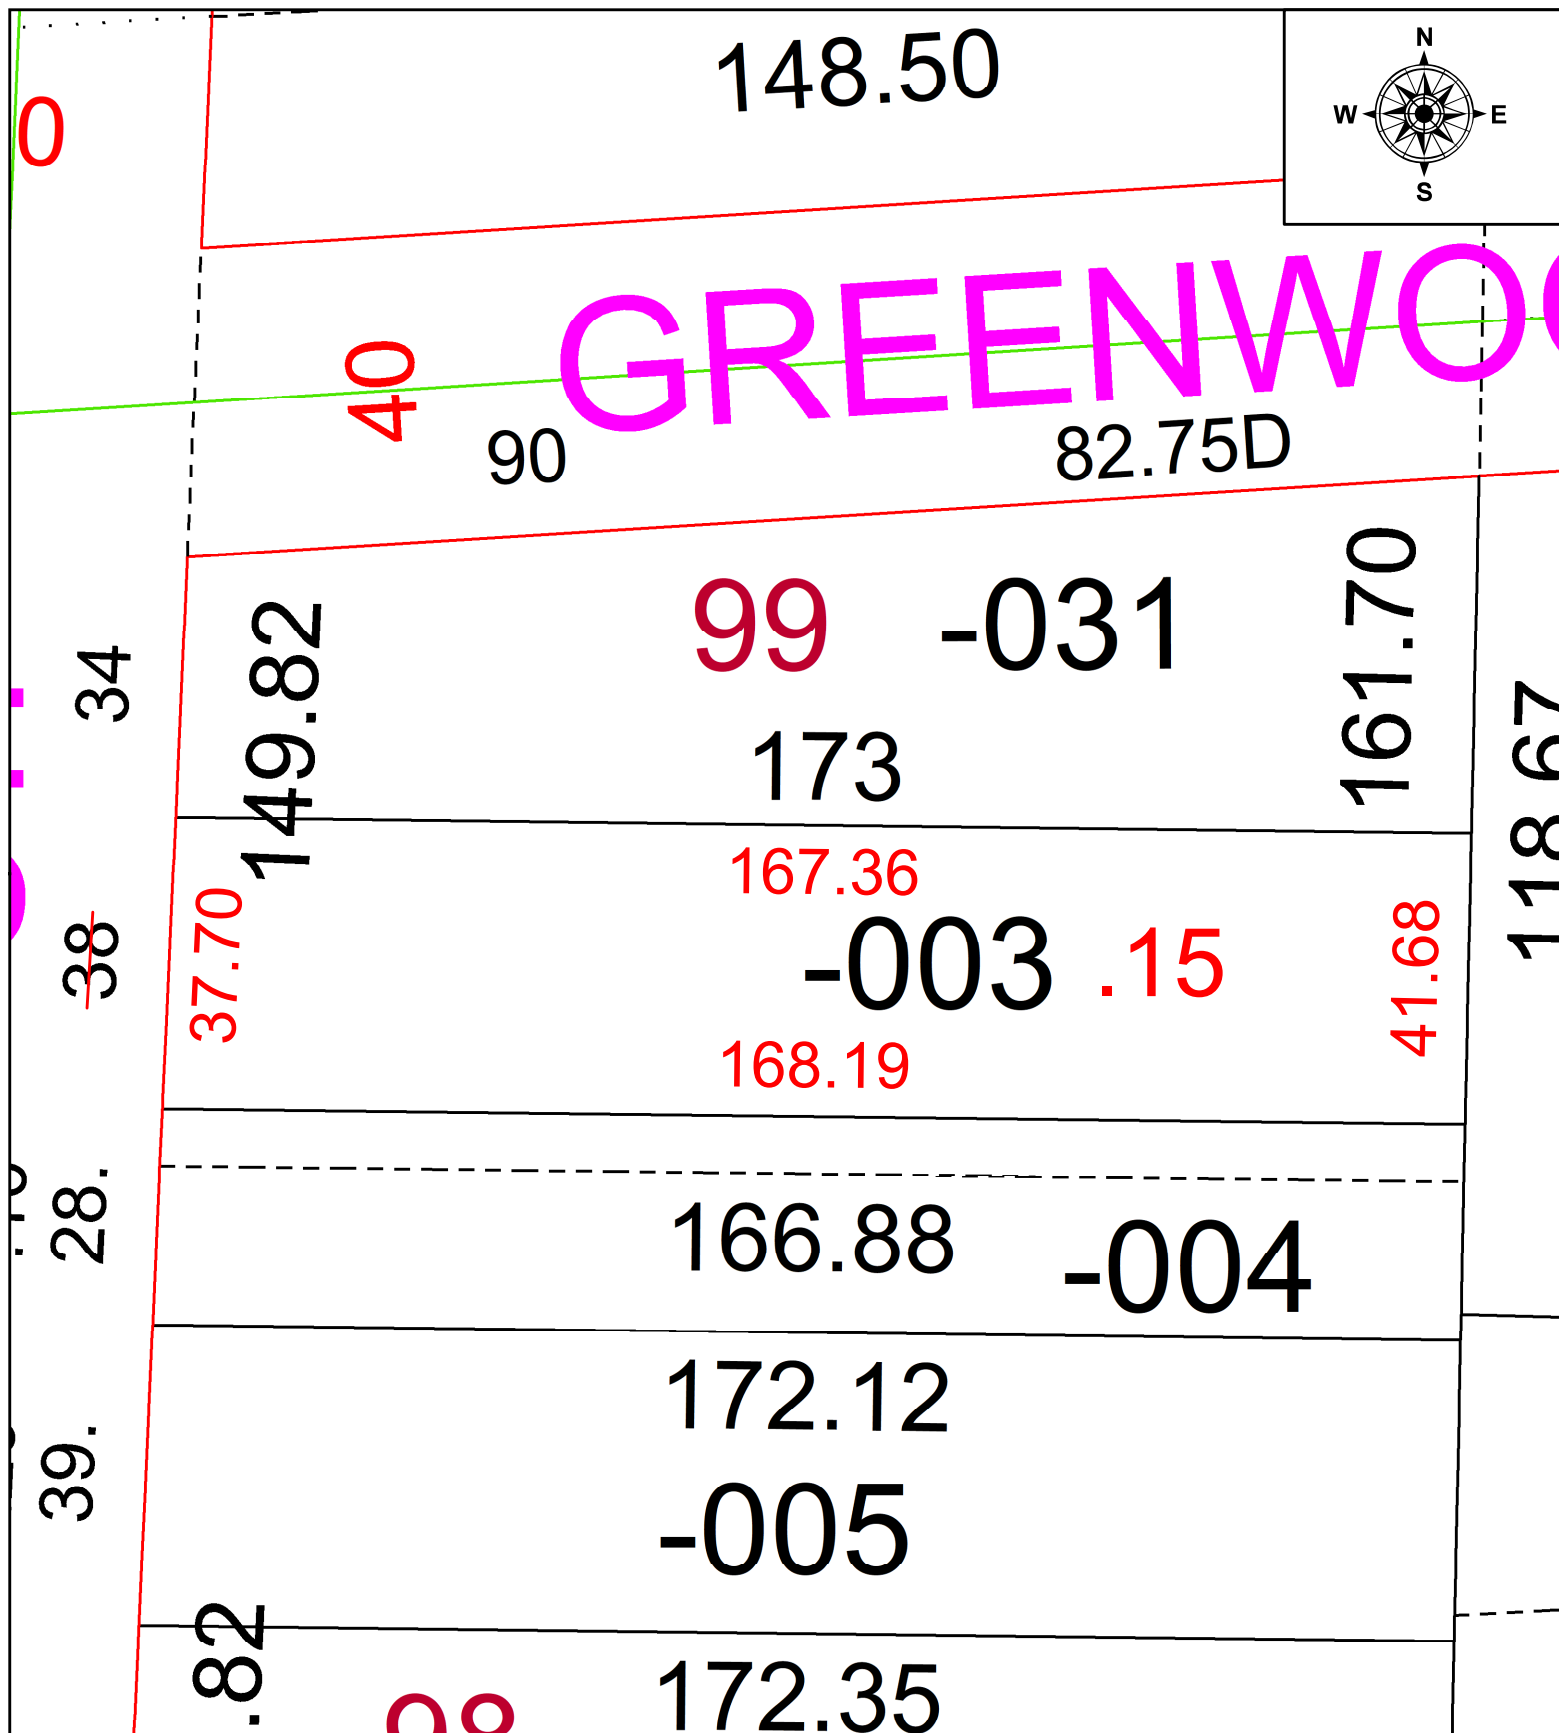

**SPLITS/DEEDS PROCESSED**  
 LORAIN COUNTY TAX MAP DEPARTMENT  
 226 MIDDLE AVE. ELYRIA, OH

SURVEYED BY: KYLE R. DANALS SURV # 51094  
 CLOSURE: 1: 110414  
 MAP PAGE(S): 05-00-023  
 APPROVED BY: AC DATE: December 22, 2023  
 SCALE: 1 in = 25 ft PRIOR INSTRUMENT: 2023- 0934708