
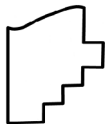


PARENT PARCEL: ADD TO DUPLICATE

CHILD PARCEL: 05-00-023-107-032 0.04 A. (PER DV. 627 PG. 277)

STARTING POINT: N.E. CORNER OF S/L 3 IN KOLBE'S 1ST ADDITION

23-05218-A

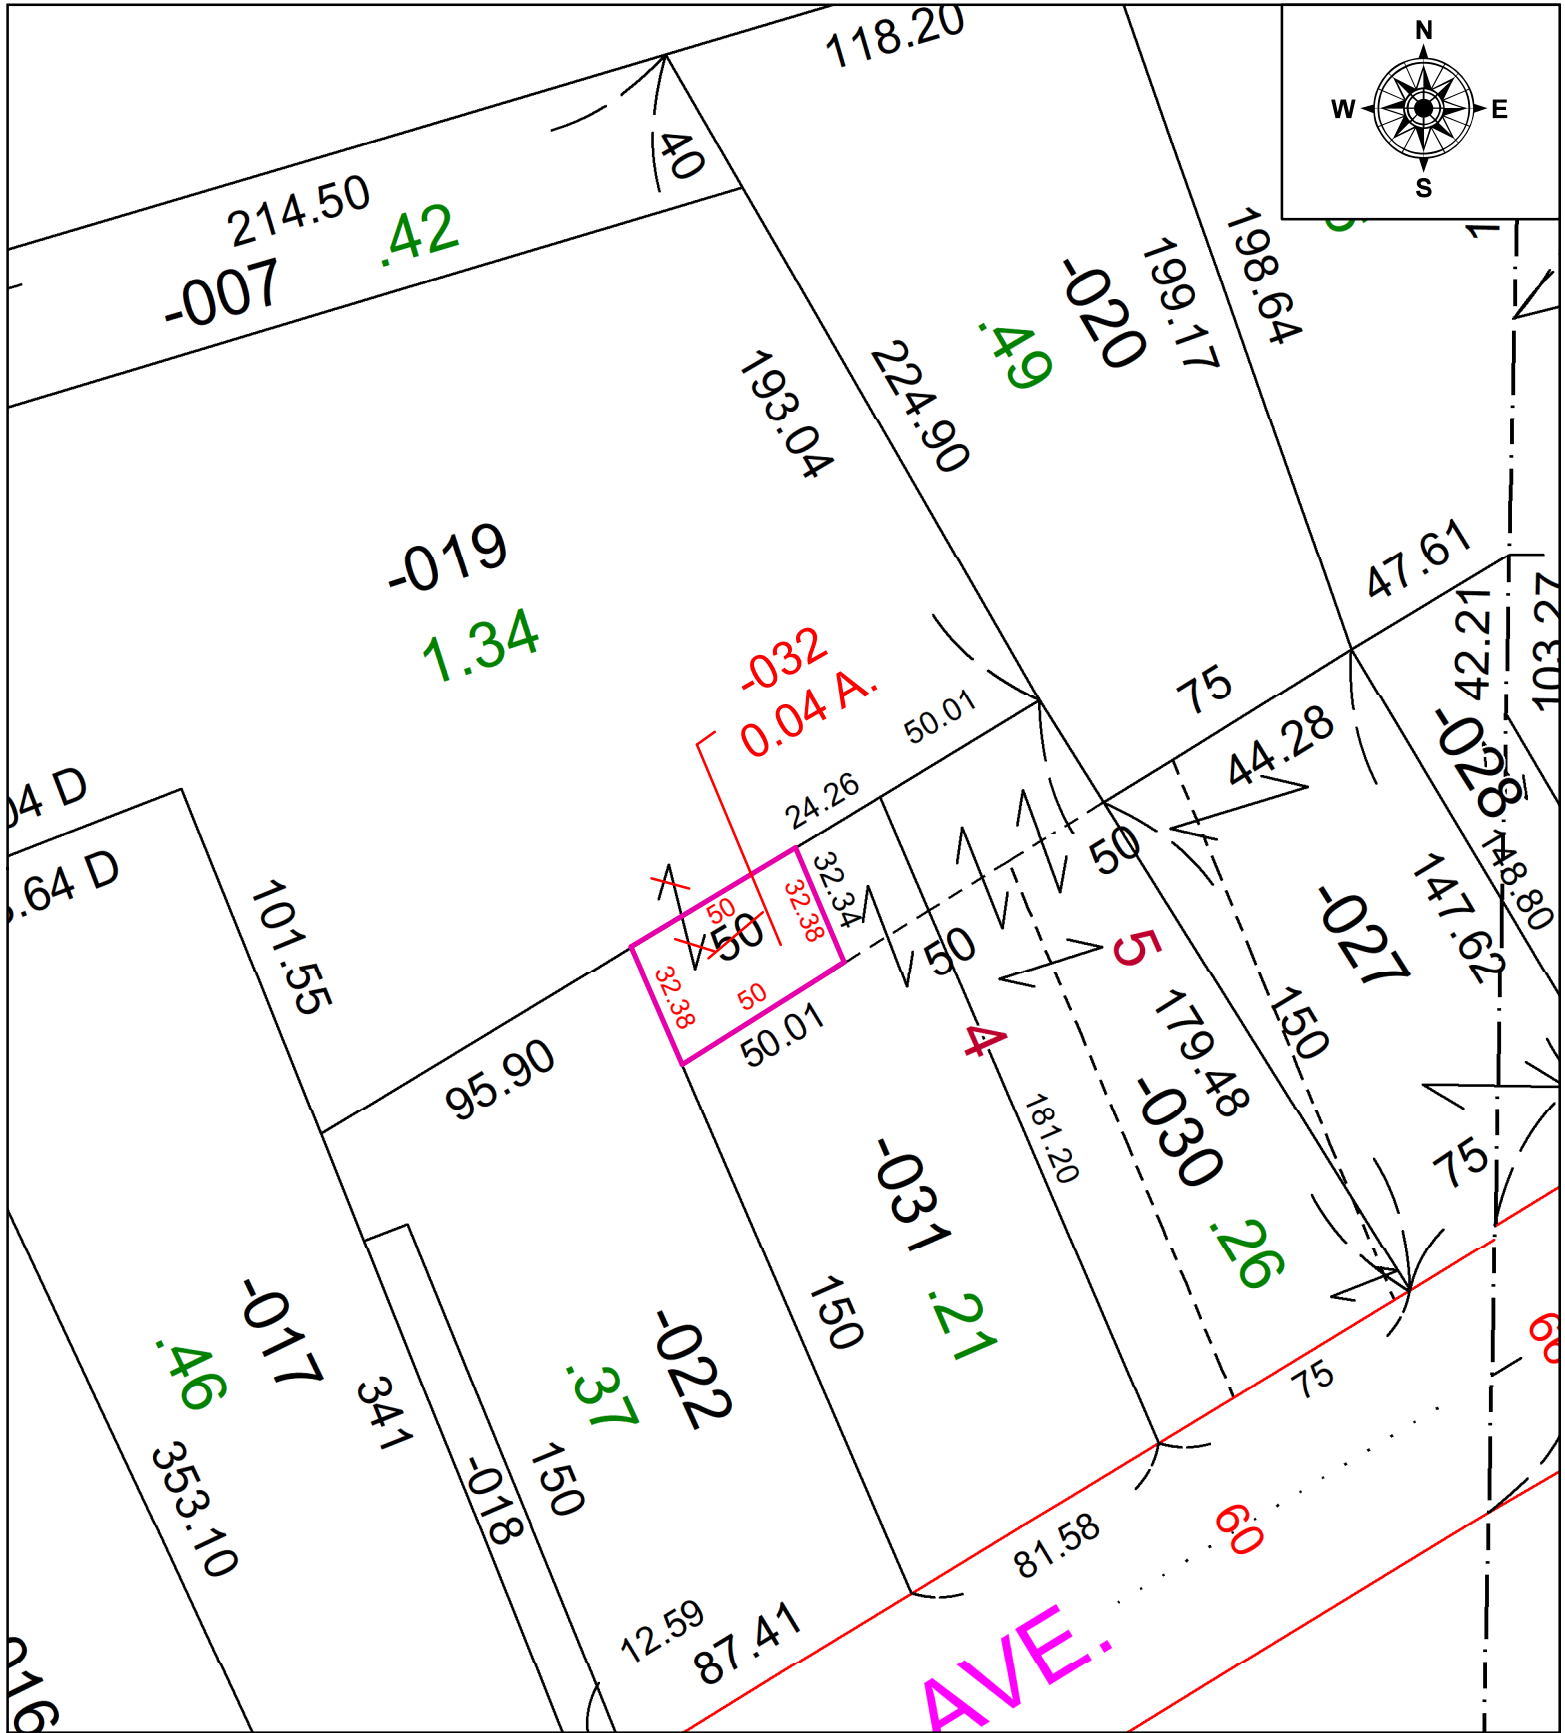

SPLITS/DEEDS PROCESSED
 LORAIN COUNTY TAX MAP DEPARTMENT
 226 MIDDLE AVE. ELYRIA, OH

SURVEYED BY: NA
 CLOSURE: 1: INF
 MAP PAGE(S): 05-00-023
 APPROVED BY: TJS DATE: 12/27/2023
 SCALE: 1" = 50' PRIOR INSTRUMENT: DV 627/277