


PARENT PARCEL: 04-00-018-133-003

CHILD PARCEL: 04-00-018-133-013 & -014 UNCOMBINATION PER PRIOR INSTRU. #2007-0208294

24-05229-U

STARTING POINT:

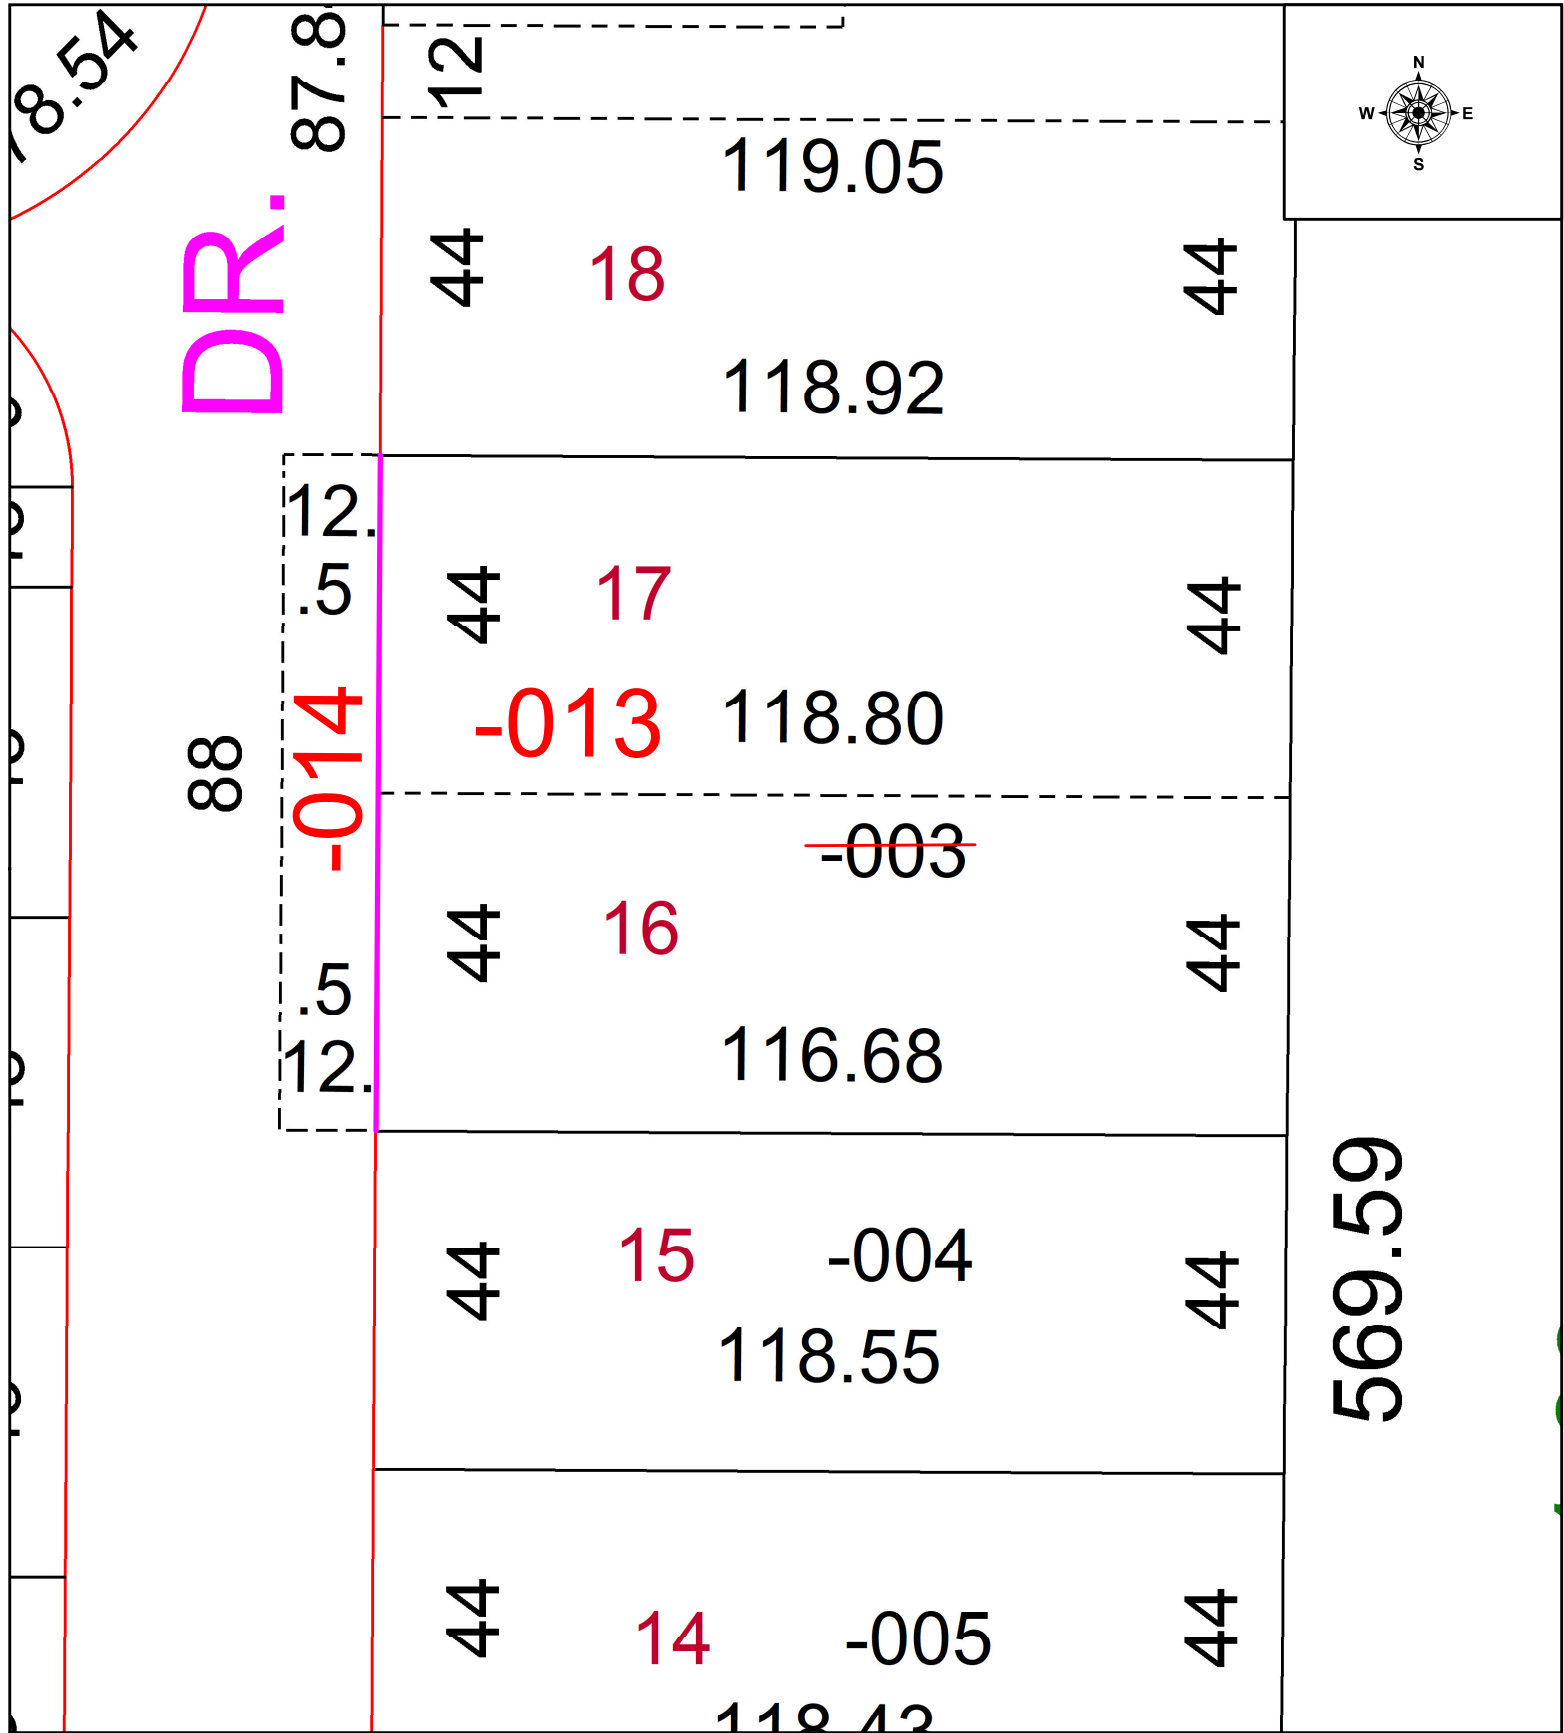

**SPLITS/DEEDS PROCESSED**  
LORAIN COUNTY TAX MAP DEPARTMENT  
226 MIDDLE AVE. ELYRIA, OH

SURVEYED BY:	N/A	SURVEY #	N/A
CLOSURE:	1:		
MAP PAGE(S):	04-00-018		
APPROVED BY:	WRZ	DATE:	1/10/2024
SCALE:	1" = 25'	PRIOR INSTRUMENT:	#2007-0208294