
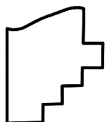


PARENT PARCEL: 18-00-040-000-012 & 18-00-045-000-014

CHILD PARCEL: **AC CORR PER SURV BY RICHARD D. CARLSON**

24-05235-A

STARTING POINT: SE CORNER OF O/L 45

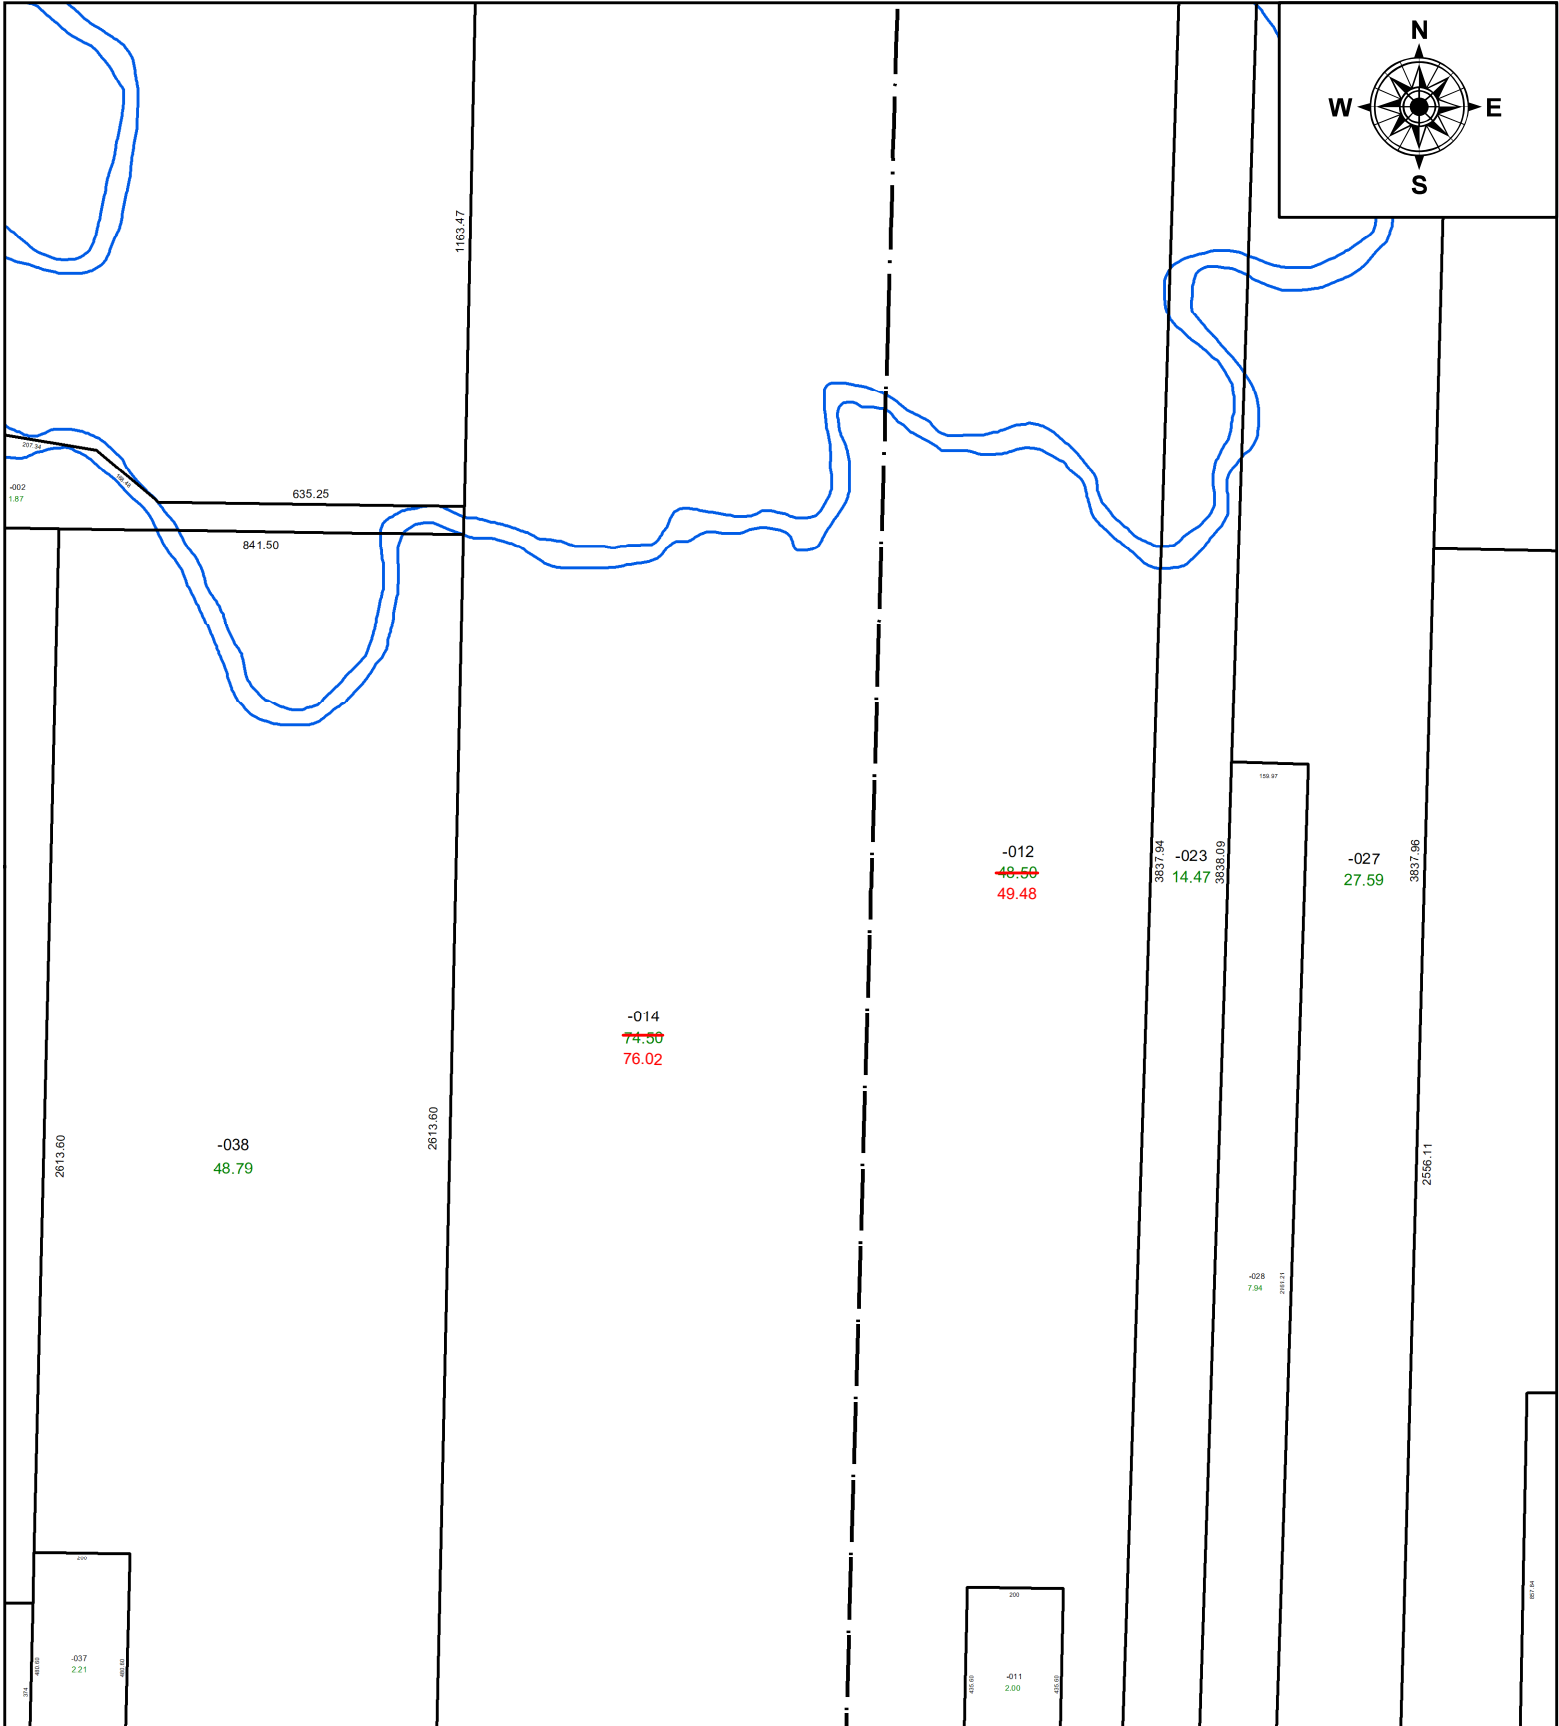

SPLITS/DEEDS PROCESSED
 LORAIN COUNTY TAX MAP DEPARTMENT
 226 MIDDLE AVE. ELYRIA, OH

SURVEYED BY: RICHARD D. CARLSON **SURV #** N/A
CLOSURE: 1: 100789
MAP PAGE(S): 18-00-040
APPROVED BY: AC **DATE:** January 26, 2024
SCALE: 1 in = 400 ft **PRIOR INSTRUMENT:** 2007- 0235447