
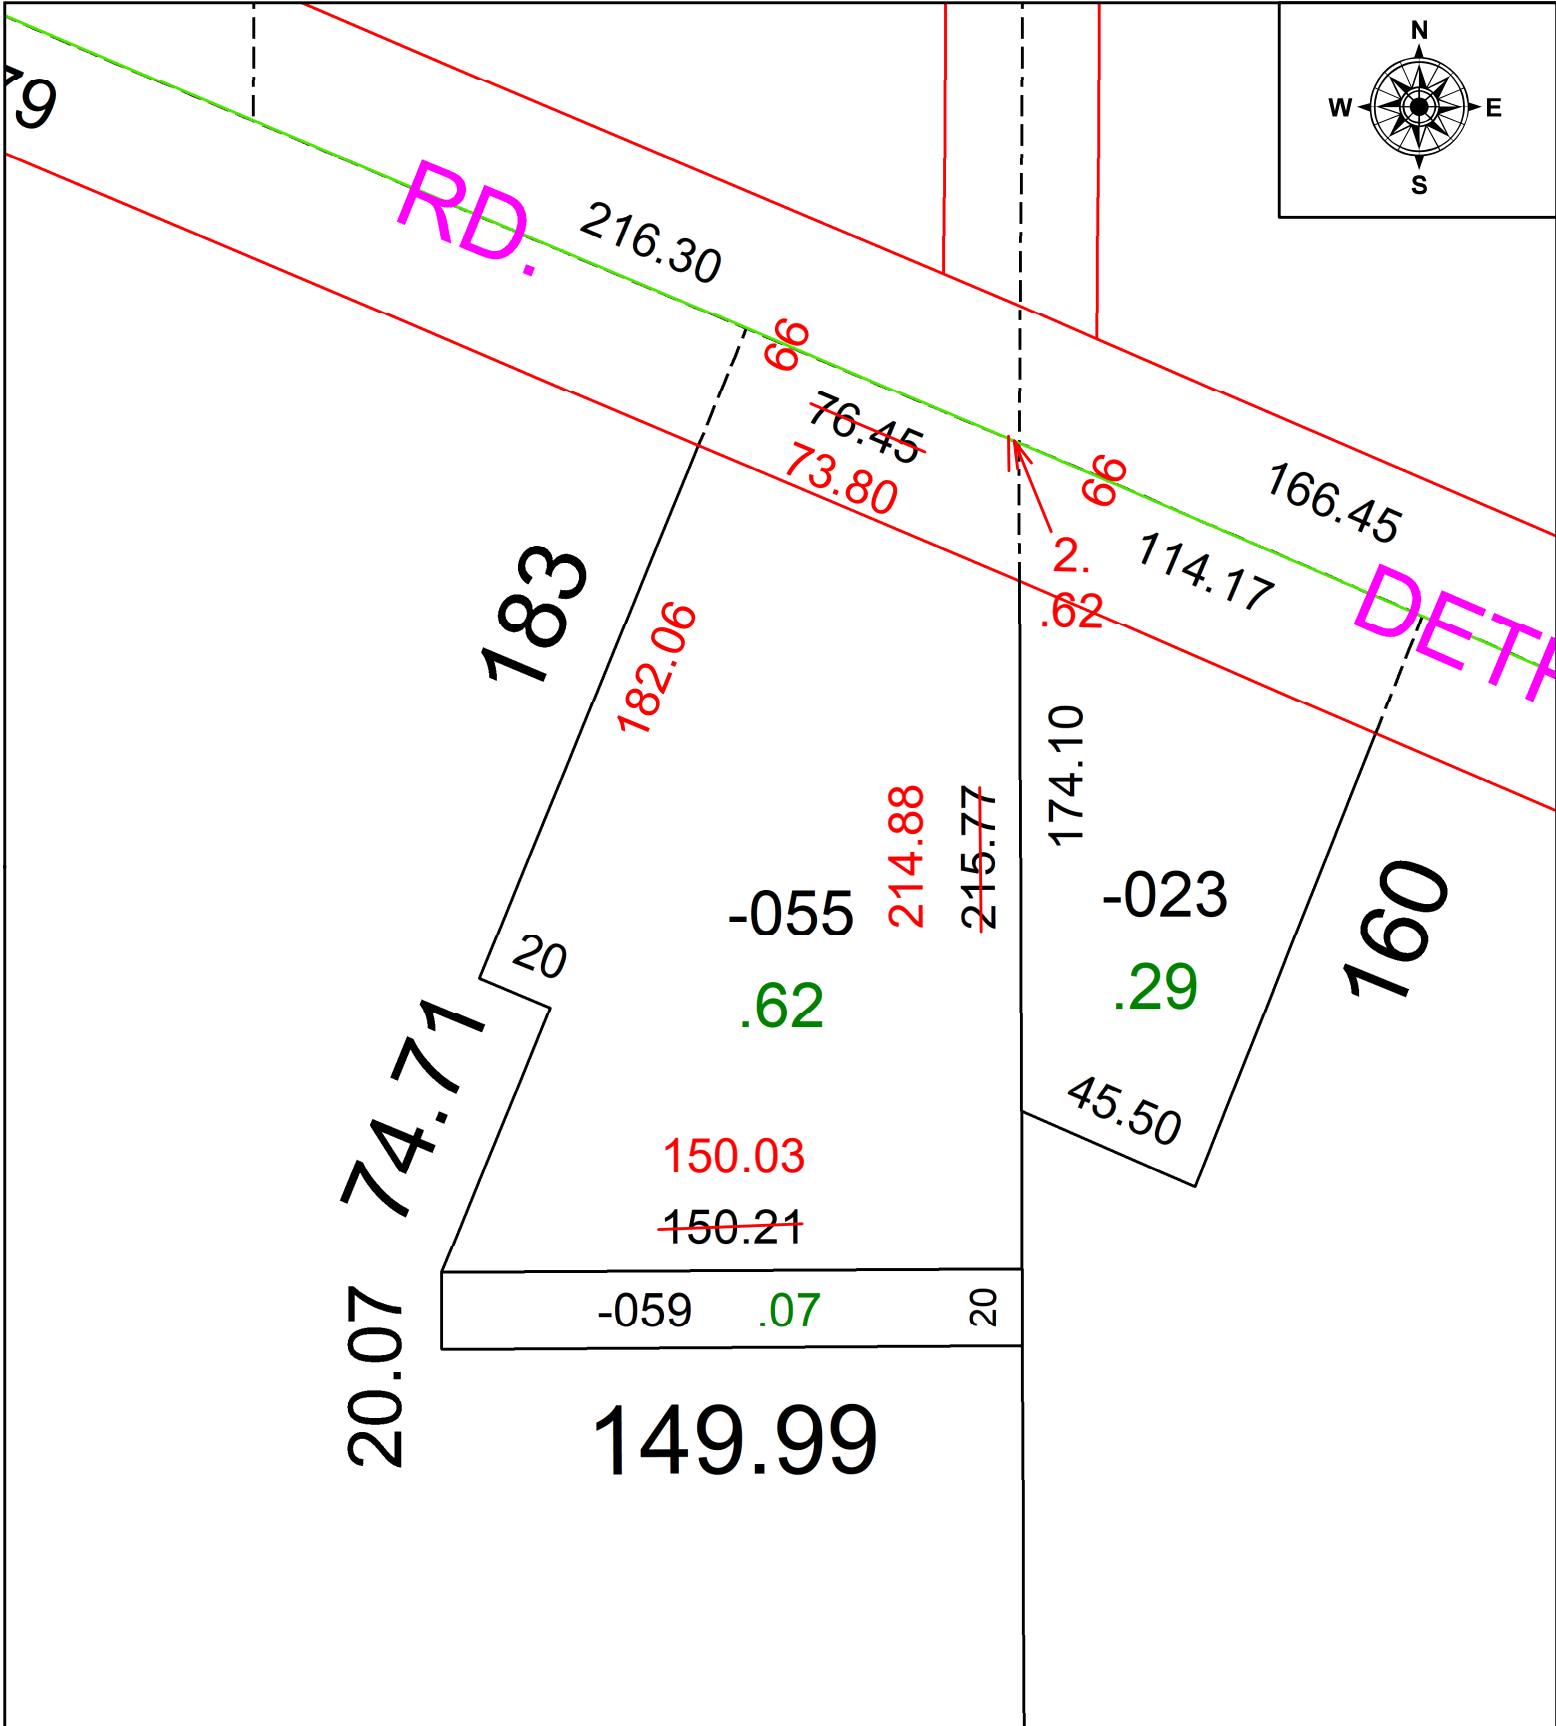


PARENT PARCEL: 04-00-015-110-055

CHILD PARCEL: **MAP CORRECTION ONLY**

STARTING POINT: C/L OF DETRIOT RD AND RIDGE RD

24-05239-C

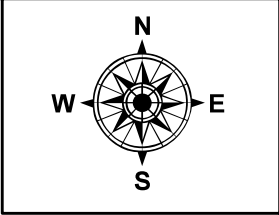

**SPLITS/DEEDS PROCESSED**  
 LORAIN COUNTY TAX MAP DEPARTMENT  
 226 MIDDLE AVE. ELYRIA, OH

SURVEYED BY: MATTHEW A. HILDEBRANDT	SURV # 51119
CLOSURE: 1: 361120	
MAP PAGE(S): 04-00-015	
APPROVED BY: AC	DATE: February 02, 2024
SCALE: 1 in = 50 ft	PRIOR INSTRUMENT: 2023- 0914044