
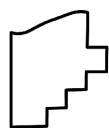


PARENT PARCEL: 07-00-008-113-047

CHILD PARCEL: ADD TO DUP. PER VAC. ORD. # 2024-3

STARTING POINT: N/A

24-05246-V

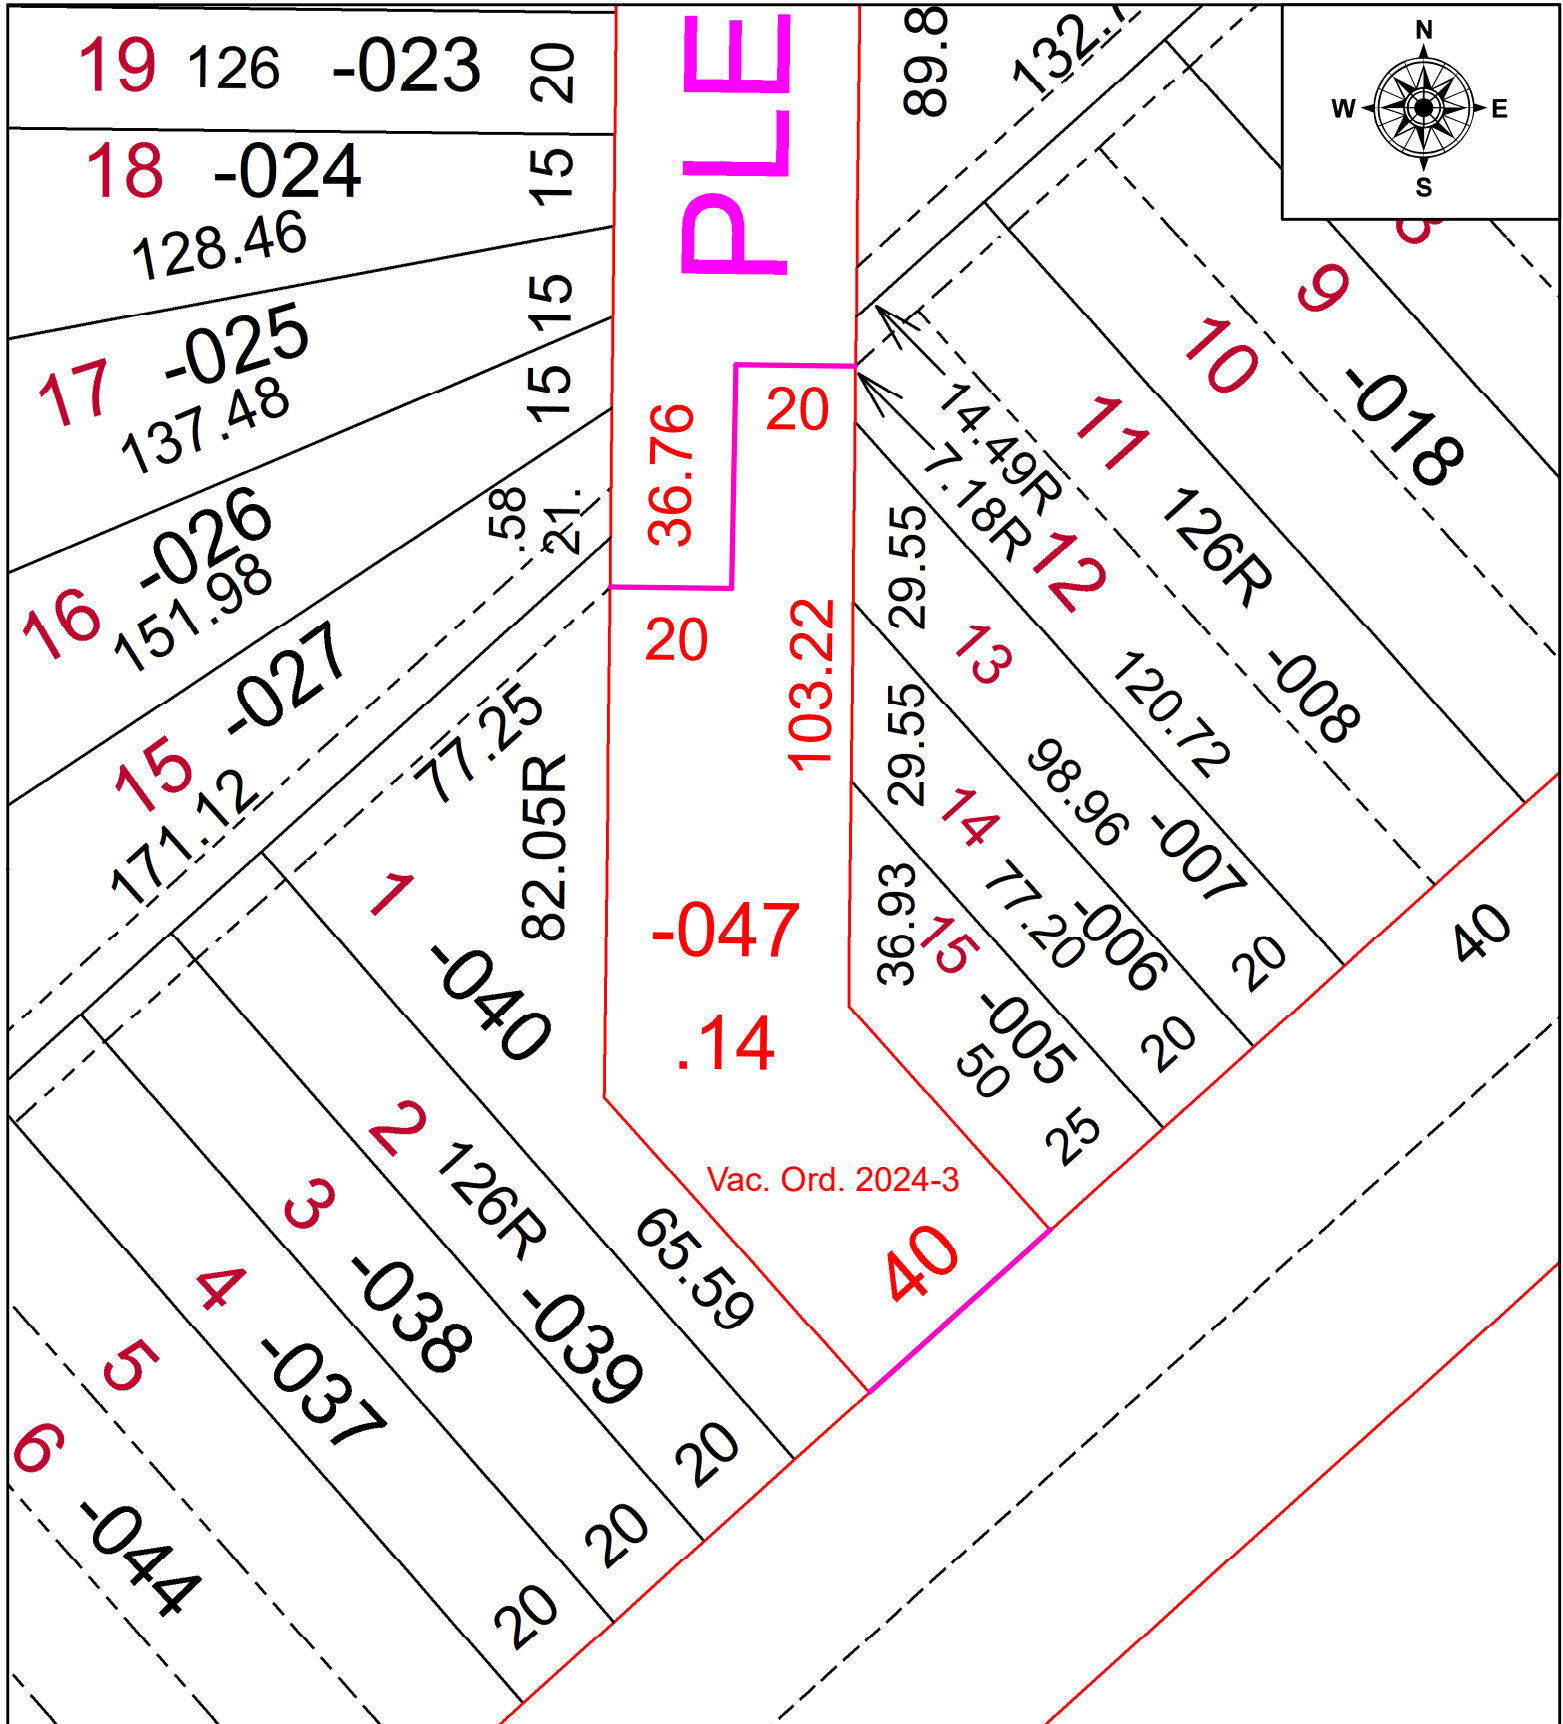

**SPLITS/DEEDS PROCESSED**  
 LORAIN COUNTY TAX MAP DEPARTMENT  
 226 MIDDLE AVE. ELYRIA, OH

SURVEYED BY: WILFREDO BARBOSA SURVEY #: N/A  
 CLOSURE: N/A  
 MAP PAGE(S): 07-00-008  
 APPROVED BY: DMA DATE: 2/12/2024  
 SCALE: 1" = 25' PRIOR INSTRUMENT: N/A