
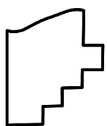


PARENT PARCEL: 02-02-020-102-012, -013, -015, & -016

CHILD PARCEL: AC CORR PER SURVEYOR THOMAS SIMON MAP CORRECTION ONLY FOR -013

STARTING POINT: MONUMENT BOX @ INTERSECTION OF WEST LINE OF O.L. 20 TRACT 2 & C/L OF LAKE SHORE RD

24-05256-C

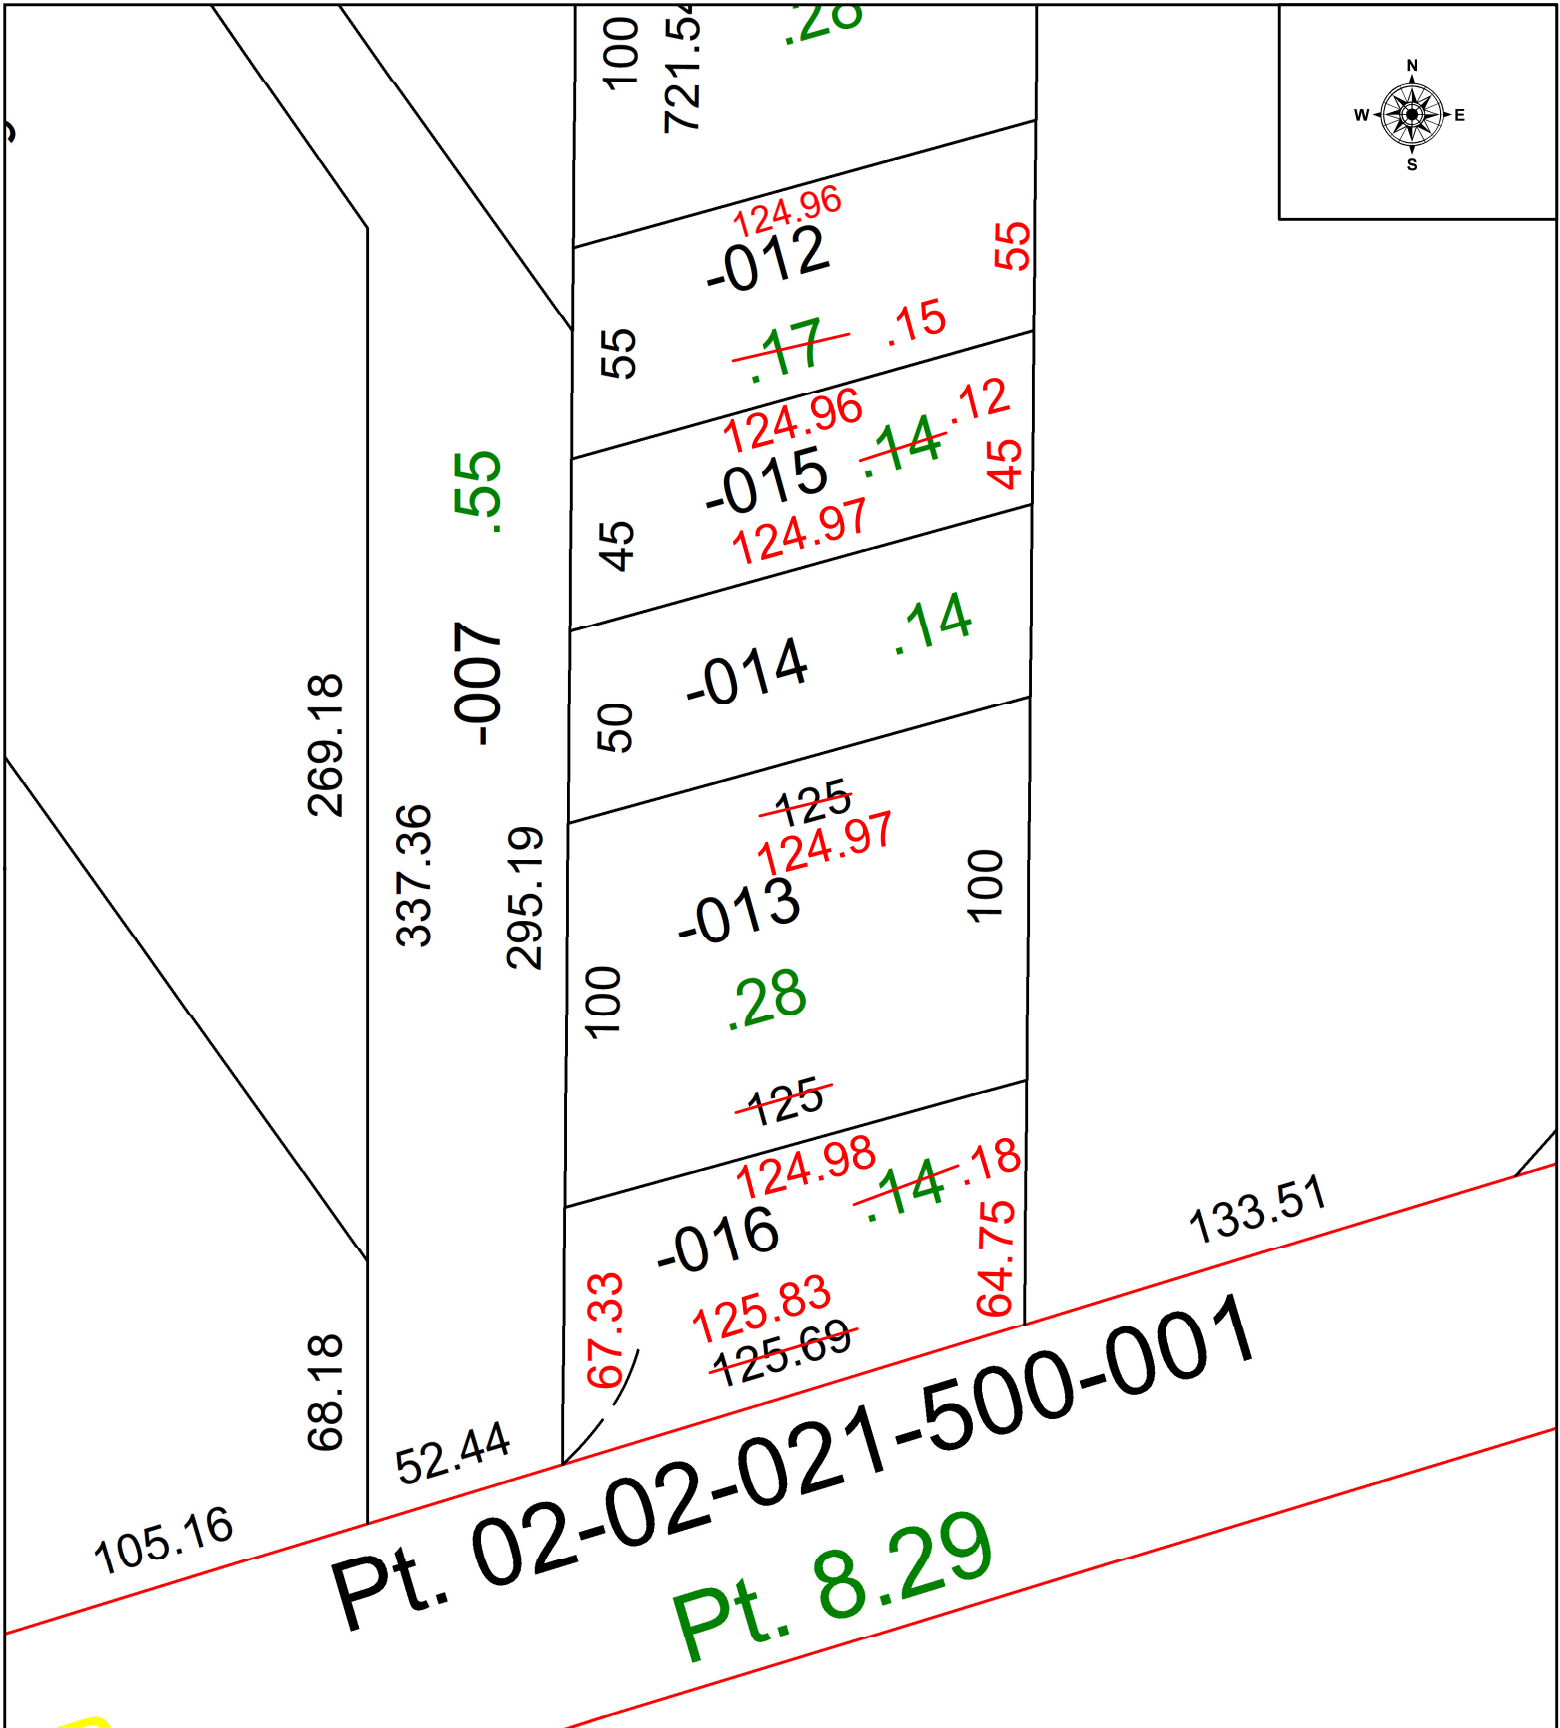

SPLITS/DEEDS PROCESSED
LORAIN COUNTY TAX MAP DEPARTMENT
226 MIDDLE AVE. ELYRIA, OH

SURVEYED BY:	THOMAS SIMON	SURVEY # 51130
CLOSURE:	1: 61123	
MAP PAGE(S):	02-02-020	
APPROVED BY:	WRZ	DATE: 3/6/2024
SCALE:	1" = 50	PRIOR INSTRUMENT: #2017-0640486