
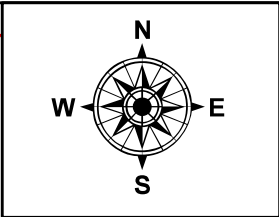



PARENT PARCEL: 07-00-047-000-022

CHILD PARCEL:

STARTING POINT: AC CORR PER SURV BY DALE R. HAYWOOD

24-05257-C

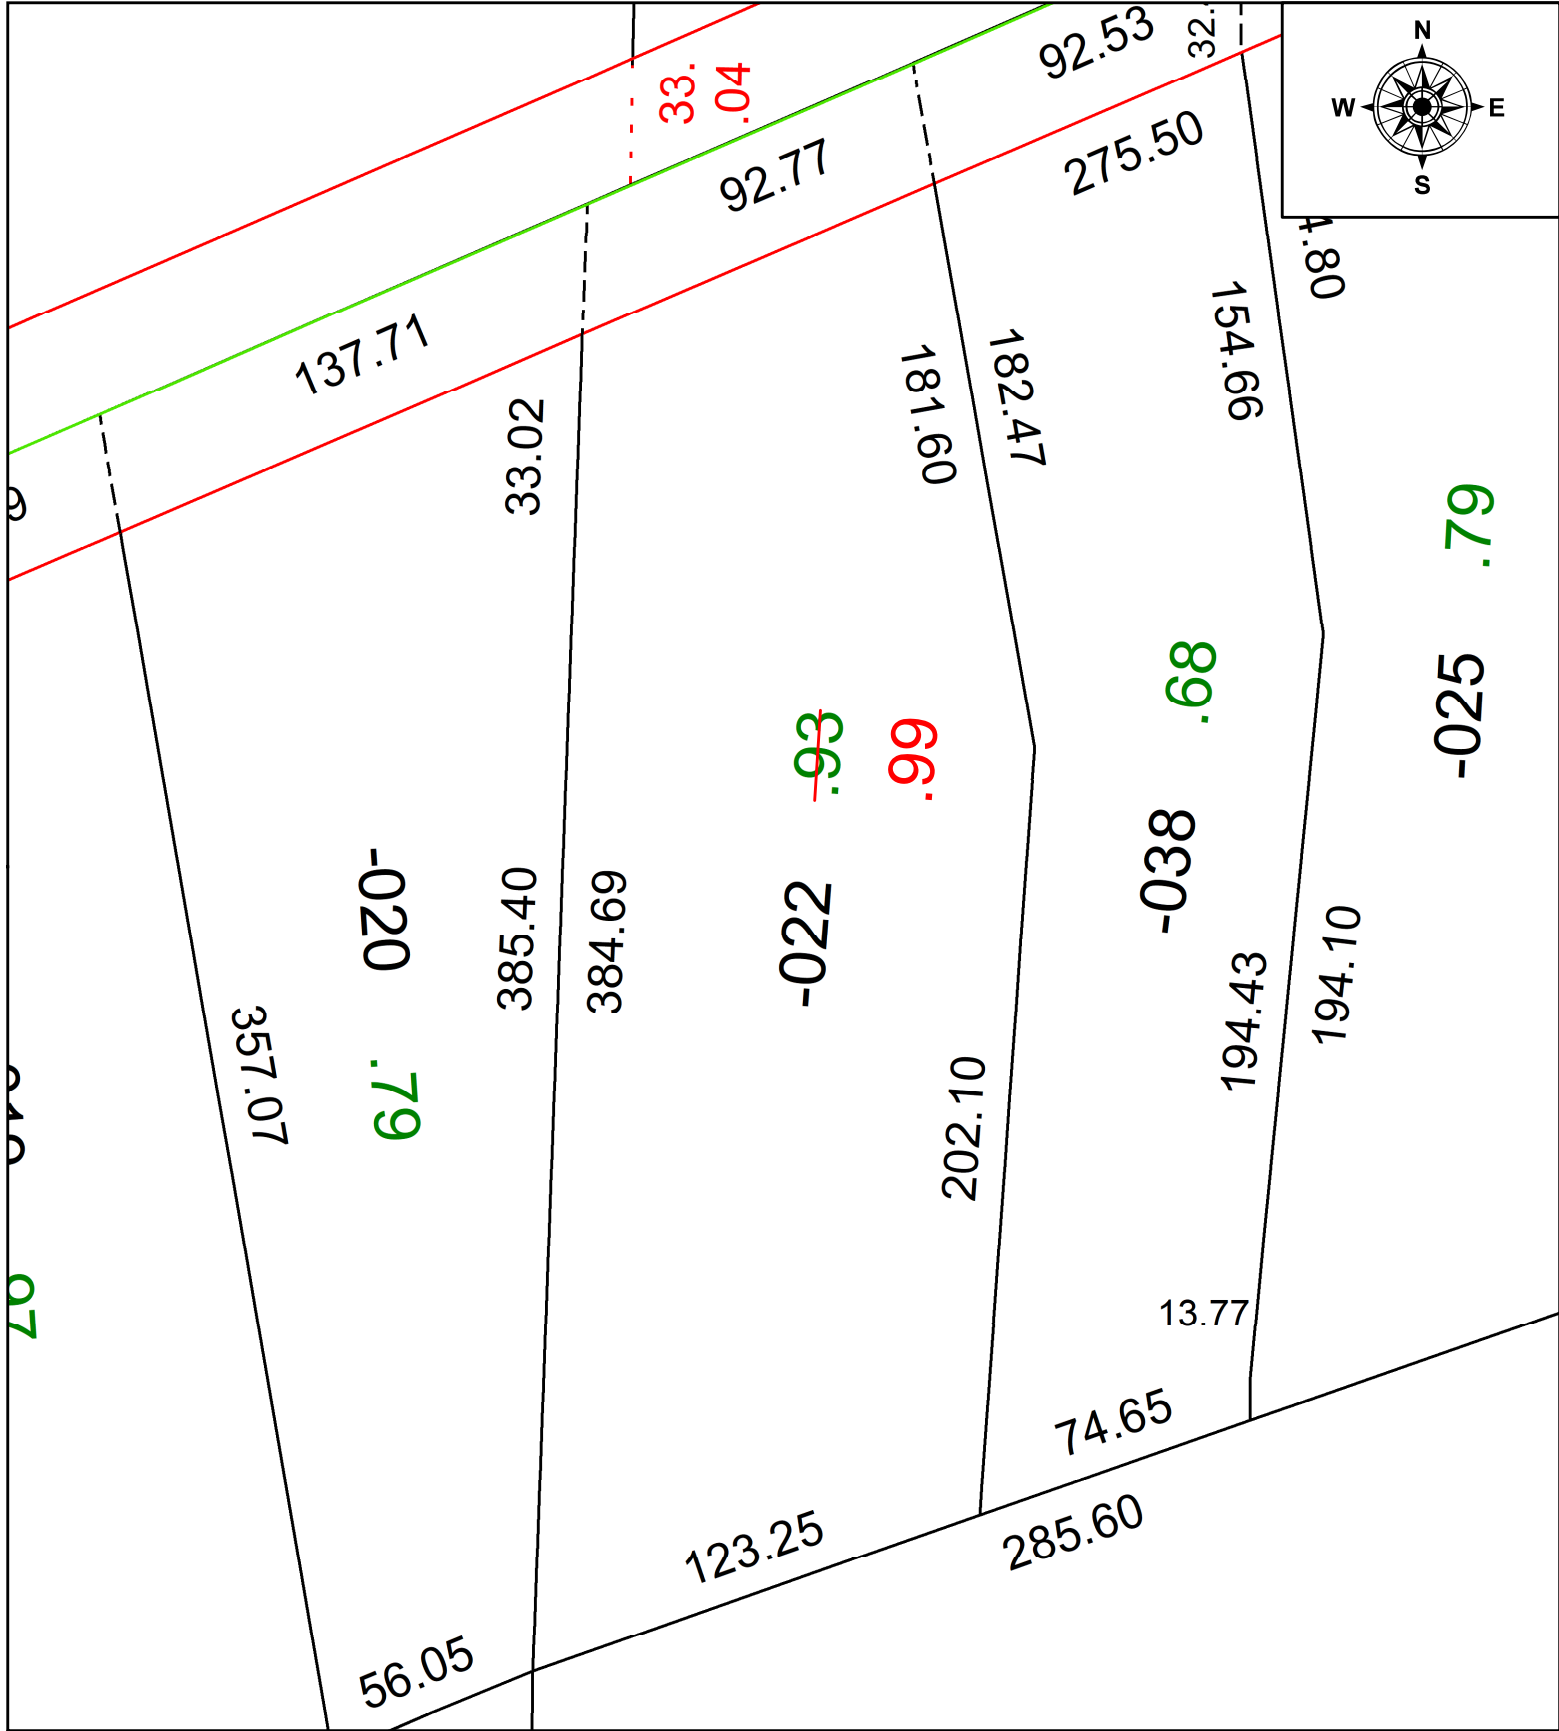

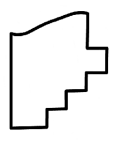 **SPLITS/DEEDS PROCESSED**
 LORAIN COUNTY TAX MAP DEPARTMENT
 226 MIDDLE AVE. ELYRIA, OH

SURVEYED BY: DALE R. HAYWOOD **SURV #** N/A
CLOSURE: 1: 590336
MAP PAGE(S): 07-00-047
APPROVED BY: AC **DATE:** March 08, 2024
SCALE: 1 in = 50 ft **PRIOR INSTRUMENT:** 2017- 0621124