
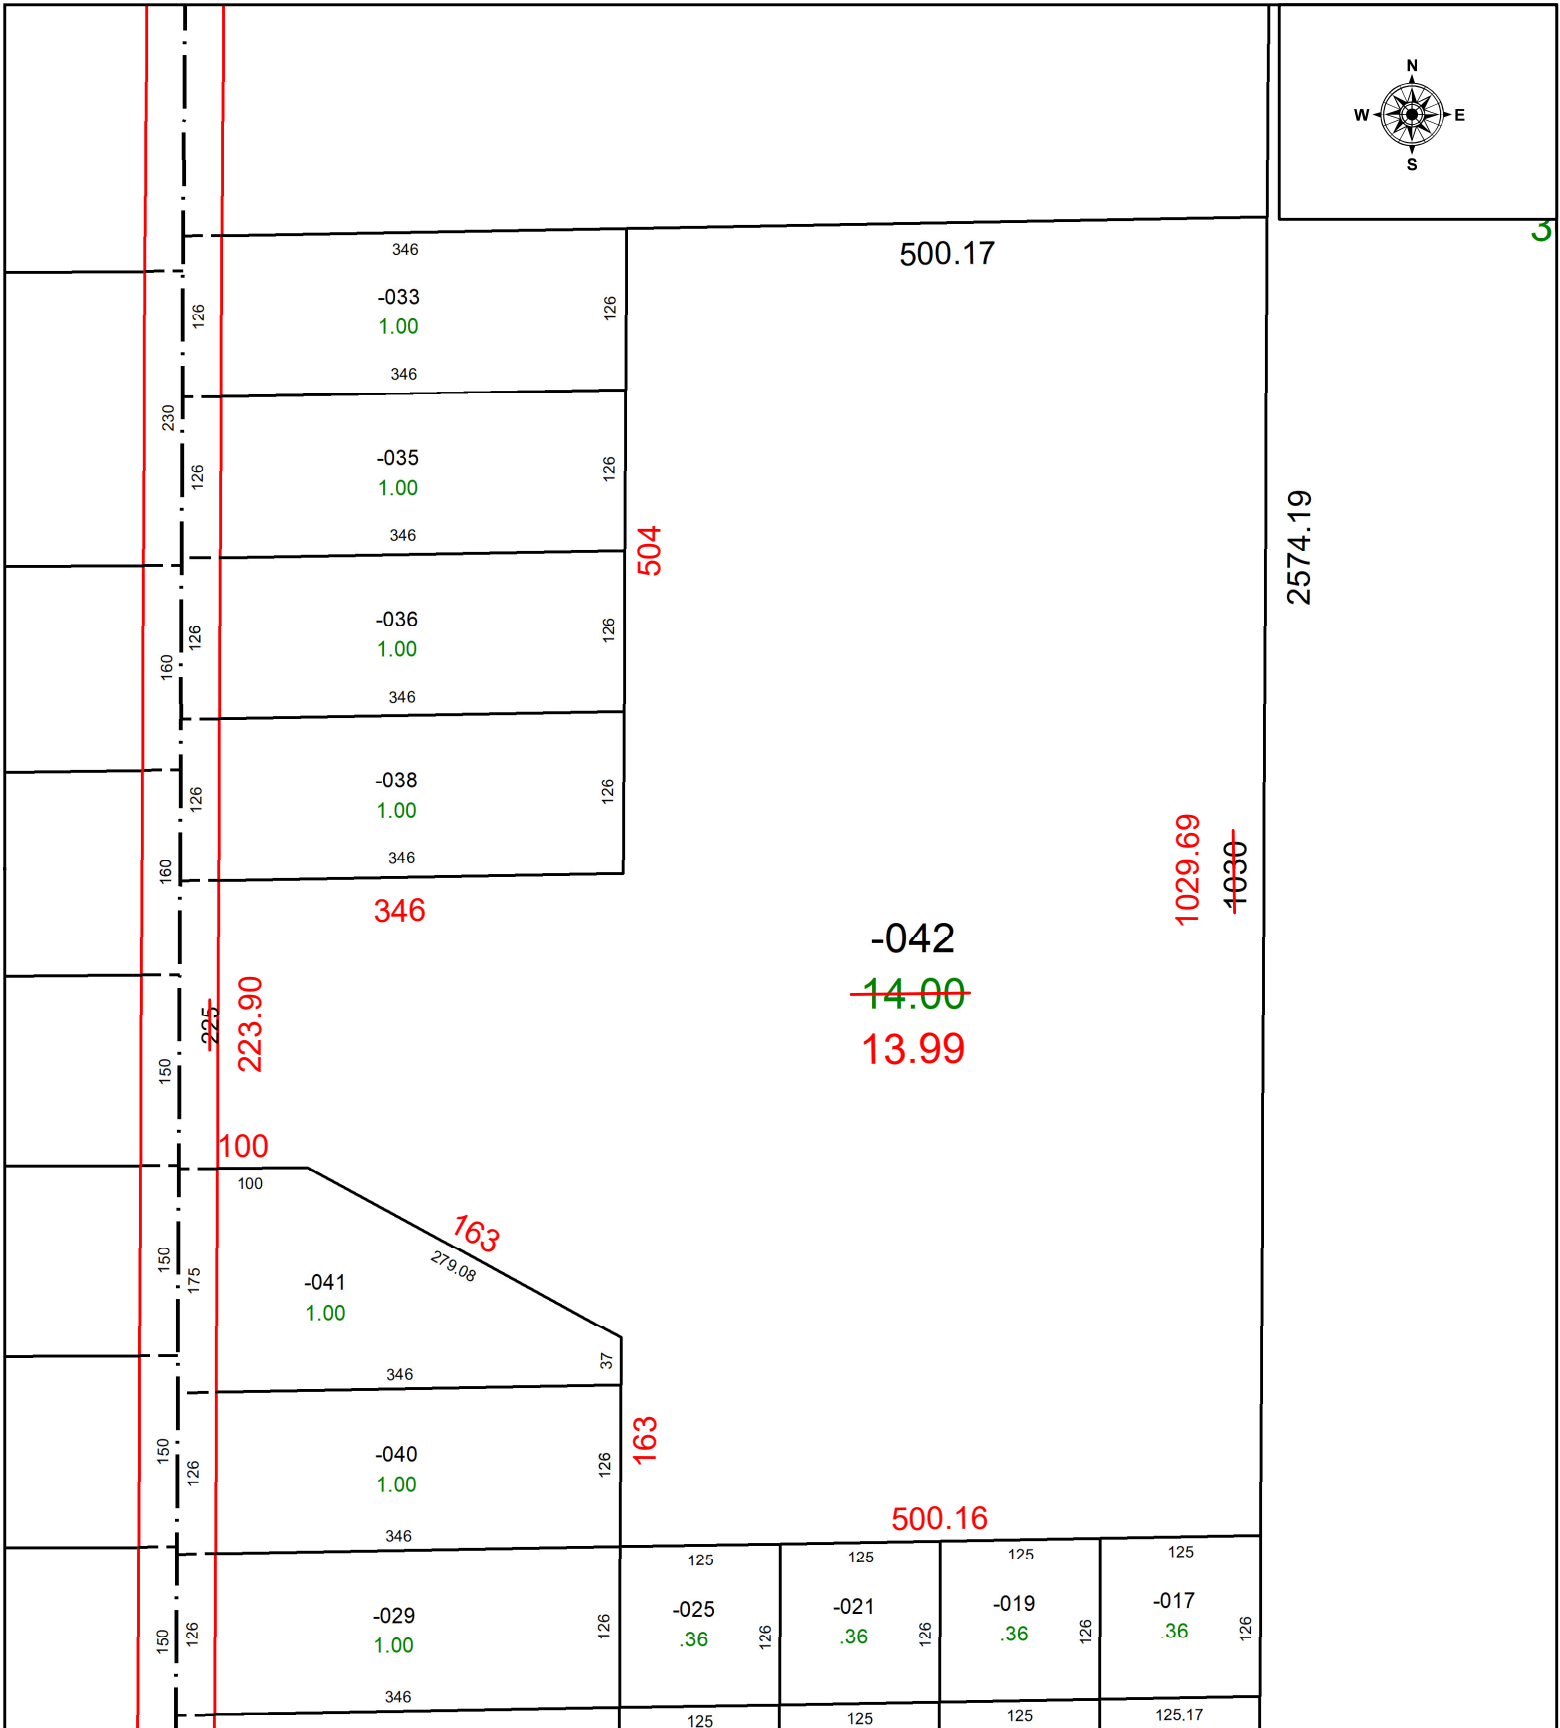


PARENT PARCEL: 12-00-011-000-042

CHILD PARCEL: AC CORR PER SURVEYOR WILFREDO BARBOSA

STARTING POINT: INTERSECTION OF C/LS OF BOSTON RD & S. BOONE RD

24-05258-C

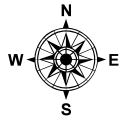

SPLITS/DEEDS PROCESSED
 LORAIN COUNTY TAX MAP DEPARTMENT
 226 MIDDLE AVE. ELYRIA, OH

SURVEYED BY: WILFREDO BARBOSA SURVEY # 51132
 CLOSURE: 1: 129404
 MAP PAGE(S): 12-00-011
 APPROVED BY: WRZ DATE: 3/11/2024
 SCALE: 1" = 150 PRIOR INSTRUMENT: #2019-0702224