


PARENT PARCEL: 03-00-072-000-014, 03-00-073-000-030 & -032

CHILD PARCEL: 03-00-073-000-080 & -081

24-05261-C

STARTING POINT: AC CORR PER SURV BY JOSHUA S. RIEDY

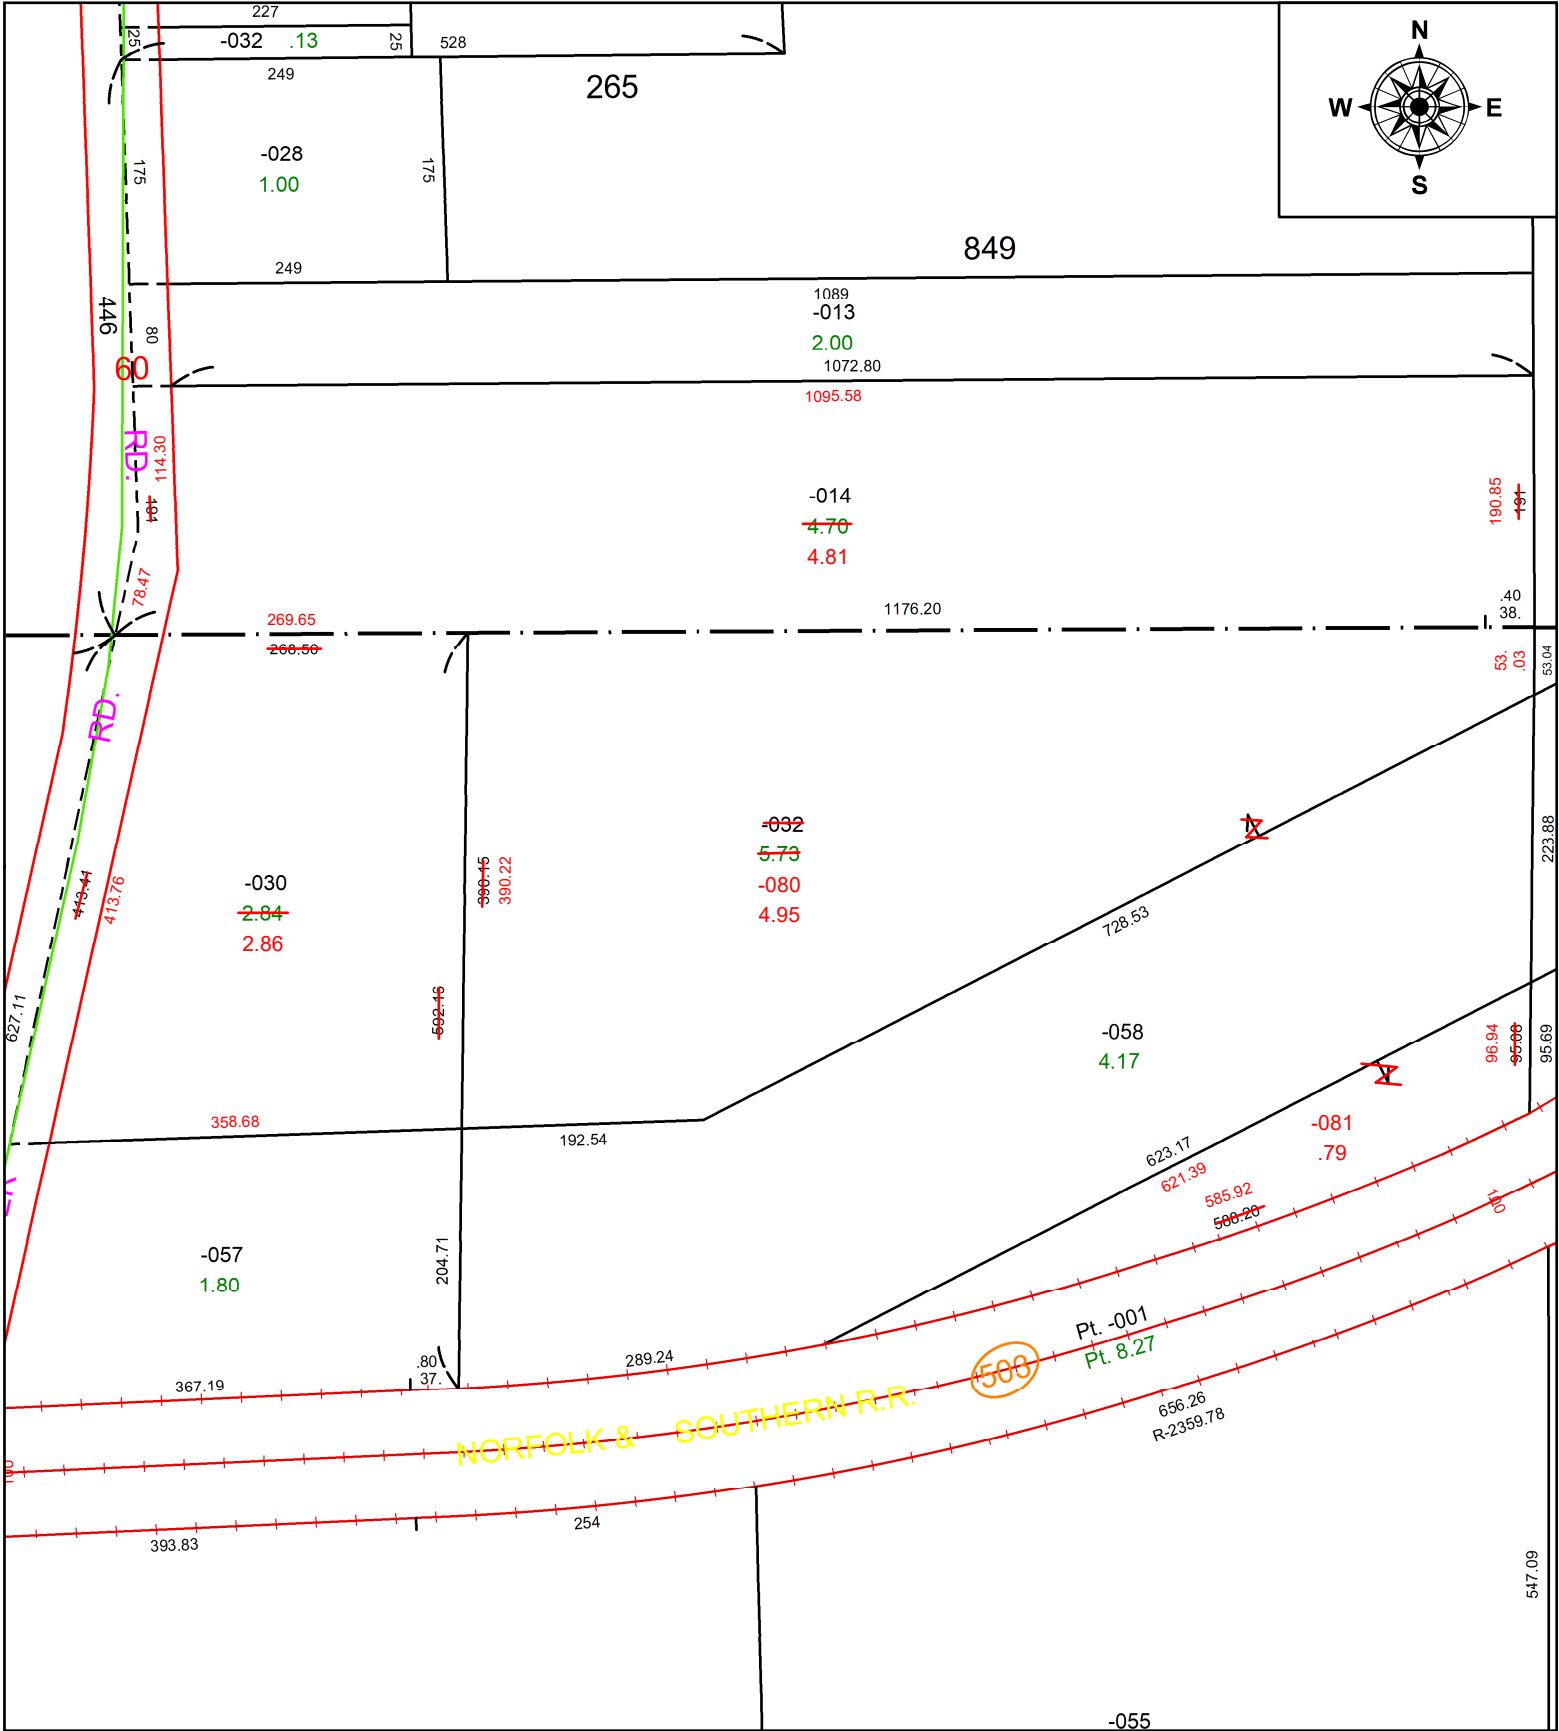

**SPLITS/DEEDS PROCESSED**  
 LORAIN COUNTY TAX MAP DEPARTMENT  
 226 MIDDLE AVE. ELYRIA, OH

**SURVEYED BY:** JOSHUA S. RIEDY **SURV # 51141**  
**CLOSURE:** 1: 100789  
**MAP PAGE(S):** 03-00-072  
**APPROVED BY:** AC **DATE:** March 25, 2024  
**SCALE:** 1 in = 150 ft **PRIOR INSTRUMENT:** 2021- 0821387