
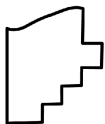


PARENT PARCEL: 03-00-055-118-031

CHILD PARCEL: FRONT & DEPTH TO AC CORR PER SURV BY KYLE R. DANALS

24-05262-C

STARTING POINT: SE CORNER OF S/L 24

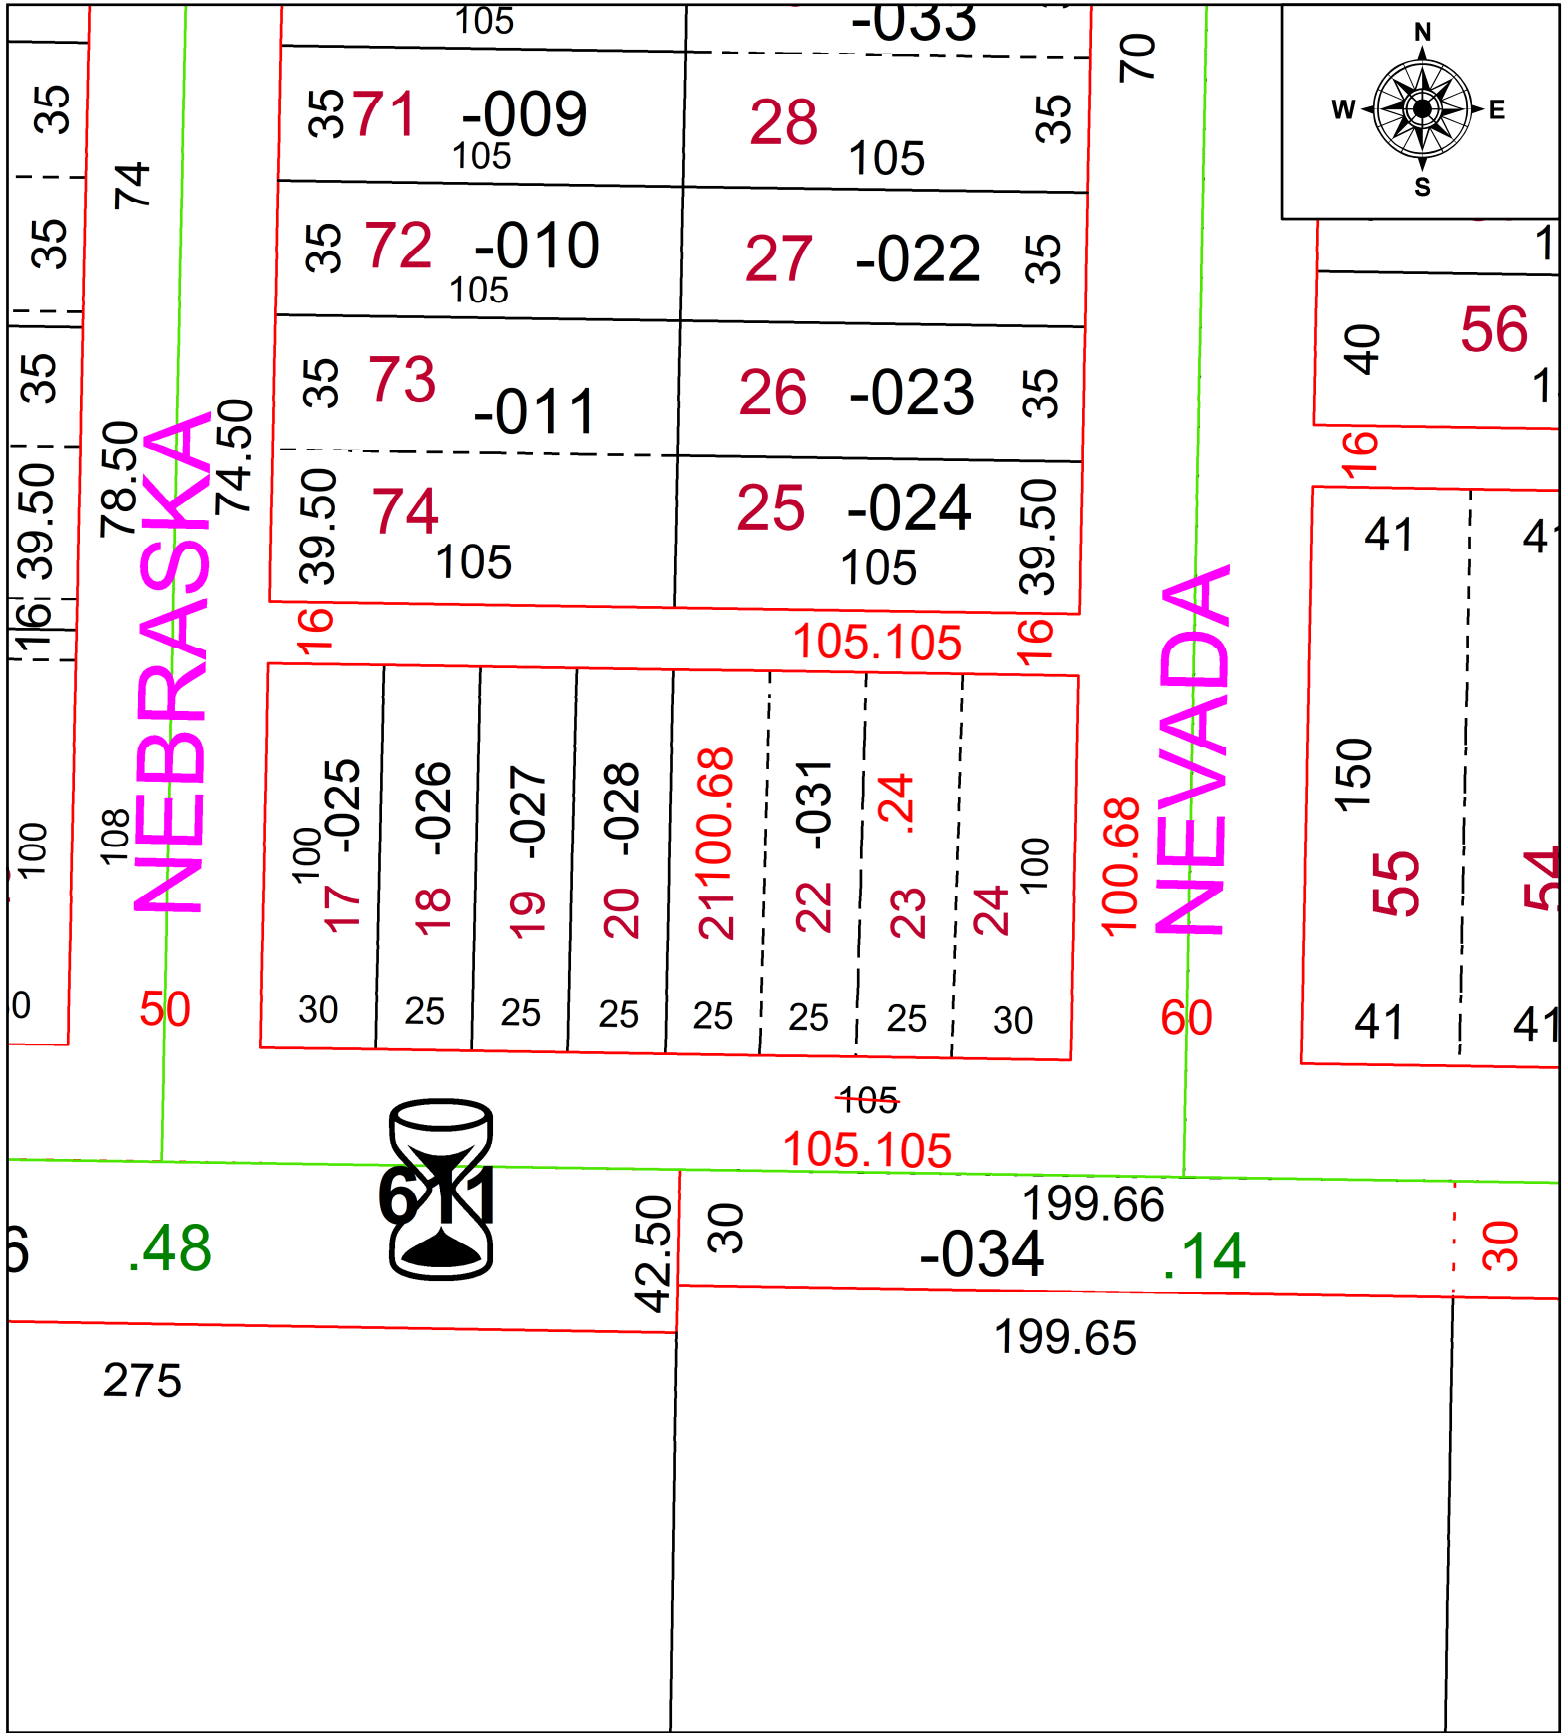

SPLITS/DEEDS PROCESSED
 LORAIN COUNTY TAX MAP DEPARTMENT
 226 MIDDLE AVE. ELYRIA, OH

SURVEYED BY: KYLE R. DANALS SURV # 51142
 CLOSURE: 1: INF
 MAP PAGE(S): 03-00-055
 APPROVED BY: AC DATE: March 26, 2024
 SCALE: 1 in = 50 ft PRIOR INSTRUMENT: 2021- 0840109