
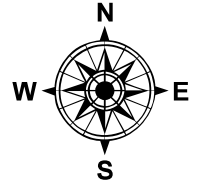


PARENT PARCEL: 06-25-021-104-022 & -050

CHILD PARCEL: 06-25-021-104-051

STARTING POINT: COMBINATION PER PRIOR DEED 2022- 0887227

24-05281-C

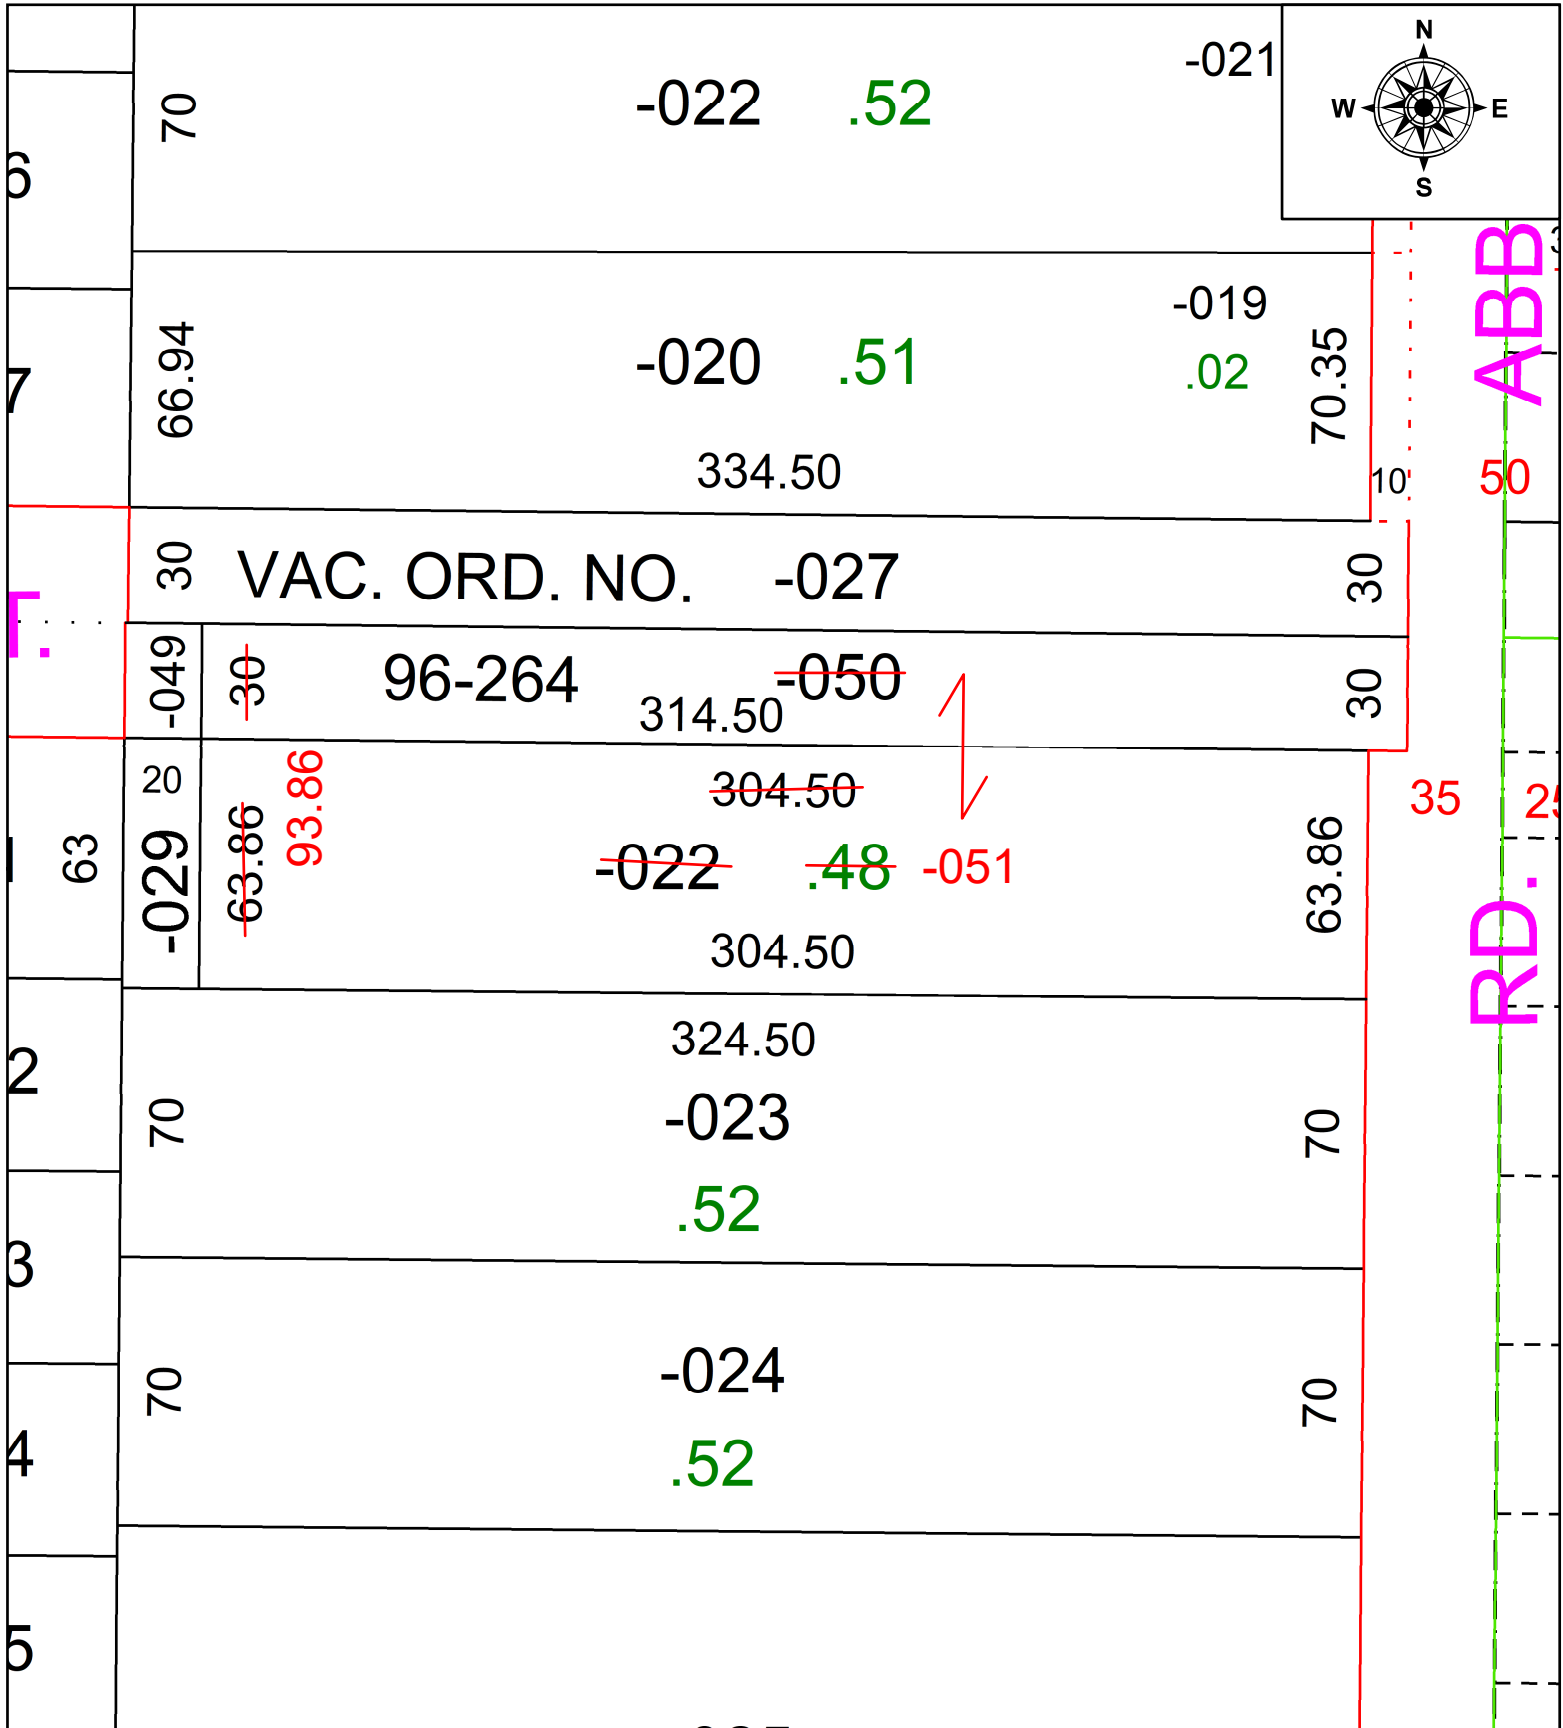


ABB

50

35

RD.

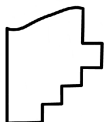

**SPLITS/DEEDS PROCESSED**  
 LORAIN COUNTY TAX MAP DEPARTMENT  
 226 MIDDLE AVE. ELYRIA, OH

SURVEYED BY: J. W. WARDEN SURV # N/A  
 CLOSURE: 1: N/A  
 MAP PAGE(S): 06-25-021  
 APPROVED BY: AC DATE: April 22, 2024  
 SCALE: 1 in = 50 ft PRIOR INSTRUMENT: 2022- 0887227