
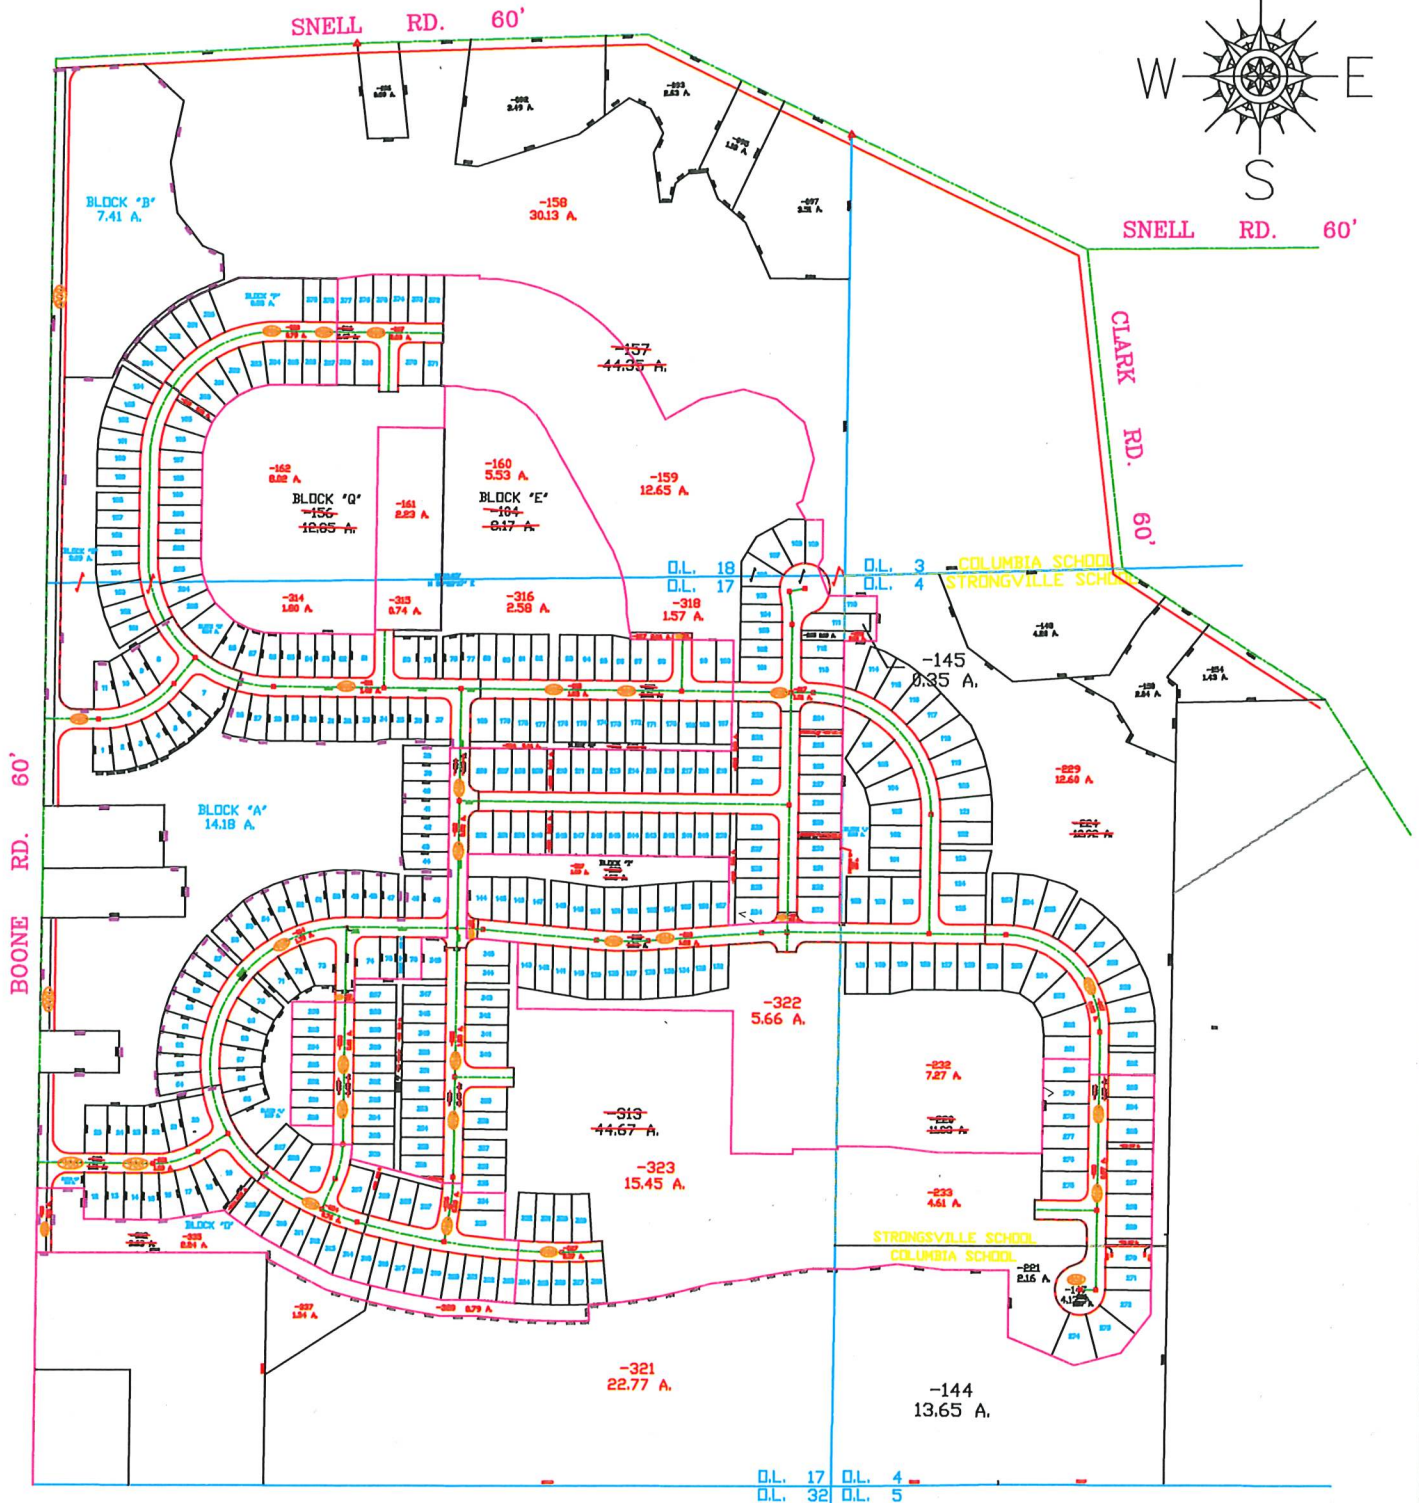


PARENT PARCEL: SPLITS & DROP/ADD TO DUP. PER TIFF DISTRICTS

CHILD PARCEL: XX-XX-XXX-XXX-XXX

STARTING POINT: XXXXXX

24-05285-U

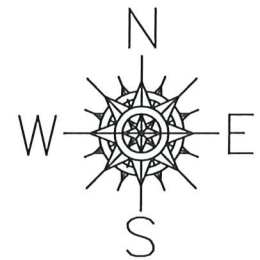

SPLITS/DEEDS PROCESSED

LORAIN COUNTY TAX MAP DEPARTMENT  
226 MIDDLE AVE. ELYRIA, OHIO

SURVEYED BY: MIKE ACKERMAN  
 CLOSURE: NA  
 MAP PAGE(S): 12-00-0047, -017, -018  
 APPROVED BY: TJS DATE: 6/4/2024  
 SCALE: 1" = 600' PRIOR INSTRUMENT: DV XXXX/XXX