


PARENT PARCEL: 03-00-075-113-008

CHILD PARCEL: MAP CORRECTION ONLY

STARTING POINT: NORTHEAST CORNER OF S/L 5 IN GEORGE G. FACKLER'S ALLOTMENT

24-05297-D

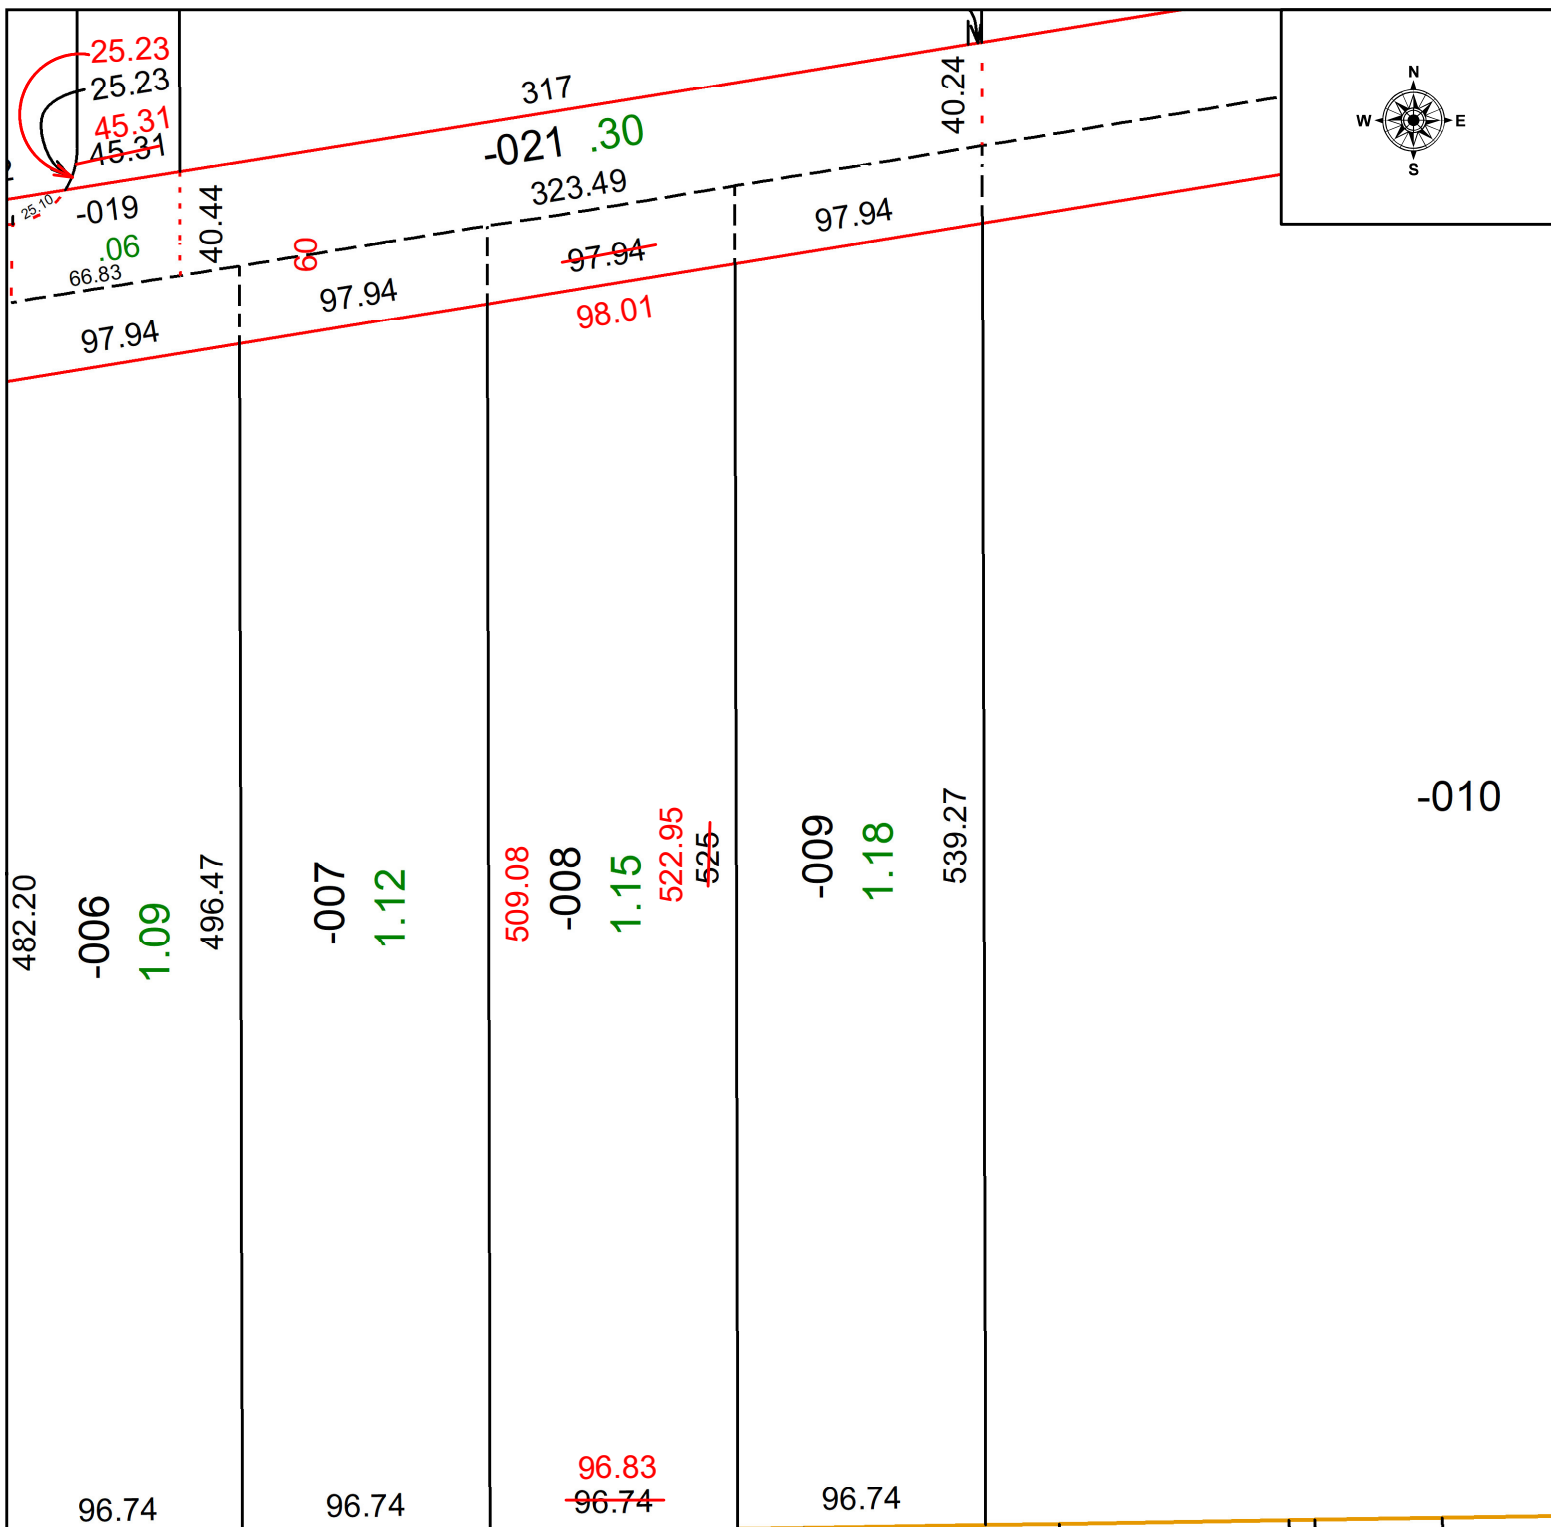


150 09 150 25 4 150 11 150 12 35 150 19 150 21 150 21 150 21 -014 150 21 150 21 015 150 21

Corp.

ELYRIA TWP

50

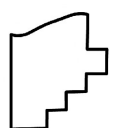

SPLITS/DEEDS PROCESSED
 LORAIN COUNTY TAX MAP DEPARTMENT
 226 MIDDLE AVE. ELYRIA, OH

SURVEYED BY: ROBERT RUFFING SURVEY # 51186
 CLOSURE: 1: 34388
 MAP PAGE(S): 03-00-075
 APPROVED BY: WRZ DATE: 5/14/2024
 SCALE: 1" = 75 PRIOR INSTRUMENT: #2019-0732461