
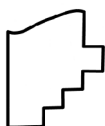


PARENT PARCEL: 07-00-045-101-004

CHILD PARCEL: MAP & ACREAGE CORRECTION

STARTING POINT: I.P. MON. BOX FD. 65.76' SOUTH OF OTTEN RD. & CASE RD. CENTERLINES

24-05304-A

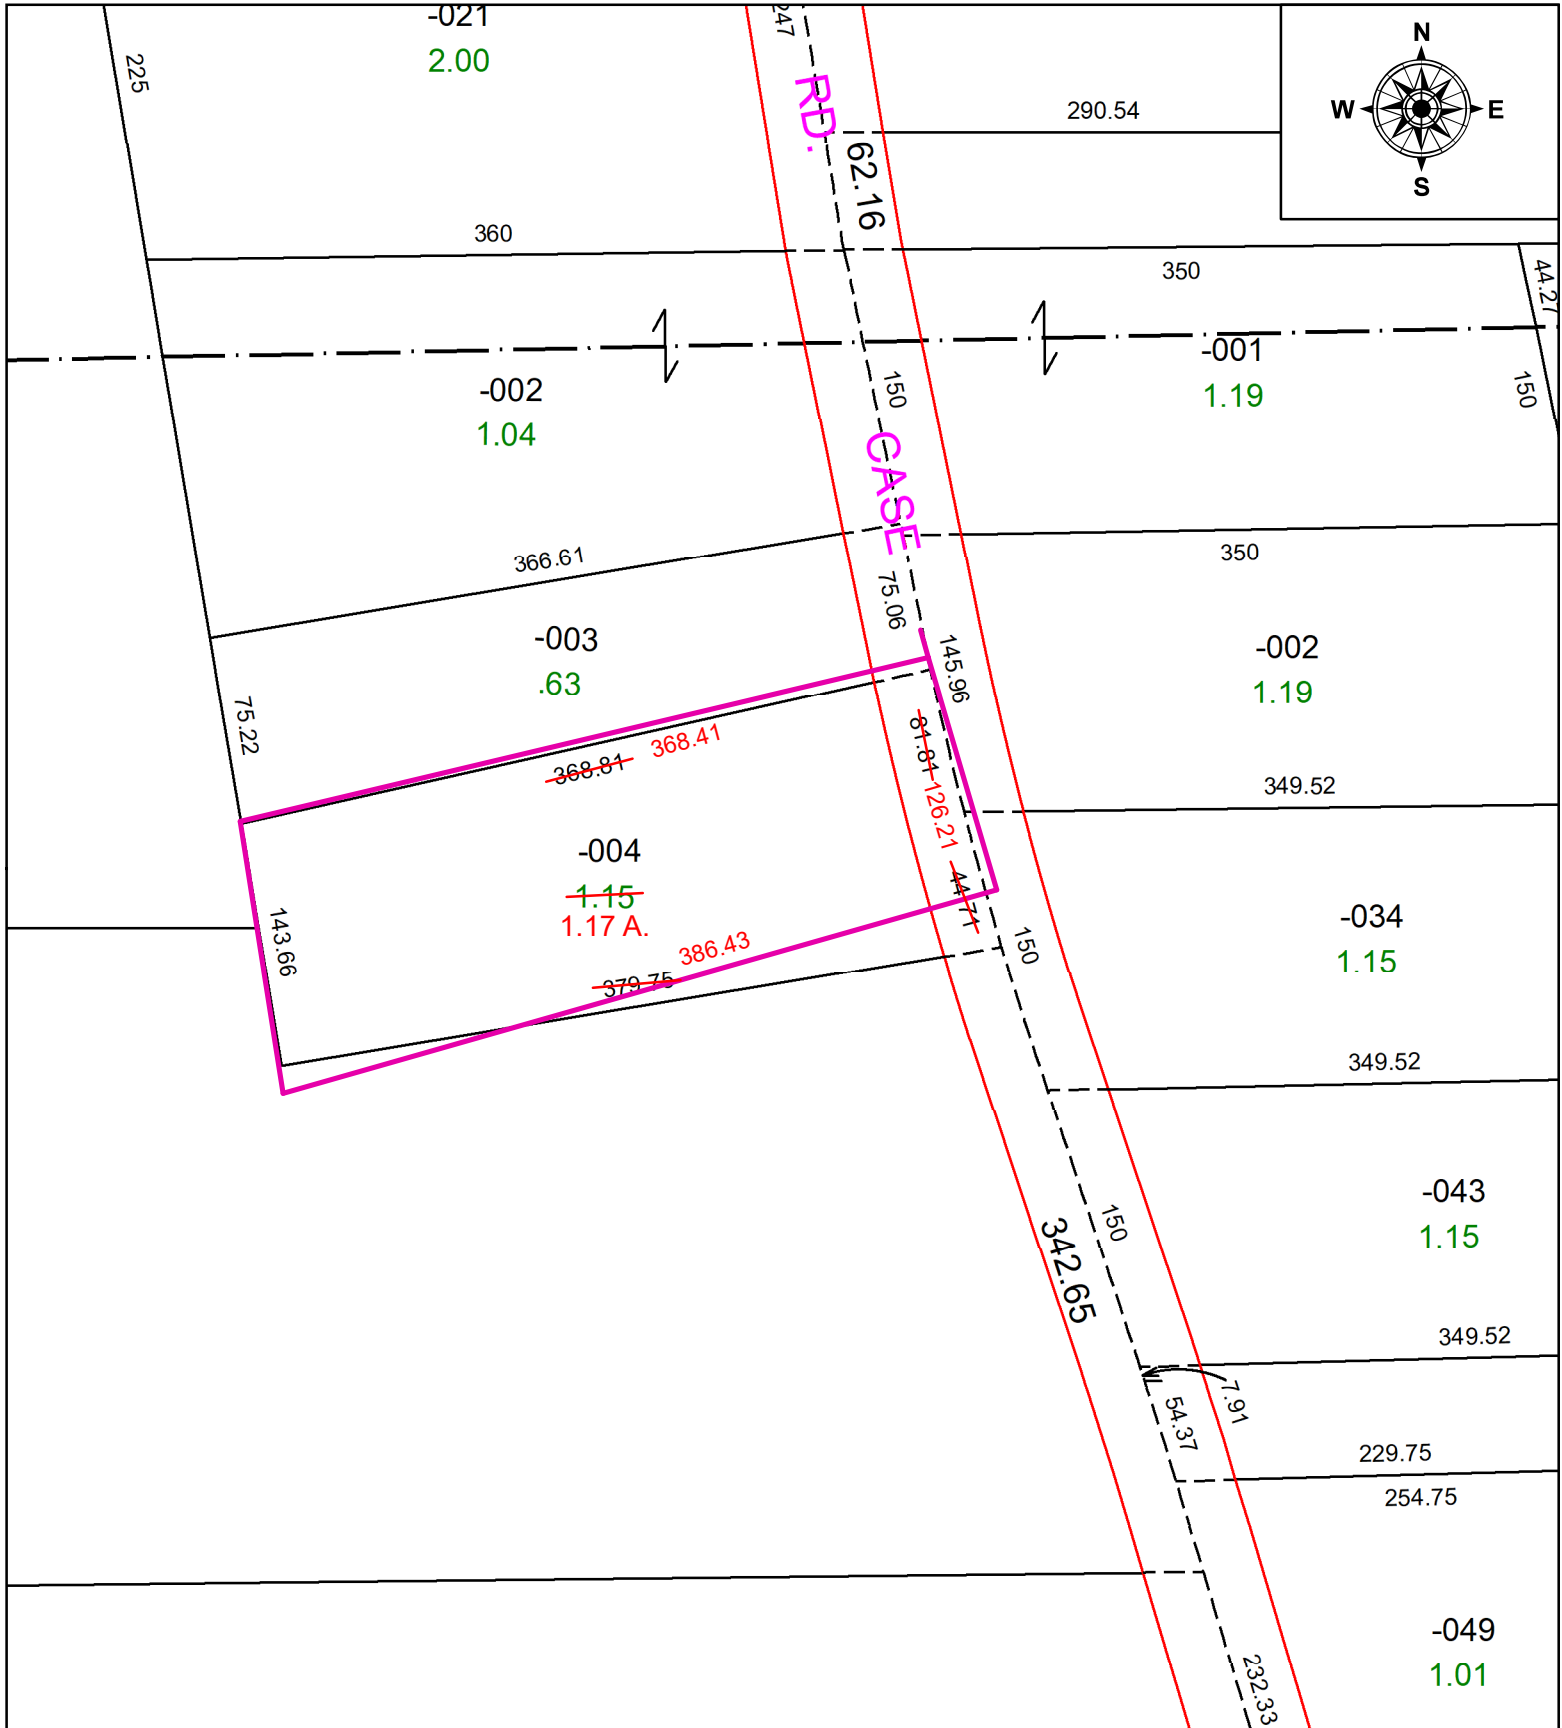

SPLITS/DEEDS PROCESSED
 LORAIN COUNTY TAX MAP DEPARTMENT
 226 MIDDLE AVE. ELYRIA, OH

SURVEYED BY: T. SNEZEK
 CLOSURE: 1: INF
 MAP PAGE(S): 7-00-045
 APPROVED BY: TJS DATE: 5/28/2024
 SCALE: 1" = 100' PRIOR INSTRUMENT: 2015-0587752