
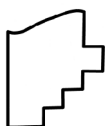
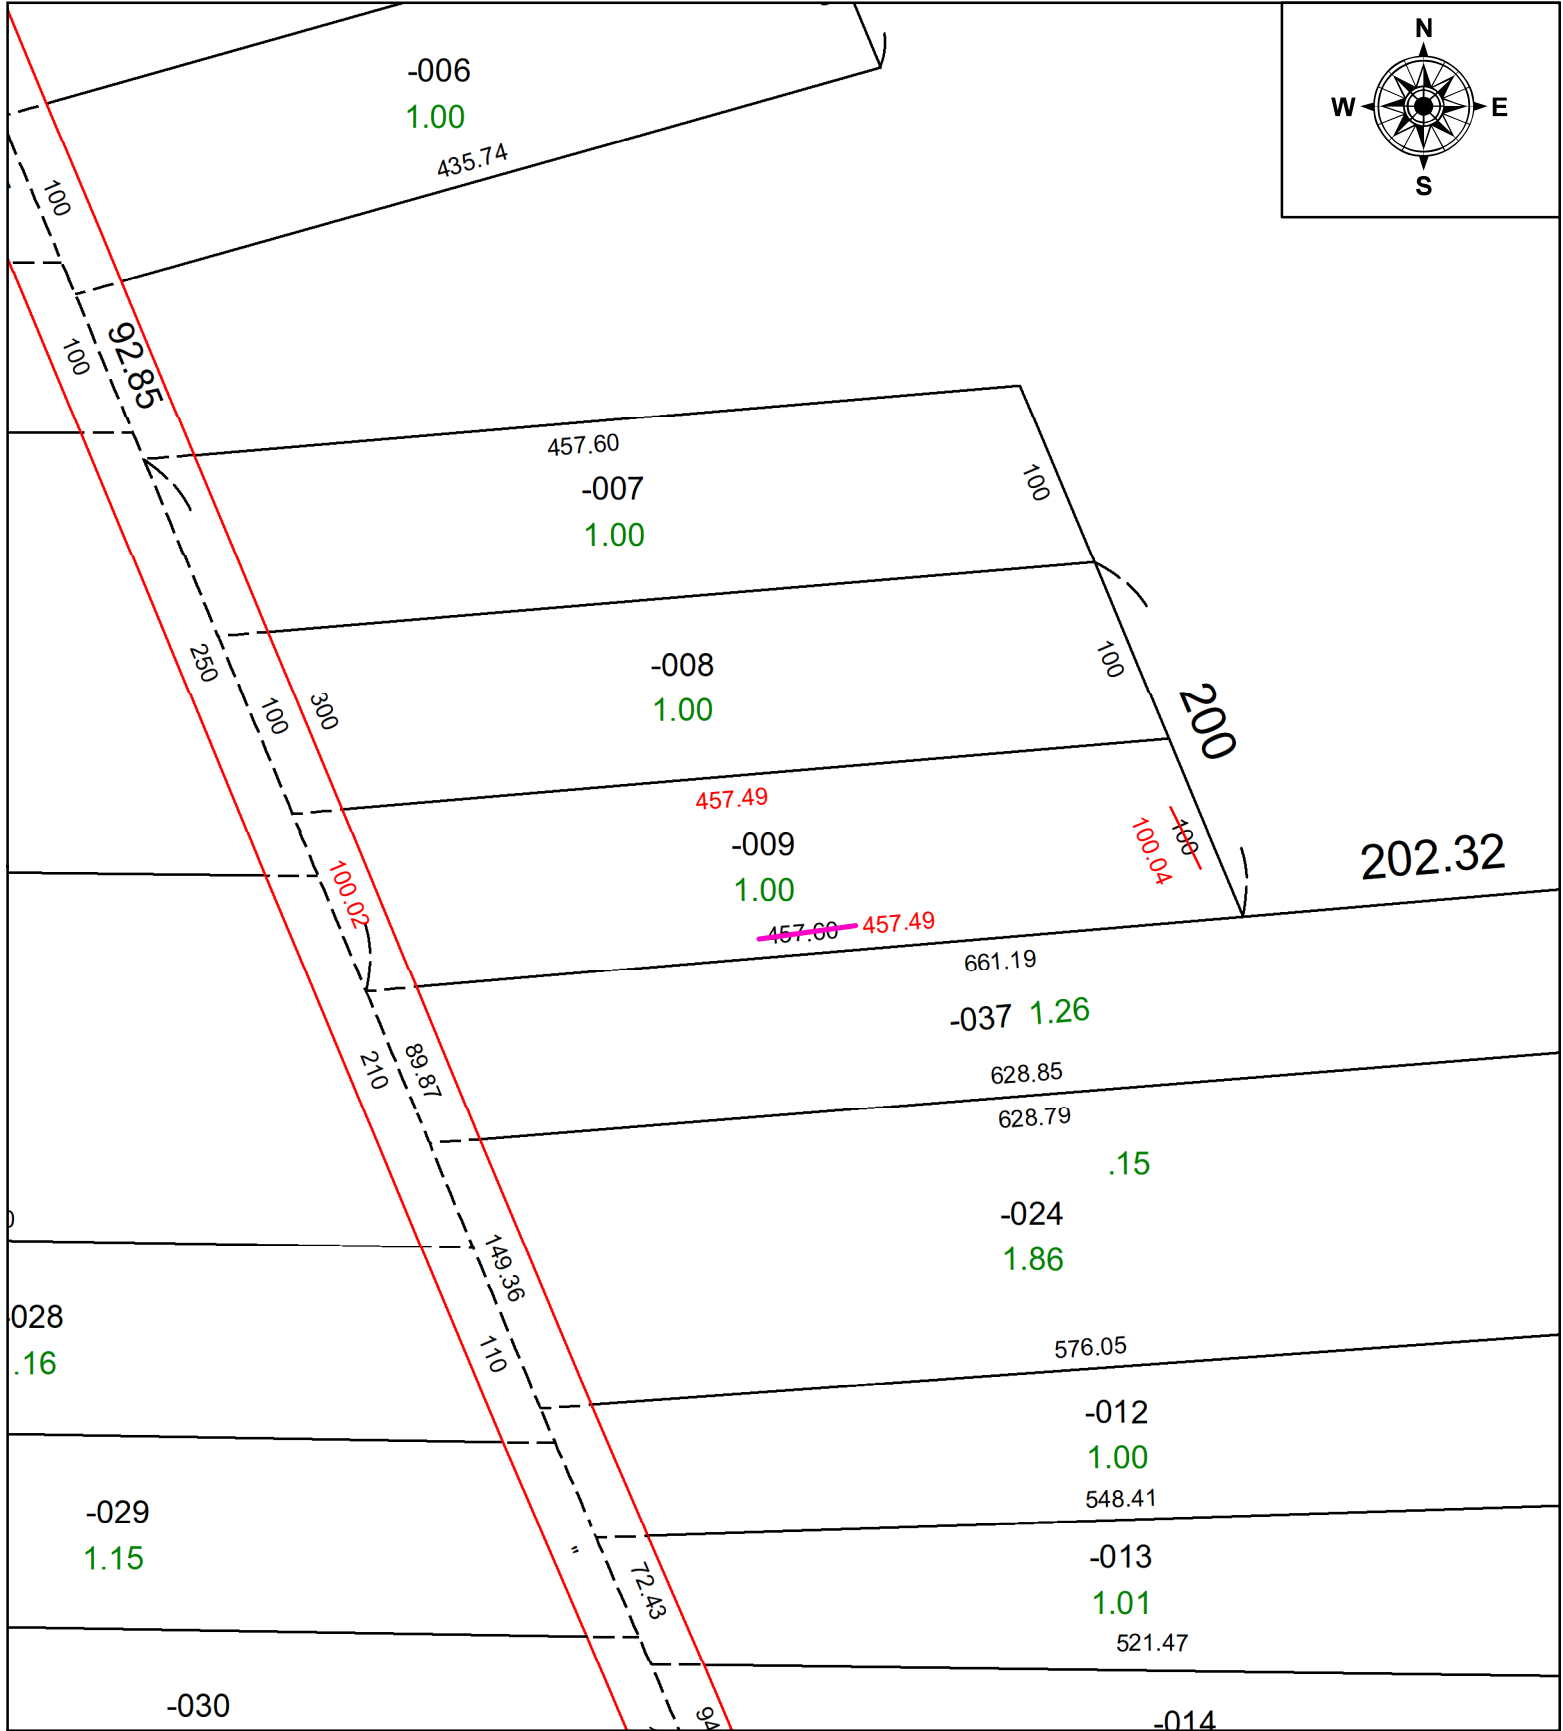


PARENT PARCEL: 01-00-037-103-009

CHILD PARCEL: **MAP CORR. ONLY**

STARTING POINT: C/L OF CLAU ROAD AND NORTH RIDGE ROAD

24-05311-C

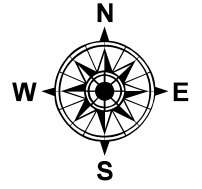

SPLITS/DEEDS PROCESSED
 LORAIN COUNTY TAX MAP DEPARTMENT
 226 MIDDLE AVE. ELYRIA, OH

SURVEYED BY: MATTHEW A. HILDERBRANDT **SURVEY #:** 51208
CLOSURE: 1:152103
MAP PAGE(S): 01-00-037
APPROVED BY: BB **DATE:** 6/14/2024
SCALE: 1 in = 100 ft **PRIOR INSTRUMENT:** 2021-0833598