
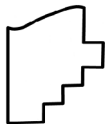


PARENT PARCEL: 18-00-027-113-004

CHILD PARCEL: NEW SURVEY - MAP CORRECTION ONLY

STARTING POINT: I.P. MON. BOX, CL OF PROSPECT ST. & CL OF ERIE ST.

24-05319-D

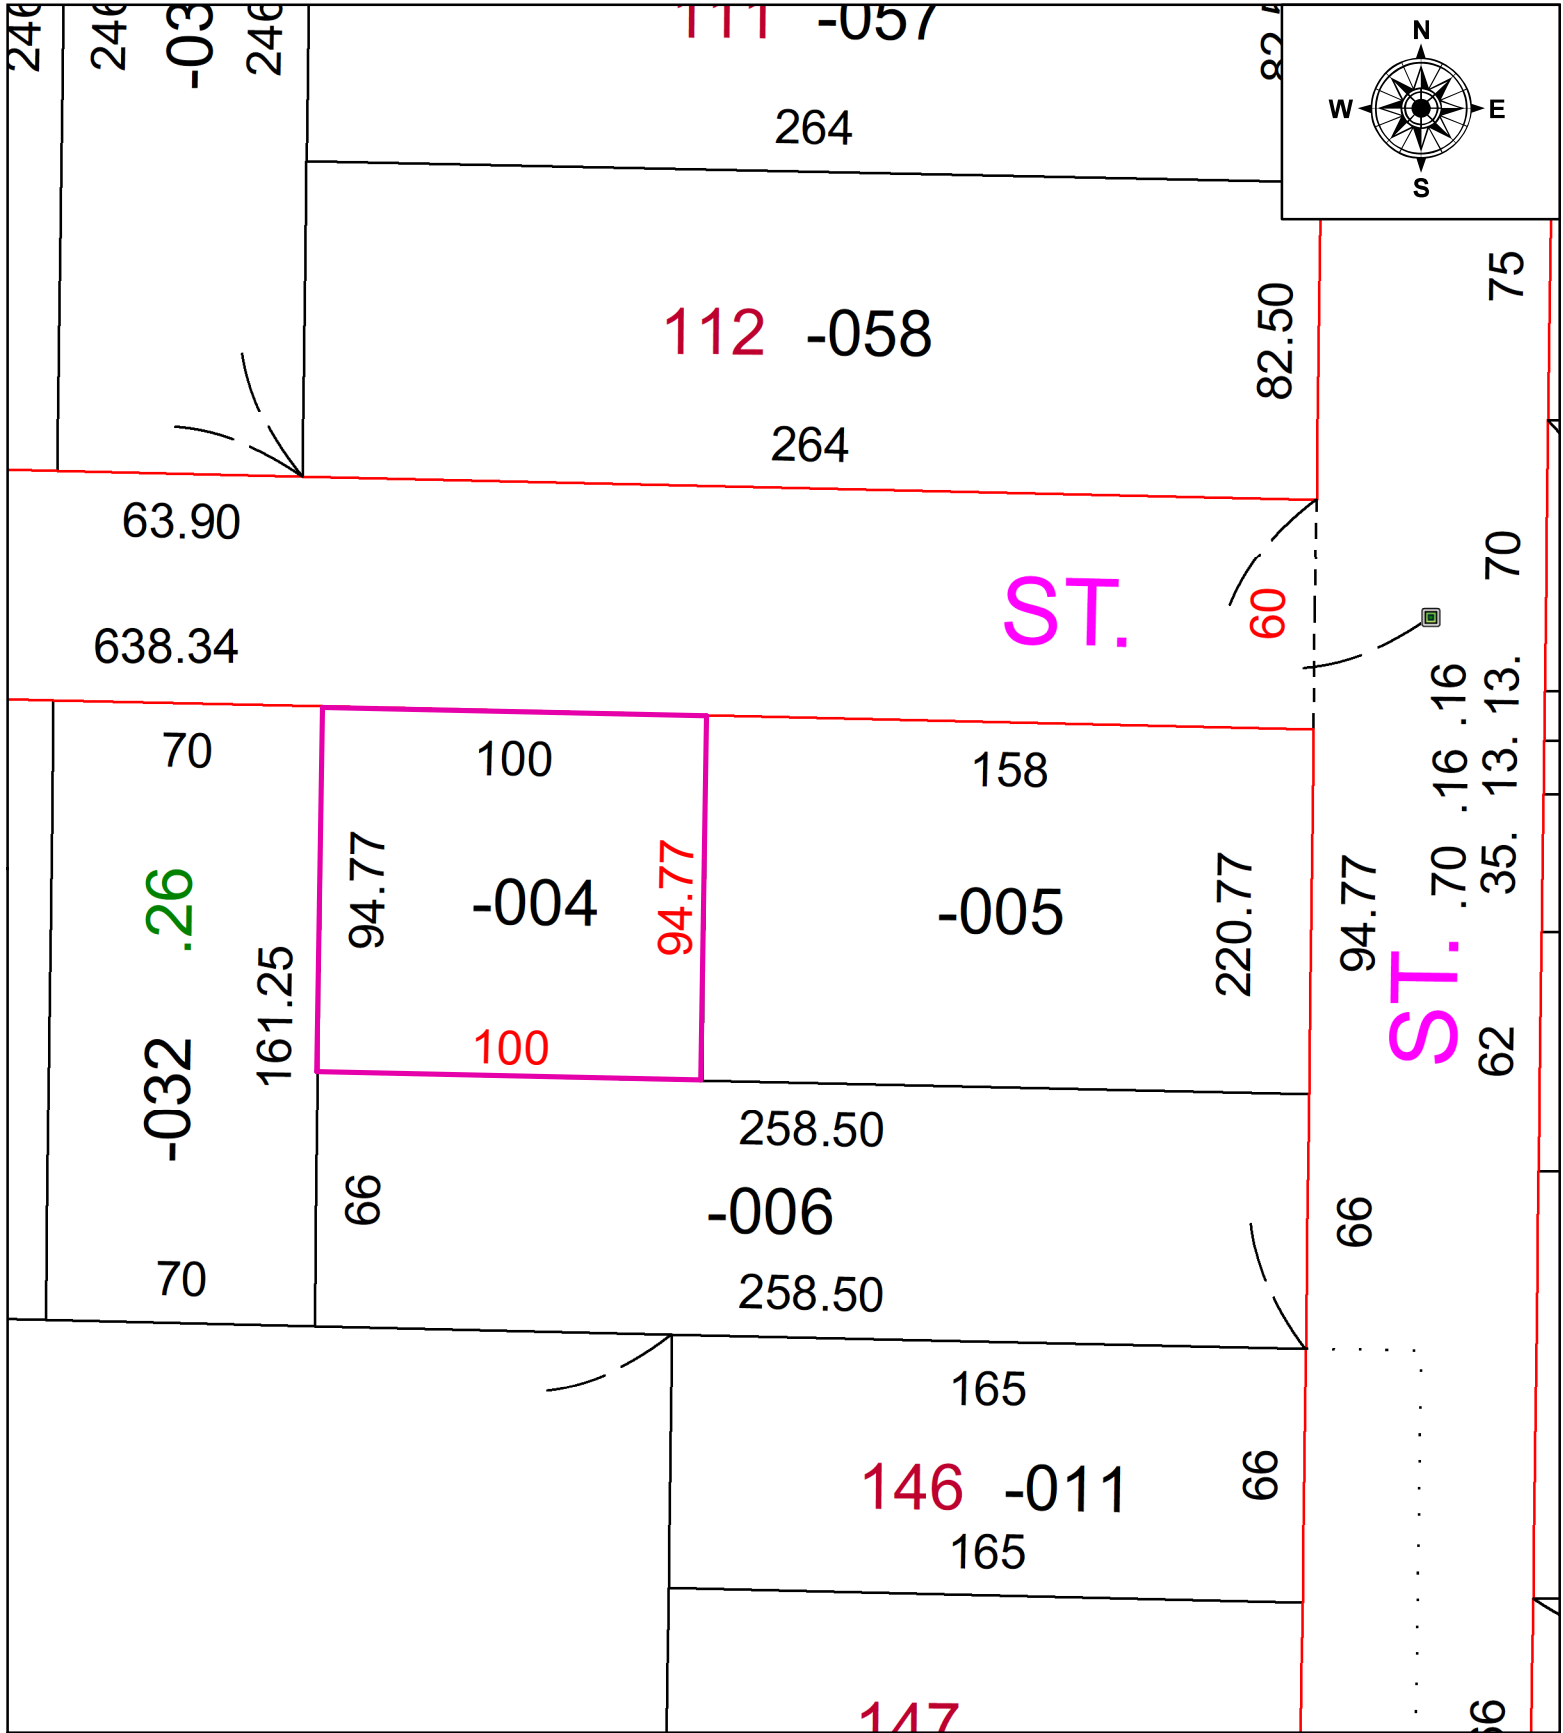

**SPLITS/DEEDS PROCESSED**  
 LORAIN COUNTY TAX MAP DEPARTMENT  
 226 MIDDLE AVE. ELYRIA, OH

SURVEYED BY: THOMAS SNEZEK  
 CLOSURE: 1: INF  
 MAP PAGE(S): 18-00-027  
 APPROVED BY: TJS DATE: 7/8/2024  
 SCALE: 1" = 50' PRIOR INSTRUMENT: 2022-0882751