
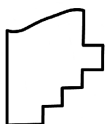


PARENT PARCEL: 09-00-074-102-010

CHILD PARCEL: AC. CORR. PER CALCULATION

STARTING POINT: N/A

24-05322-A

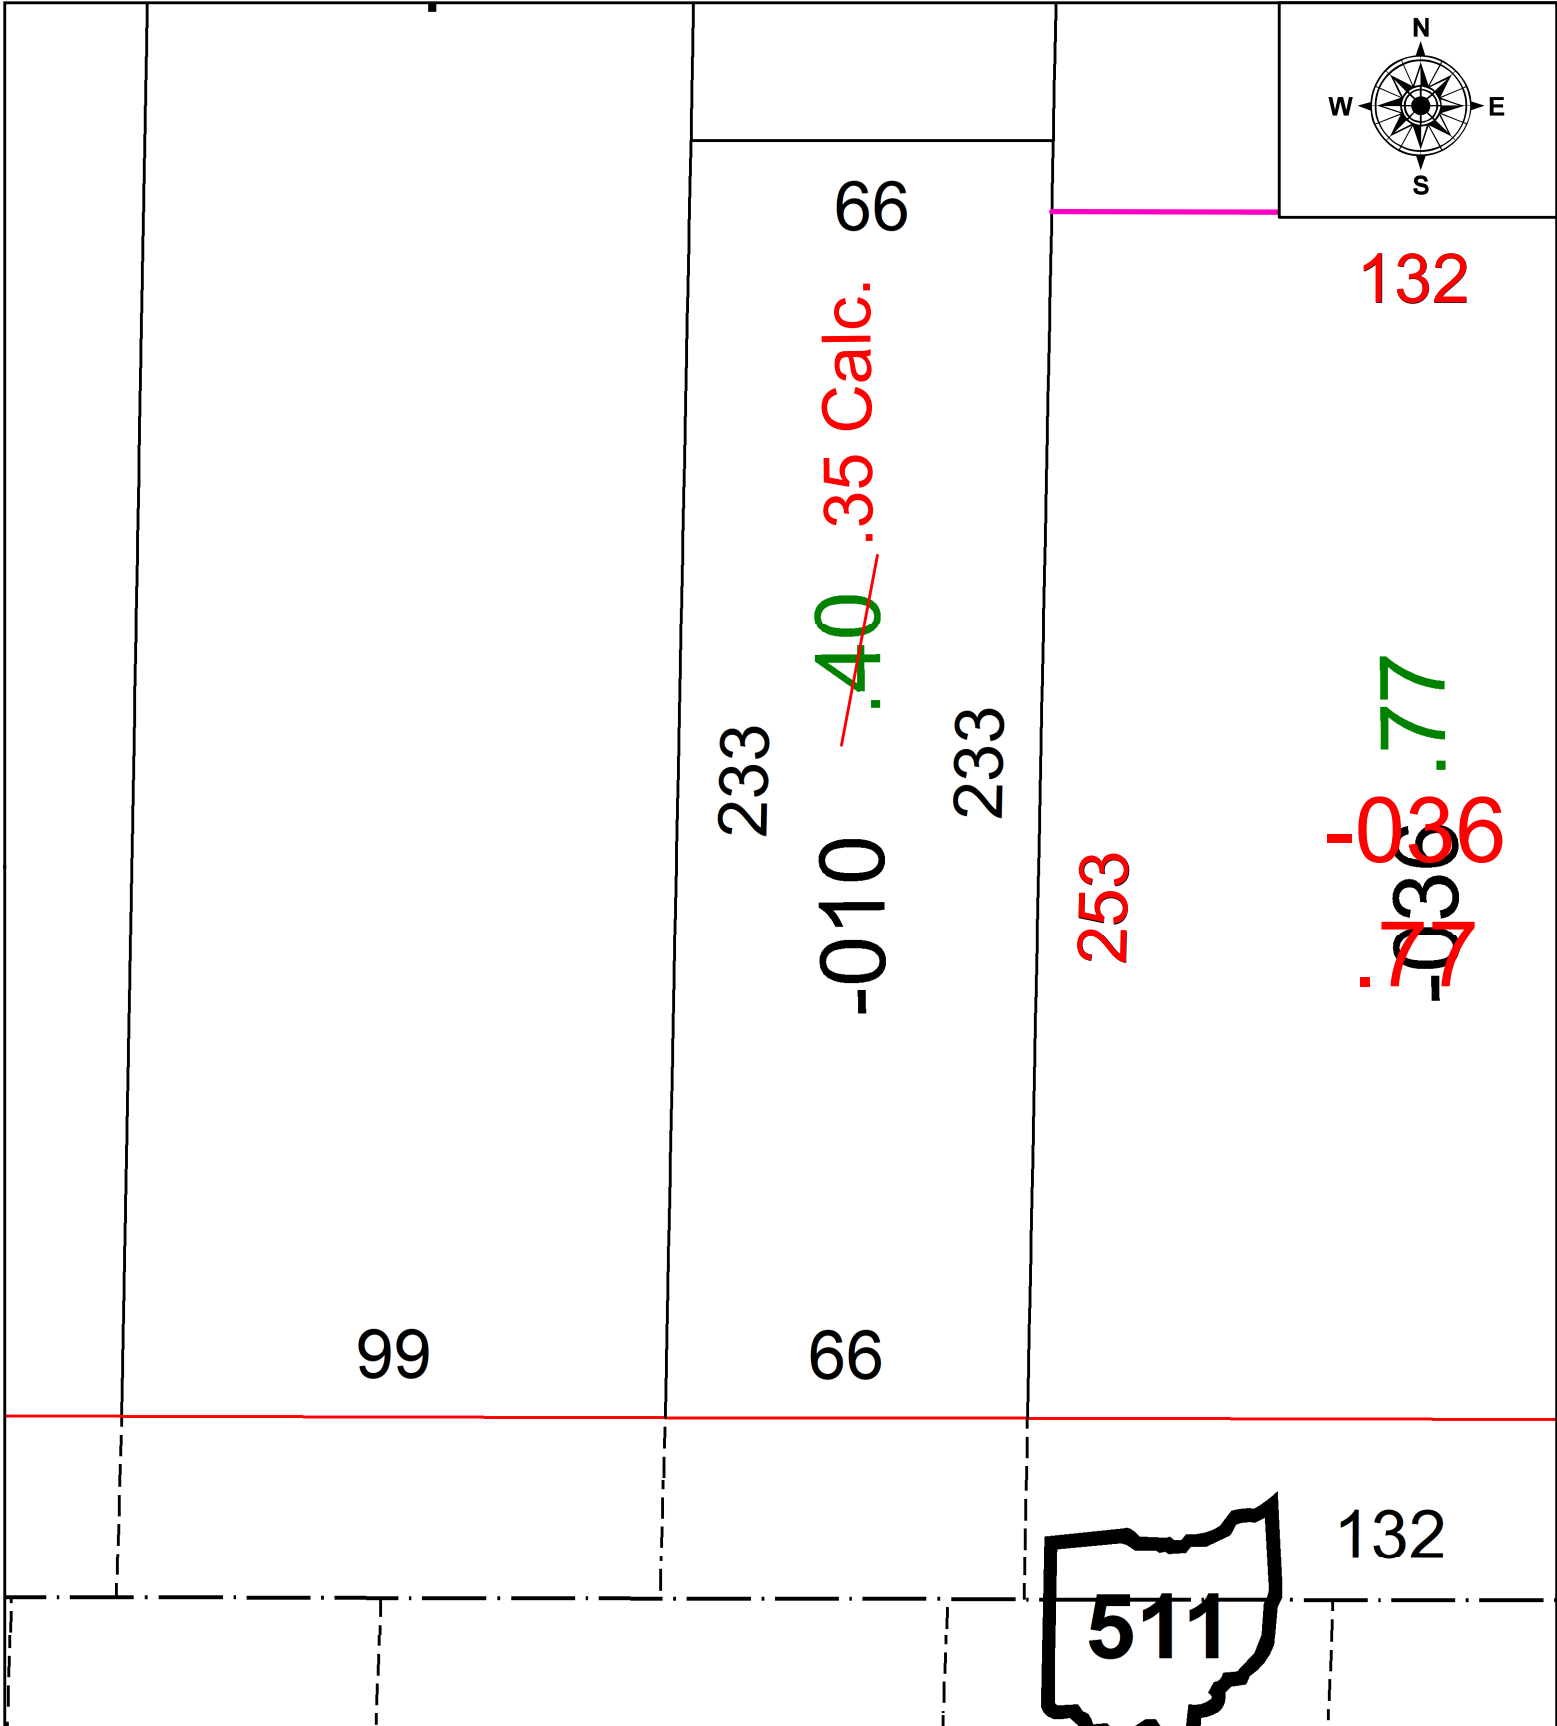

SPLITS/DEEDS PROCESSED
 LORAIN COUNTY TAX MAP DEPARTMENT
 226 MIDDLE AVE. ELYRIA, OH

SURVEYED BY: N/A SURVEY #: N/A
 CLOSURE: N/A
 MAP PAGE(S): 09-00-074
 APPROVED BY: DMA DATE: 7/9/2024
 SCALE: 1" = 35' PRIOR INSTRUMENT: N/A