


PARENT PARCEL: DROP FROM DUP. 04-00-015-110-054, 04-00-015-109-162, -164, & -170
CHILD PARCEL: ADD TO DUP. 04-00-015-900-018 THRU -020 & 04-00-015-109-173 THRU -175
STARTING POINT: PER PLAT VOL. 112 PG. 33

24-05327-A

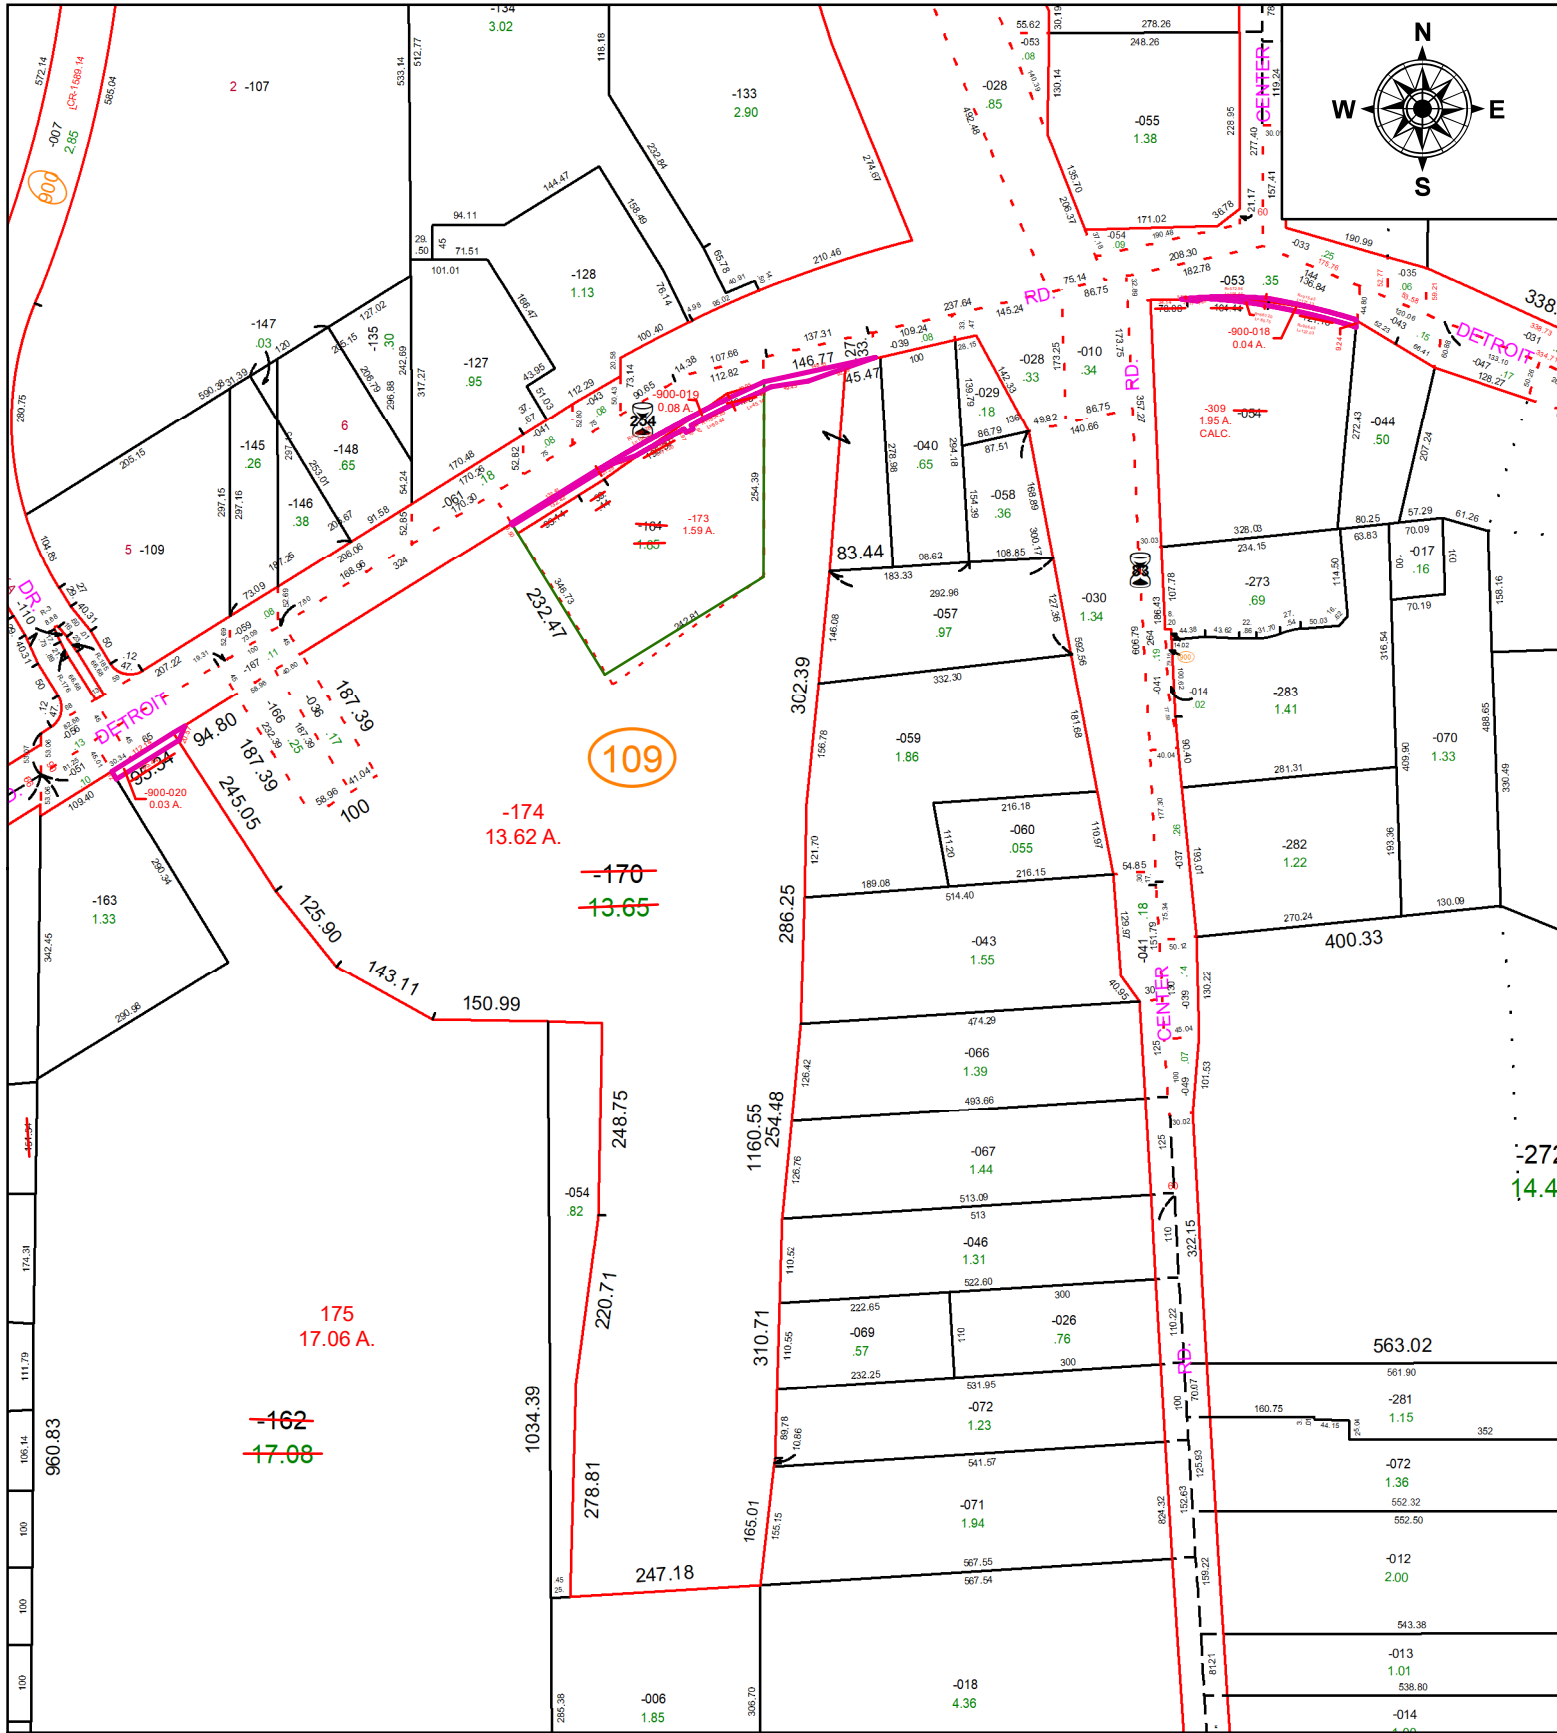

SPLITS/DEEDS PROCESSED
 LORAIN COUNTY TAX MAP DEPARTMENT
 226 MIDDLE AVE. ELYRIA, OH

SURVEYED BY: DONALD SHEEHY
CLOSURE: 1: INF
MAP PAGE(S): 04-00-015
APPROVED BY: TJS **DATE:** 7/12/2024
SCALE: 1" = 250' **PRIOR INSTRUMENT:** NA