


PARENT PARCEL: 06-24-026-103-005

CHILD PARCEL: MAP CORRECTION ONLY

24-05342-C

STARTING POINT: INTERSECTION OF C/L'S OF BELL AVE & PENFIELD AVE

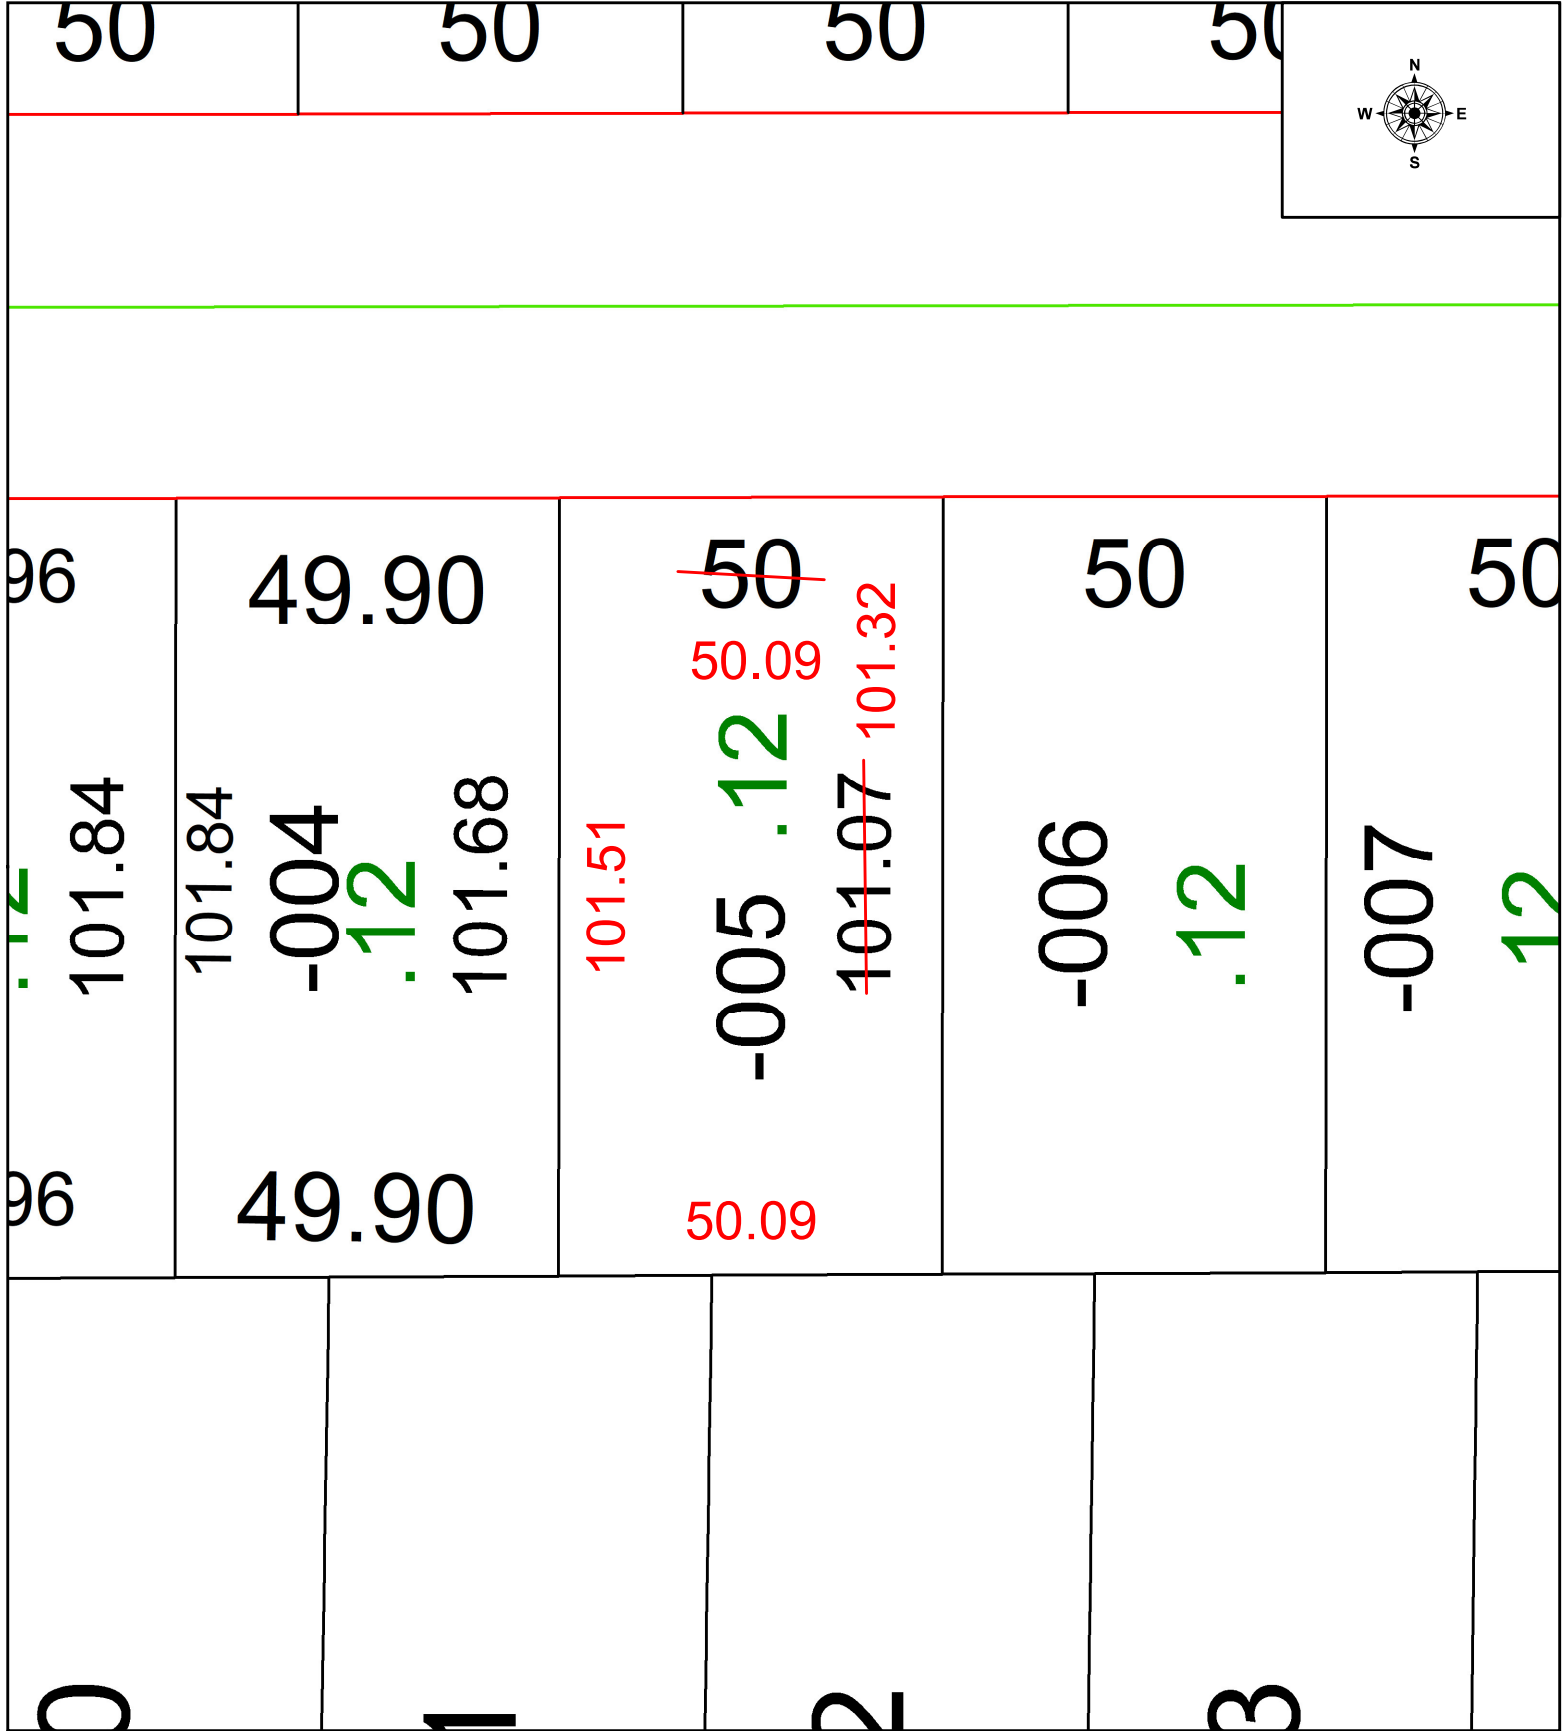

SPLITS/DEEDS PROCESSED
 LORAIN COUNTY TAX MAP DEPARTMENT
 226 MIDDLE AVE. ELYRIA, OH

SURVEYED BY: MATTHEW HILDEBRANDT SURVEY # 51247
 CLOSURE: 1: 67815
 MAP PAGE(S): 06-24-026
 APPROVED BY: WRZ DATE: 8/6/2024
 SCALE: 1" = 25' PRIOR INSTRUMENT: #2018-0685170