
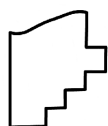


PARENT PARCEL: 04-00-011-108-017

CHILD PARCEL:

24-05347-C

STARTING POINT: AC CORR PER SURV BY J.W. WARDEN

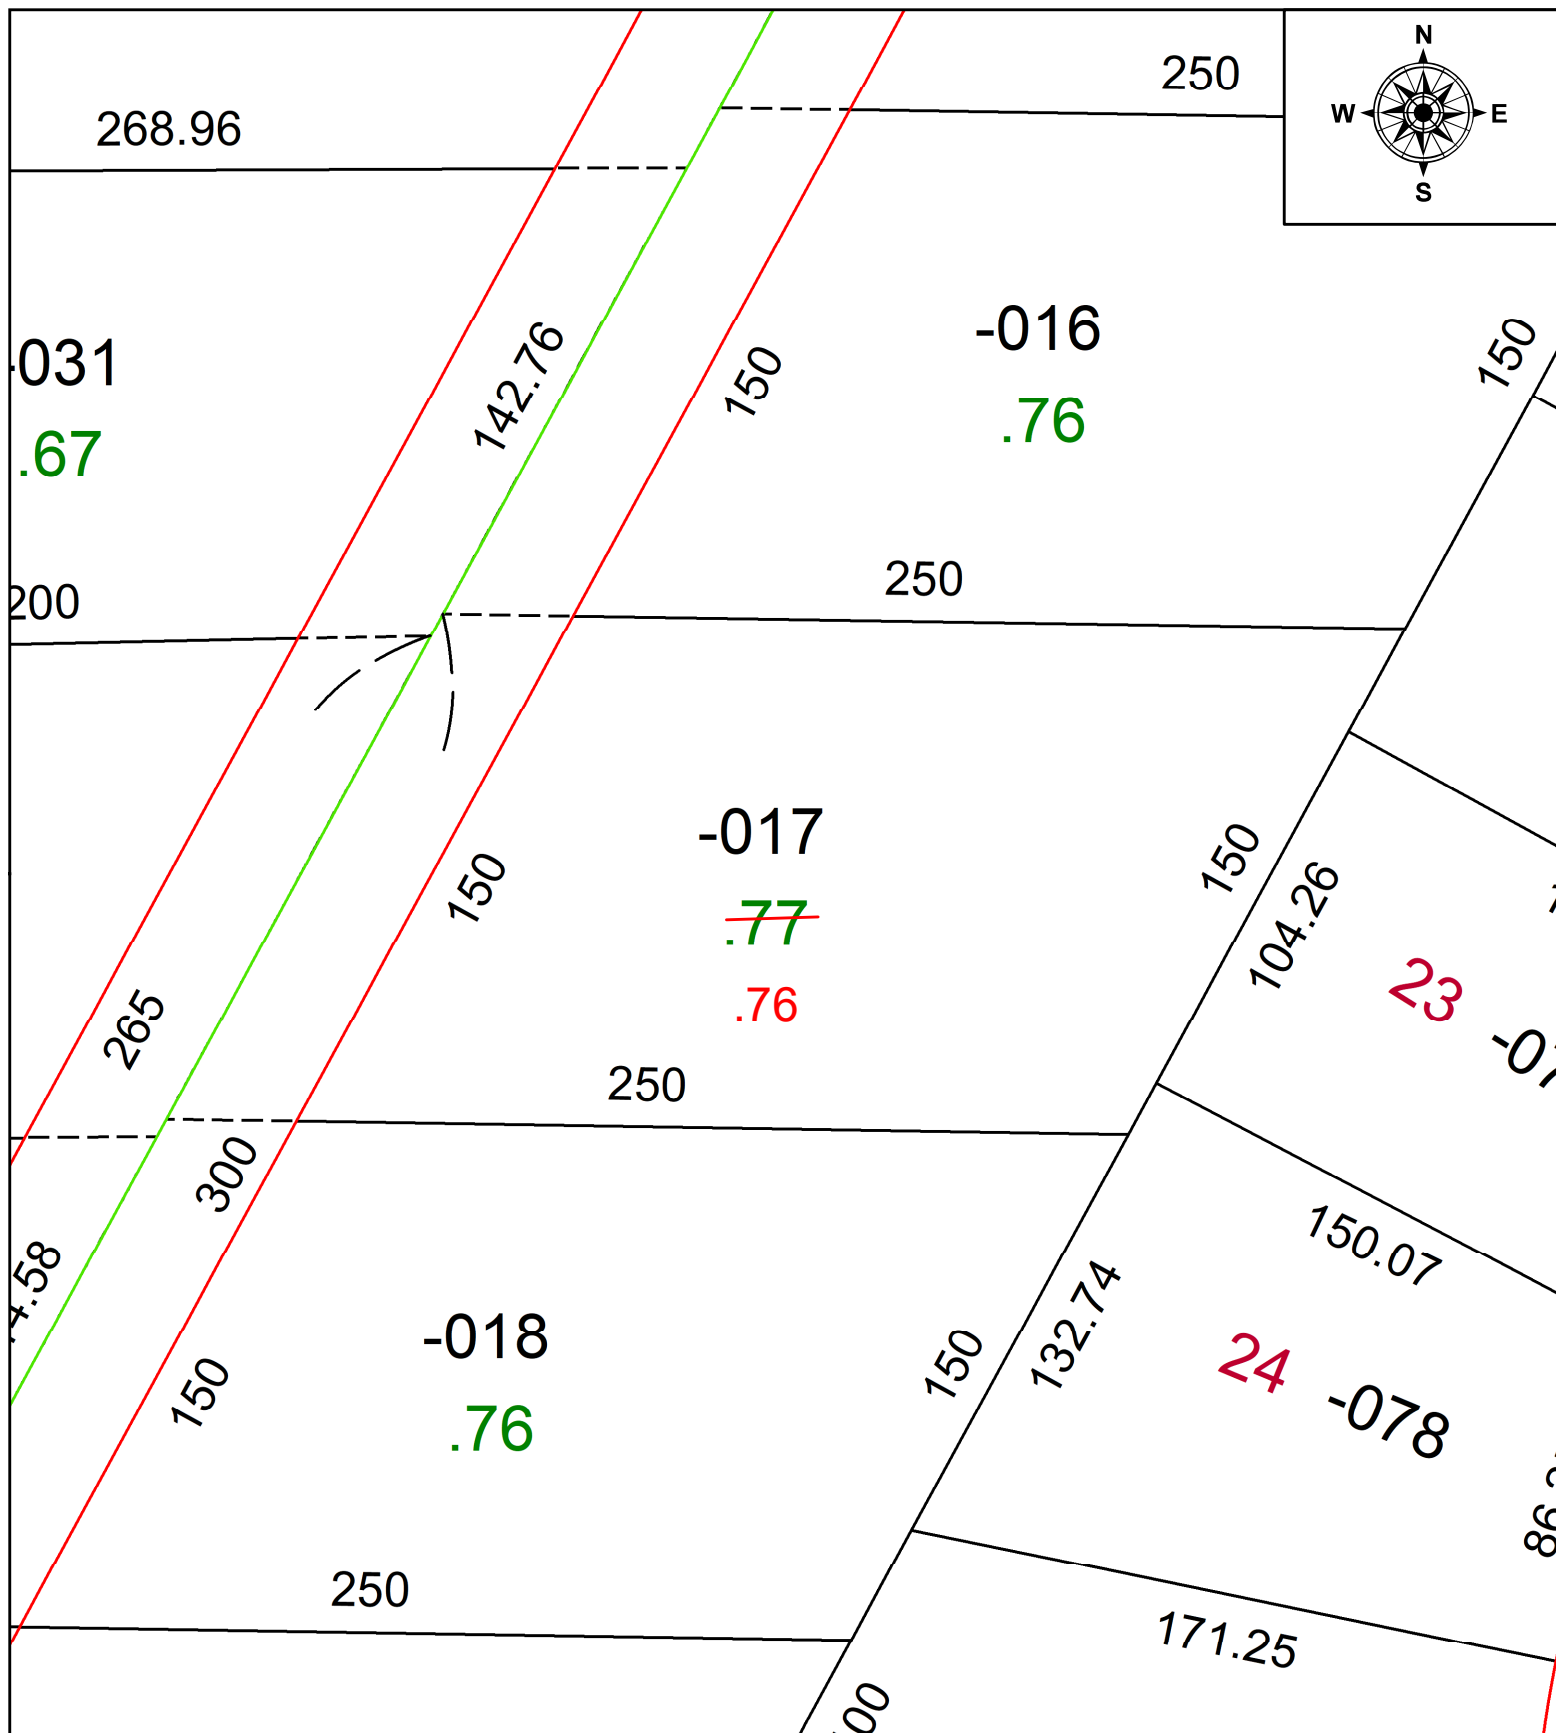

**SPLITS/DEEDS PROCESSED**  
 LORAIN COUNTY TAX MAP DEPARTMENT  
 226 MIDDLE AVE. ELYRIA, OH

SURVEYED BY: JW WARDEN SURV # N/A  
 CLOSURE: 1: 62802  
 MAP PAGE(S): 04-00-011  
 APPROVED BY: AC DATE: October 08, 2024  
 SCALE: 1 in = 50 ft PRIOR INSTRUMENT: 1980- 0066311