
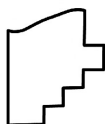
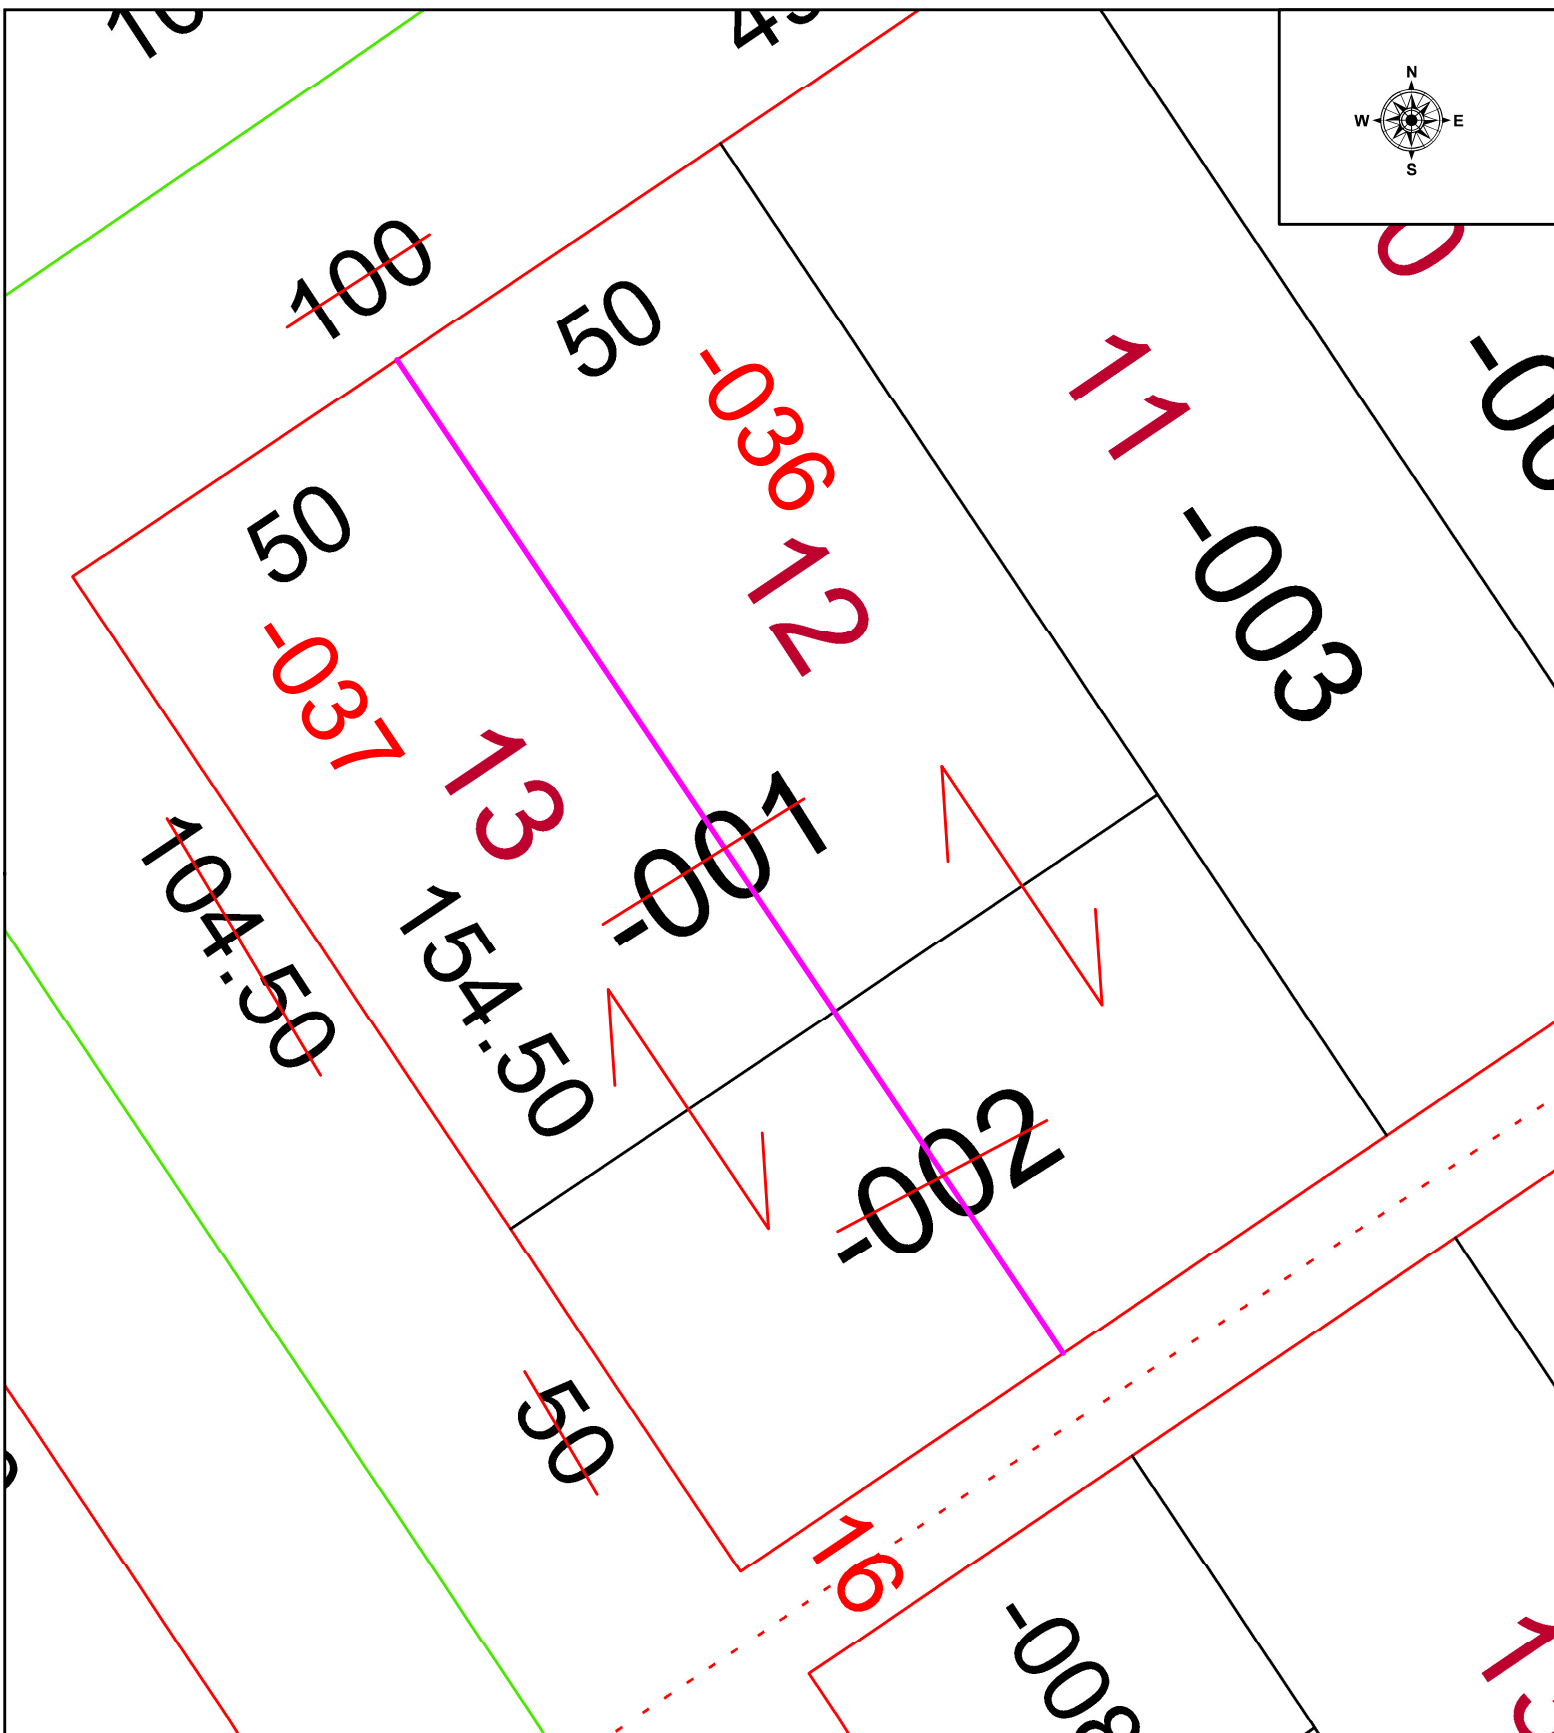


PARENT PARCEL: 02-01-004-107-001 & -002

CHILD PARCEL: 02-01-004-107-036 & -037

STARTING POINT: UNCOMBINATION PER PRIOR DEED VOL. 506, PG 172

24-05352-C

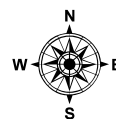

SPLITS/DEEDS PROCESSED
LORAIN COUNTY TAX MAP DEPARTMENT
226 MIDDLE AVE. ELYRIA, OH

SURVEYED BY:	N/A	SURVEY #	N/A
CLOSURE:	1: N/A		
MAP PAGE(S):		02-01-004	
APPROVED BY:	WRZ	DATE:	8/22/2024
SCALE:	1" = 25'	PRIOR INSTRUMENT:	DV 506 PG 172