
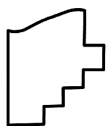
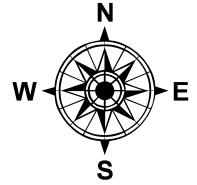


PARENT PARCEL: 04-00-030-121-090

CHILD PARCEL: 04-00-030-121-092, -093 & -094 UNCOMBINATION

STARTING POINT: N/A

24-05353-C

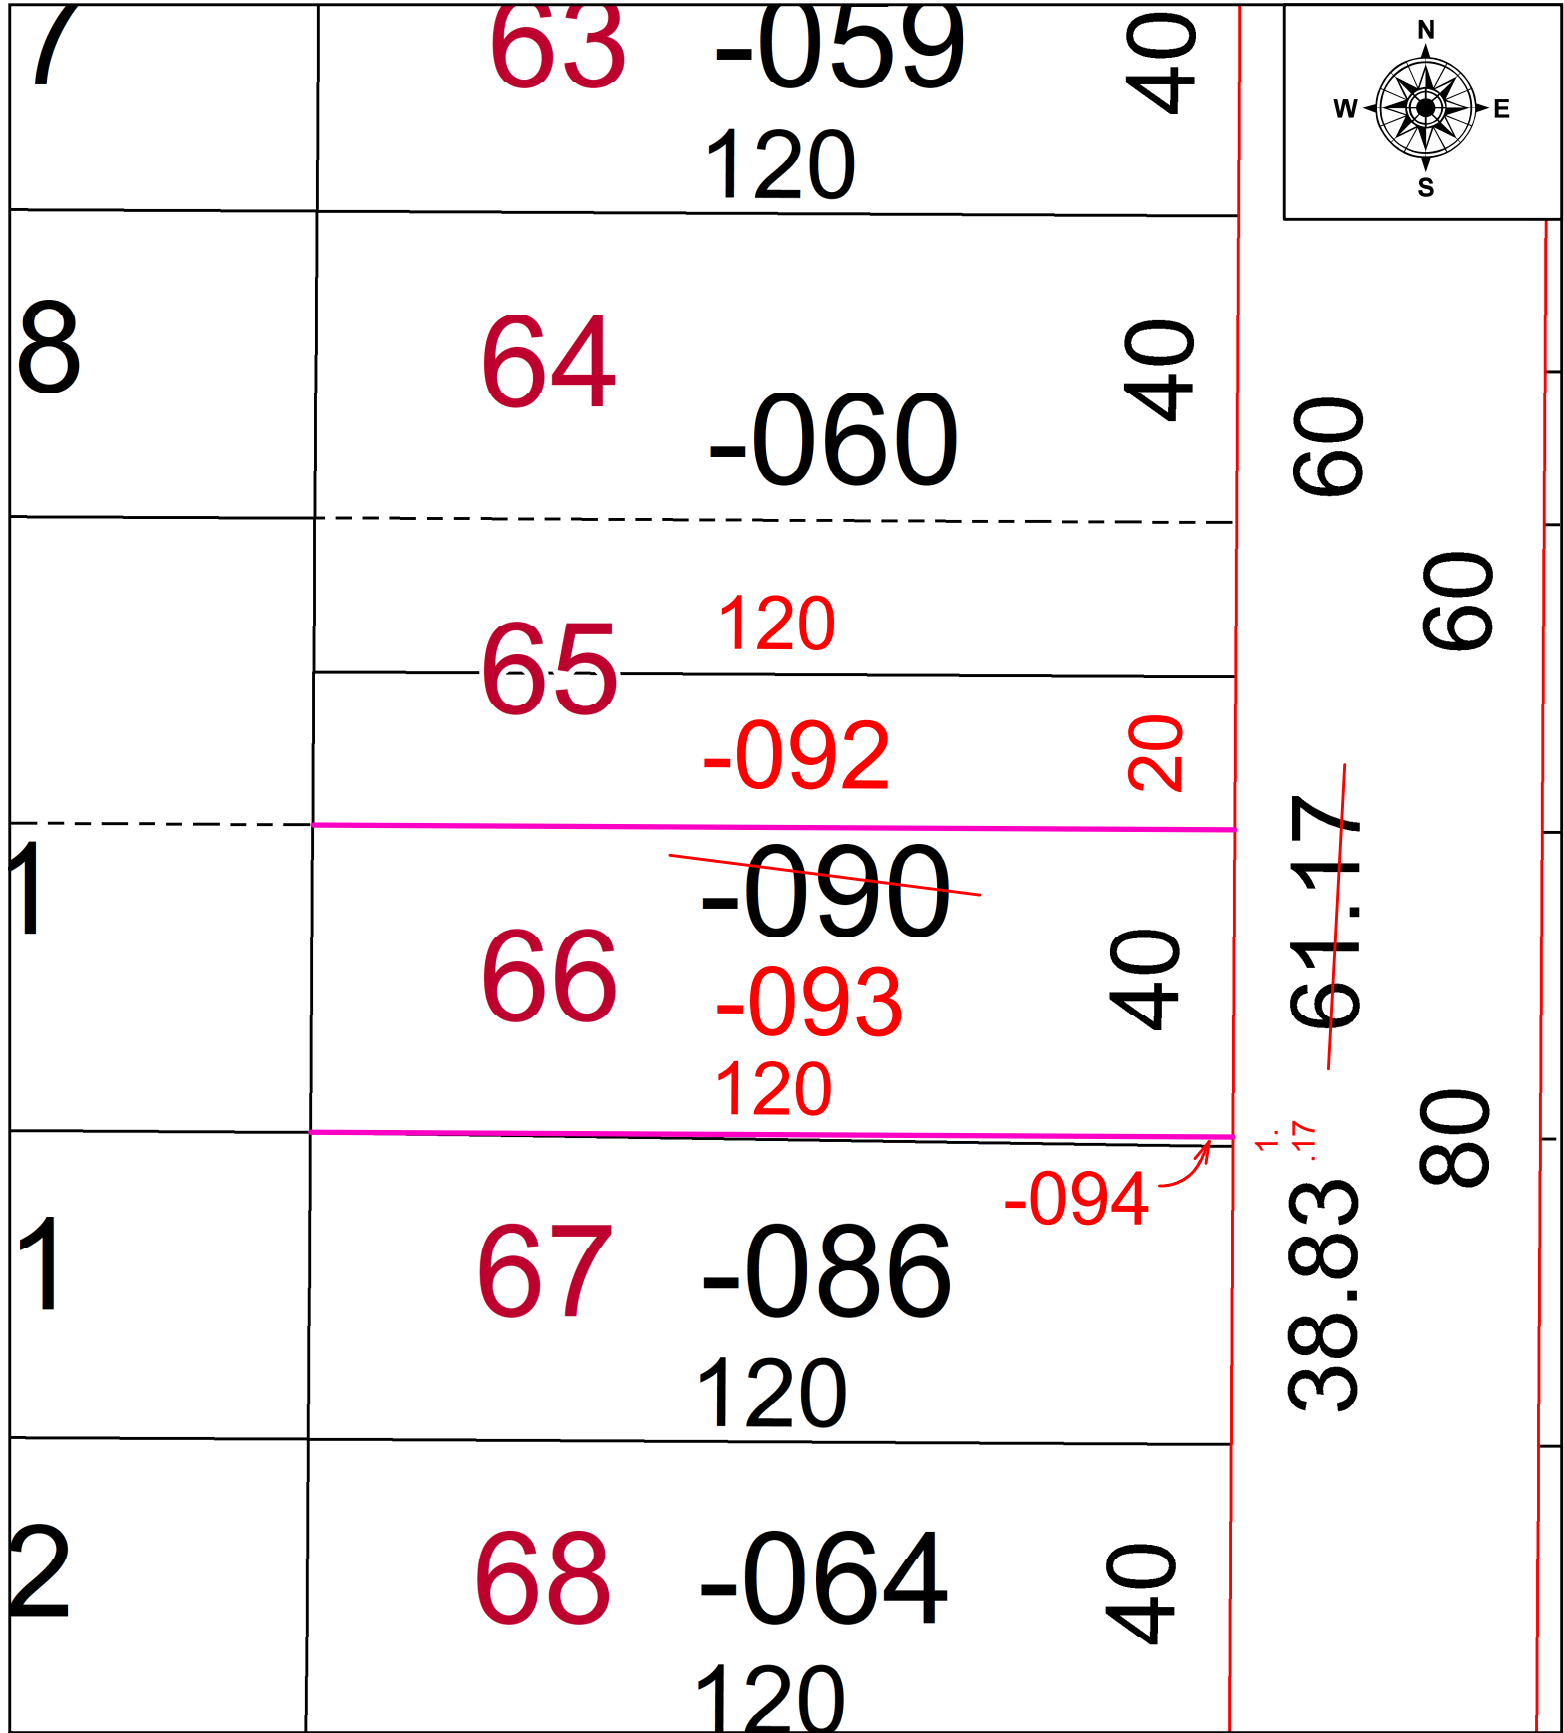

**SPLITS/DEEDS PROCESSED**  
 LORAIN COUNTY TAX MAP DEPARTMENT  
 226 MIDDLE AVE. ELYRIA, OH

SURVEYED BY: N/A SURVEY #: N/A  
 CLOSURE: N/A  
 MAP PAGE(S): 04-00-030  
 APPROVED BY: DMA DATE: 8/16/2024  
 SCALE: 1" = 25' PRIOR INSTRUMENT: 2000-0678717