
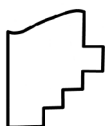
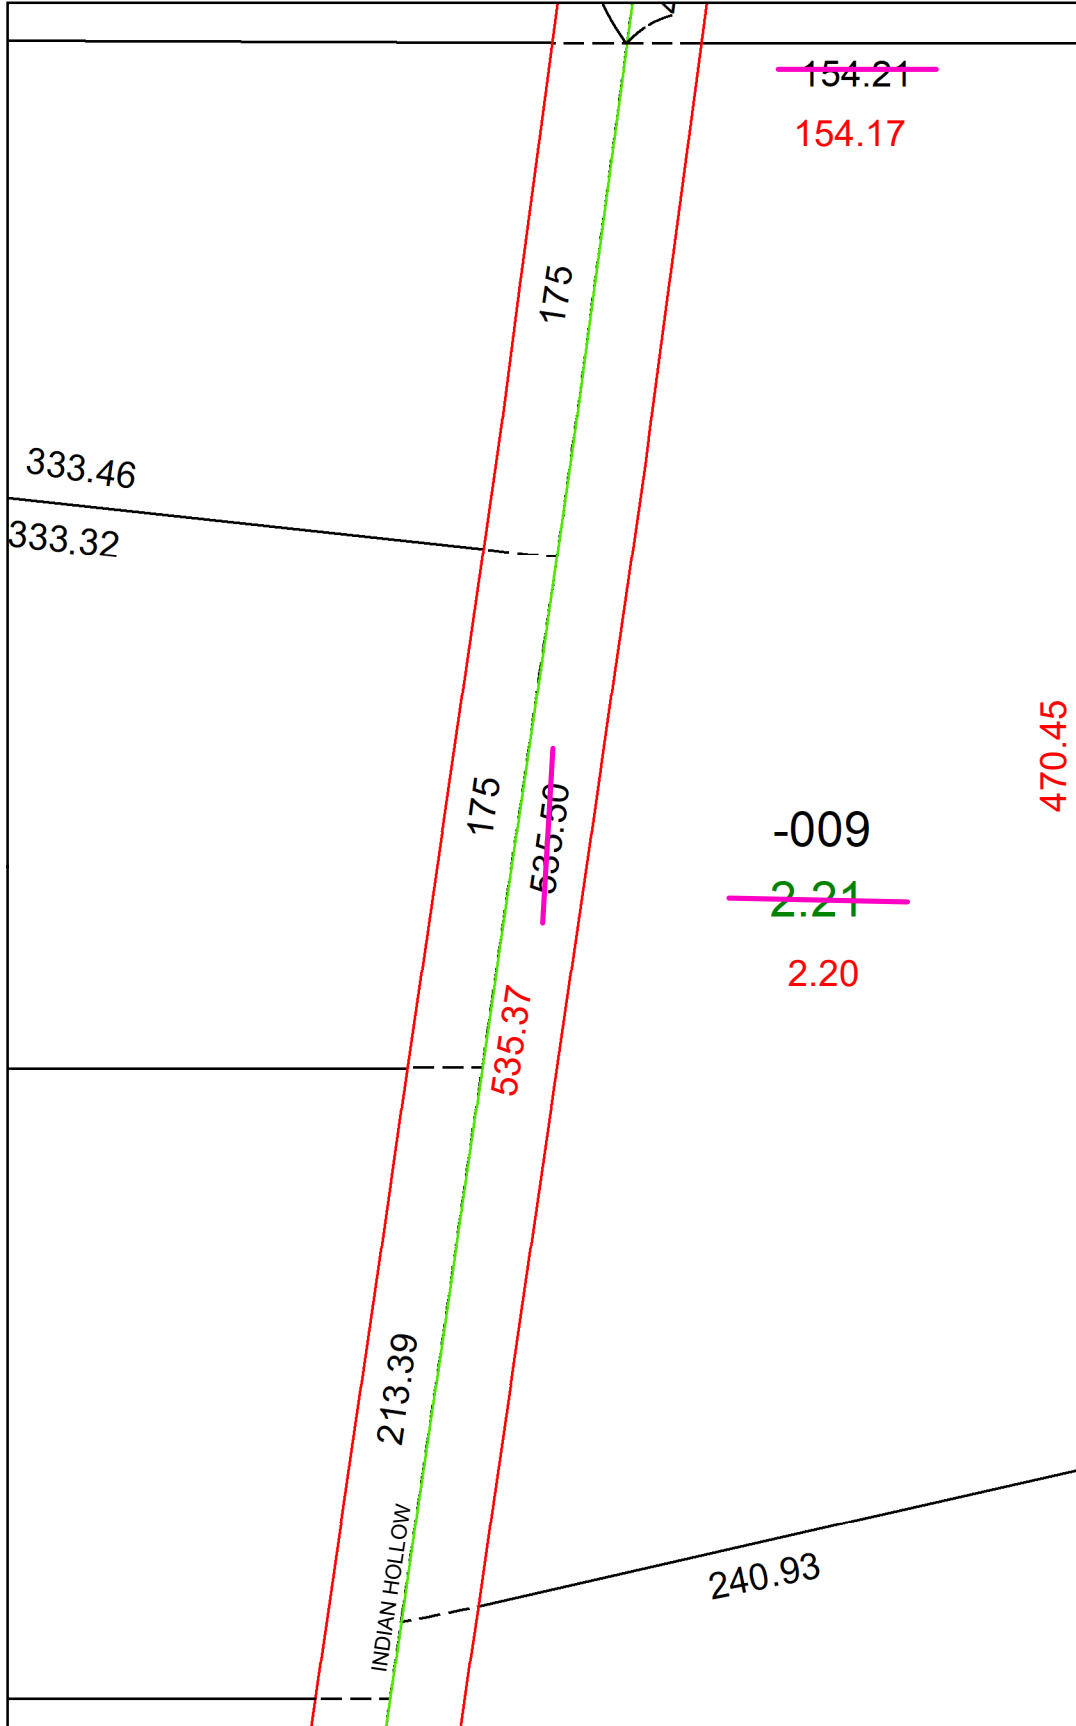


PARENT PARCEL: 15-00-029-000-009

CHILD PARCEL: ACERAGE CORR PER SURVEY

STARTING POINT: C/Ls OF BIGGS RD AND INDIAN HOLLOW RD

24-05360-C

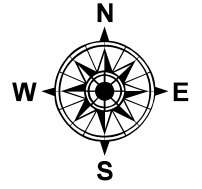

SPLITS/DEEDS PROCESSED
 LORAIN COUNTY TAX MAP DEPARTMENT
 226 MIDDLE AVE. ELYRIA, OH

SURVEYED BY: MICHAEL R. SHELESTOVICH **SURVEY #:** 51264
CLOSURE: 1:213174
MAP PAGE(S): 1500029
APPROVED BY: BB **DATE:** 9/3/2024
SCALE: 1" = 65' **PRIOR INSTRUMENT:** #20180683664