
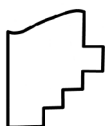


PARENT PARCEL: VACATION ORD. # 2024-94

CHILD PARCEL: NA

STARTING POINT: I.P. MON. BOX, CL OF ELYRIA-TWINSBURG RD. (S.R. 82) & CL OF ISLAND RD.

24-05368-V

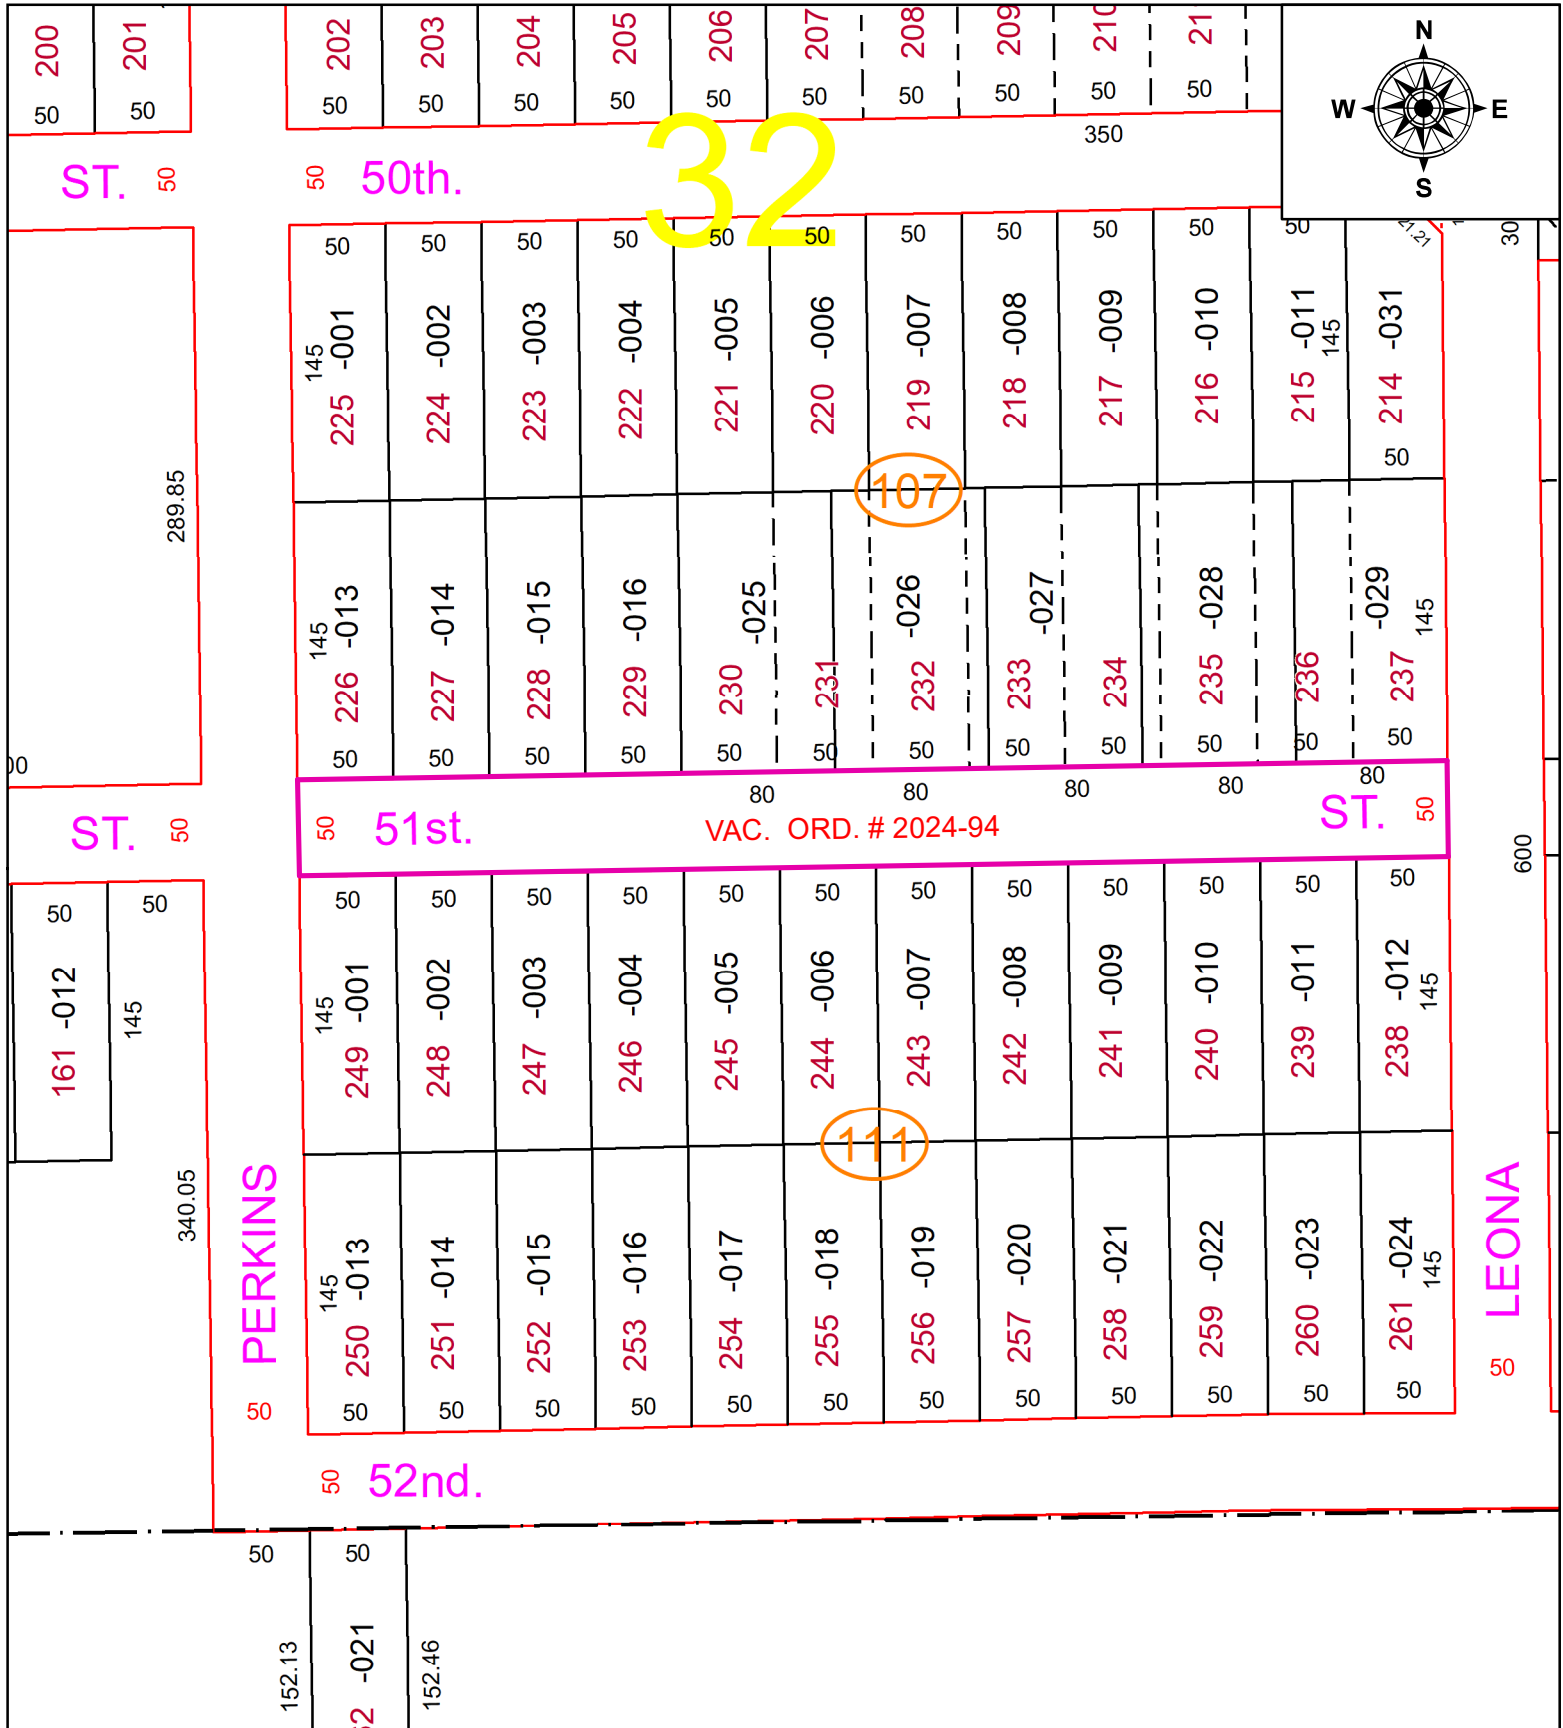

SPLITS/DEEDS PROCESSED
 LORAIN COUNTY TAX MAP DEPARTMENT
 226 MIDDLE AVE. ELYRIA, OH

SURVEYED BY: B. SIEBENTHAL
 CLOSURE: 1: INF
 MAP PAGE(S): 06-24-032
 APPROVED BY: TJS DATE: 9/18/2024
 SCALE: 1" = 100' PRIOR INSTRUMENT: NA