
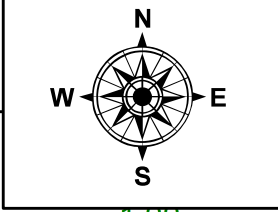


PARENT PARCEL: 01-00-037-102-029

CHILD PARCEL: **AC CORR PER PRIOR INSTRUMENT NO. 2008- 0251047**

24-05369-C

STARTING POINT: SE CORNER OF O/L 37

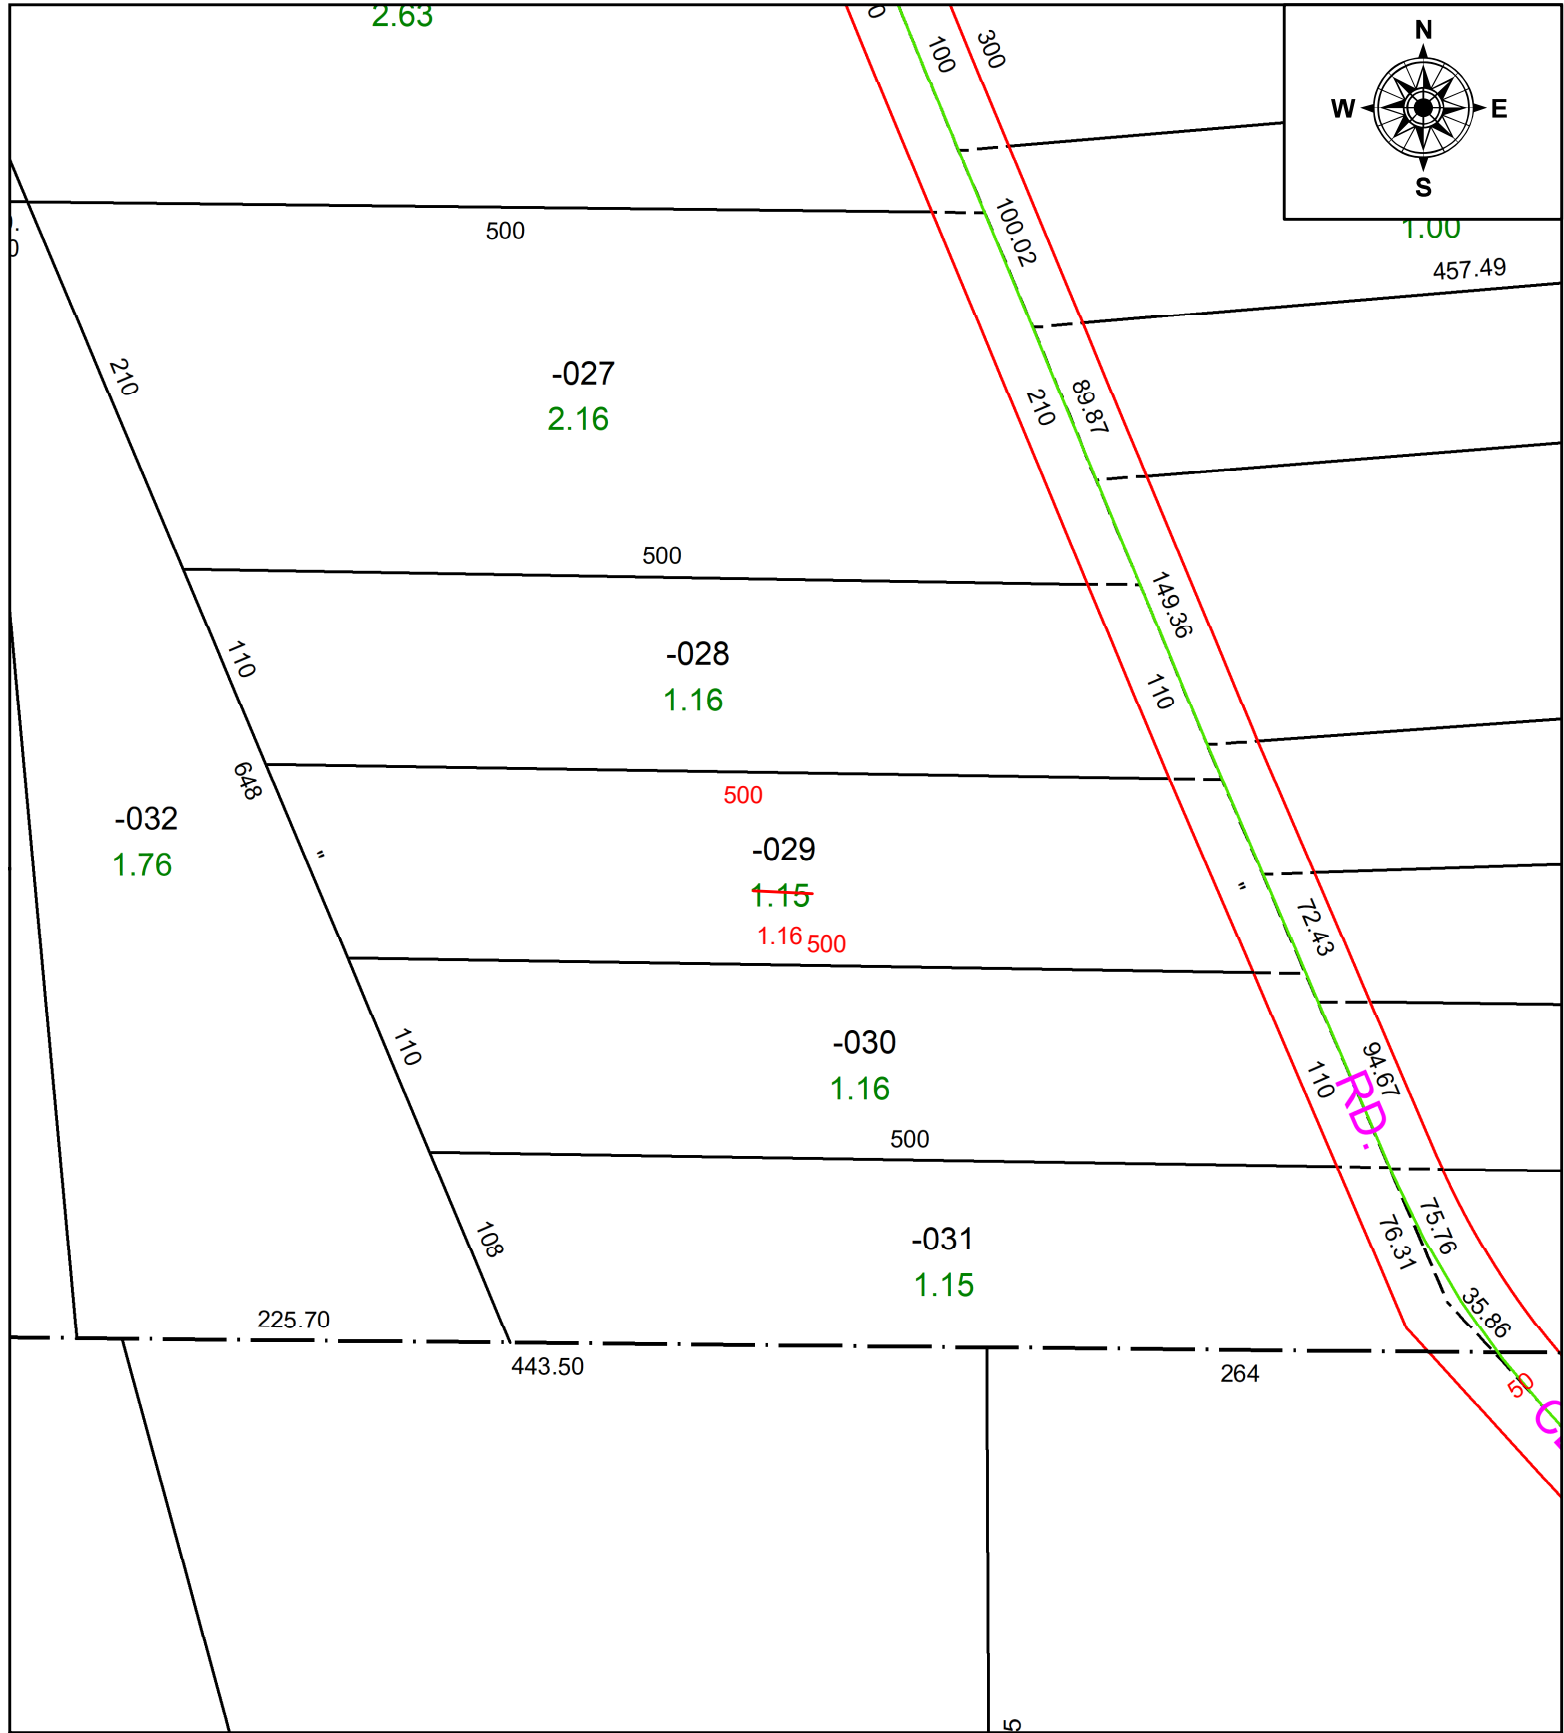

SPLITS/DEEDS PROCESSED
 LORAIN COUNTY TAX MAP DEPARTMENT
 226 MIDDLE AVE. ELYRIA, OH

SURVEYED BY: ARNOLD KOEPP SURV # N/A
 CLOSURE: 1: 100789
 MAP PAGE(S): 01-00-037
 APPROVED BY: AC DATE: September 18, 2024
 SCALE: 1 in = 100 ft PRIOR INSTRUMENT: 2008- 0251047