
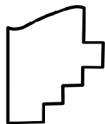
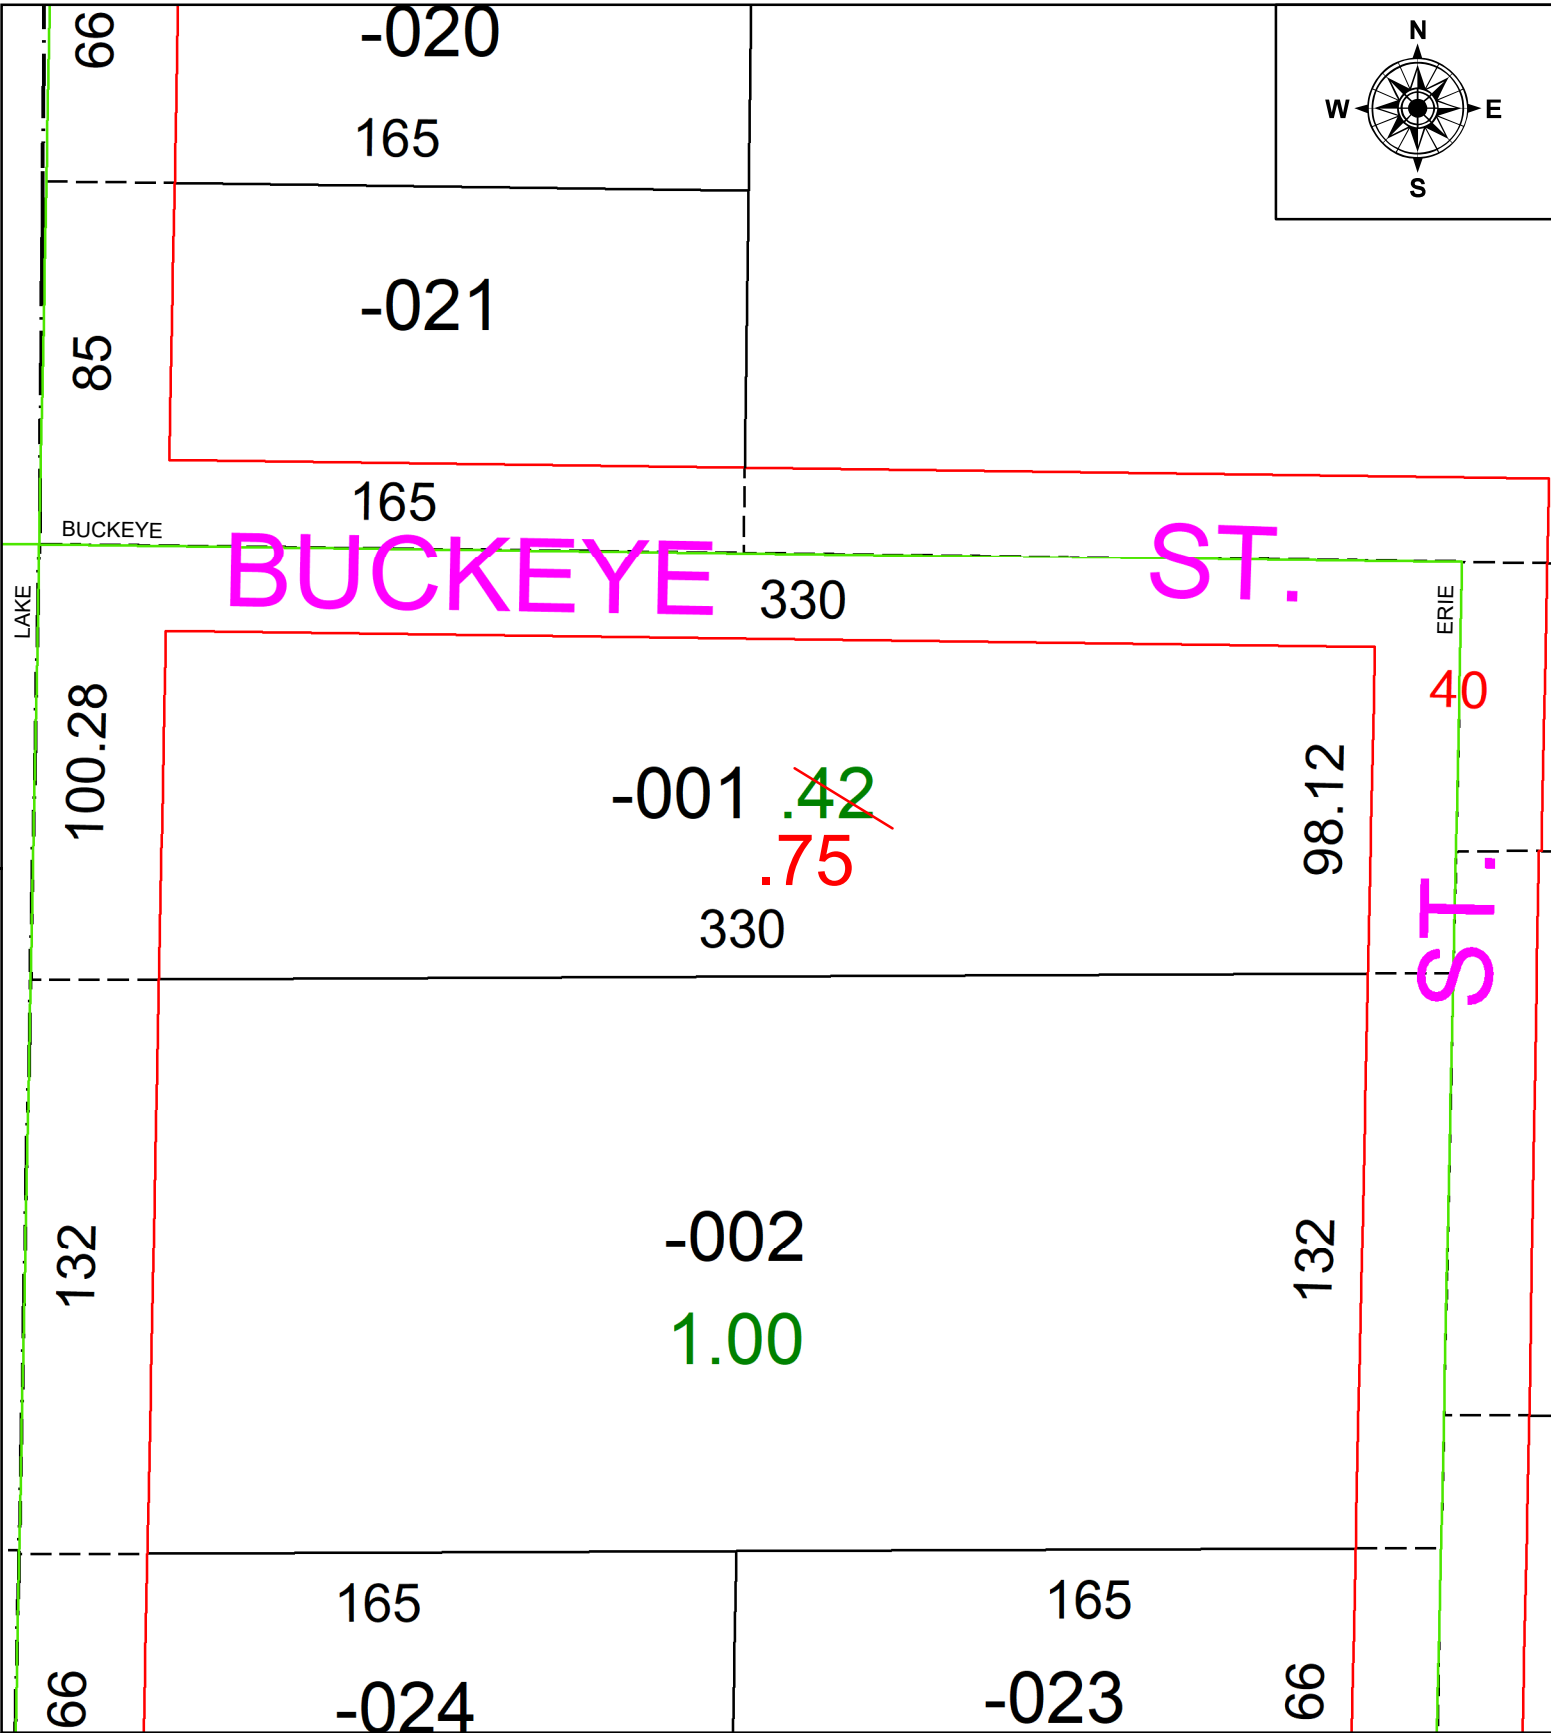


PARENT PARCEL: 05-00-012-102-001

CHILD PARCEL: AC CORR PER SURVEY

STARTING POINT: INTERSECTION C/L North MAIN STREET & BUCKEYE STREET

24-05370-C

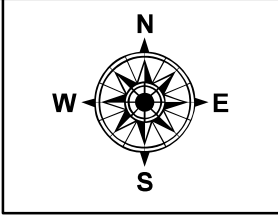

**SPLITS/DEEDS PROCESSED**  
LORAIN COUNTY TAX MAP DEPARTMENT  
226 MIDDLE AVE. ELYRIA, OH

SURVEYED BY: PATRICK A. MCGANNON SURVEY #: 51278  
CLOSURE: 1:3984062  
MAP PAGE(S): 0500012  
APPROVED BY: BB DATE: 9/20/2024  
SCALE: 1" = 45' PRIOR INSTRUMENT: #20240024248