
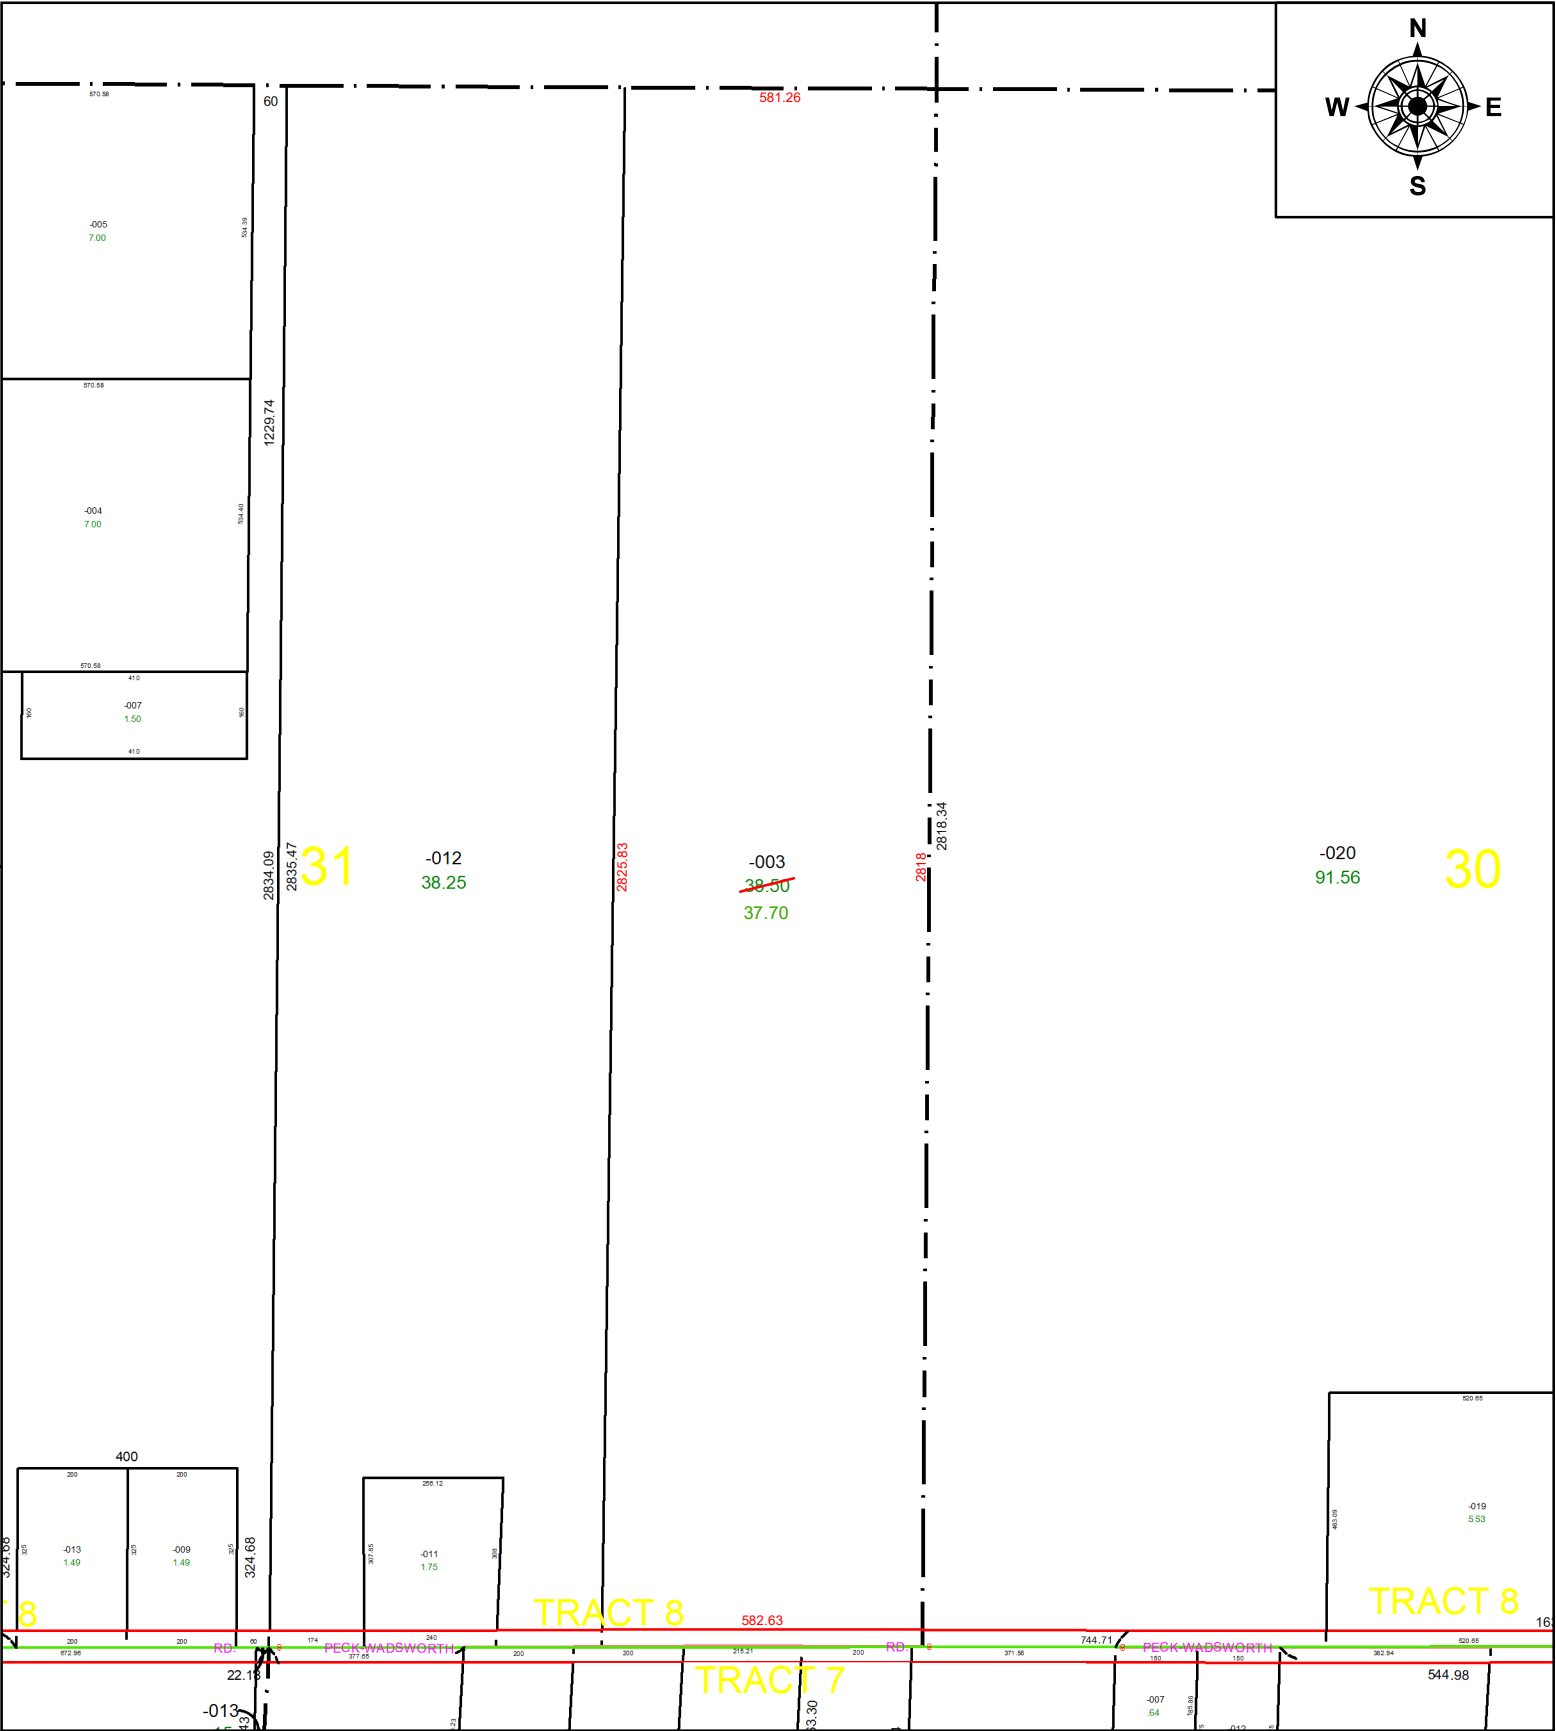


PARENT PARCEL: 17-08-031-000-003

CHILD PARCEL: AC CORR PER SURVEYOR AARON L. GERBER

STARTING POINT: NORTHEAST CORNER OF ORIGINAL LOT 31

24-05377-C

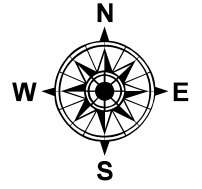

31

-012
38.25

-003
~~38.50~~
37.70


-020
91.56

30

TRACT 8

TRACT 7

TRACT 8

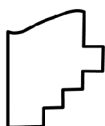

SPLITS/DEEDS PROCESSED
LORAIN COUNTY TAX MAP DEPARTMENT
226 MIDDLE AVE. ELYRIA, OH

SURVEYED BY: AARON L. GERBER SURVEY #: 51289
CLOSURE: 1:968135
MAP PAGE(S): 1708031
APPROVED BY: BB DATE: 9/30/2024
SCALE: 1" = 350' PRIOR INSTRUMENT: #20230936671