
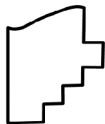


PARENT PARCEL: 04-00-026-103-016

CHILD PARCEL: AC CORRECTION PER SURVEYOR KYLE R. DANALS

24-05379-C

STARTING POINT: C/Ls NAGEL RD AND HAWKESBURY COURT ST

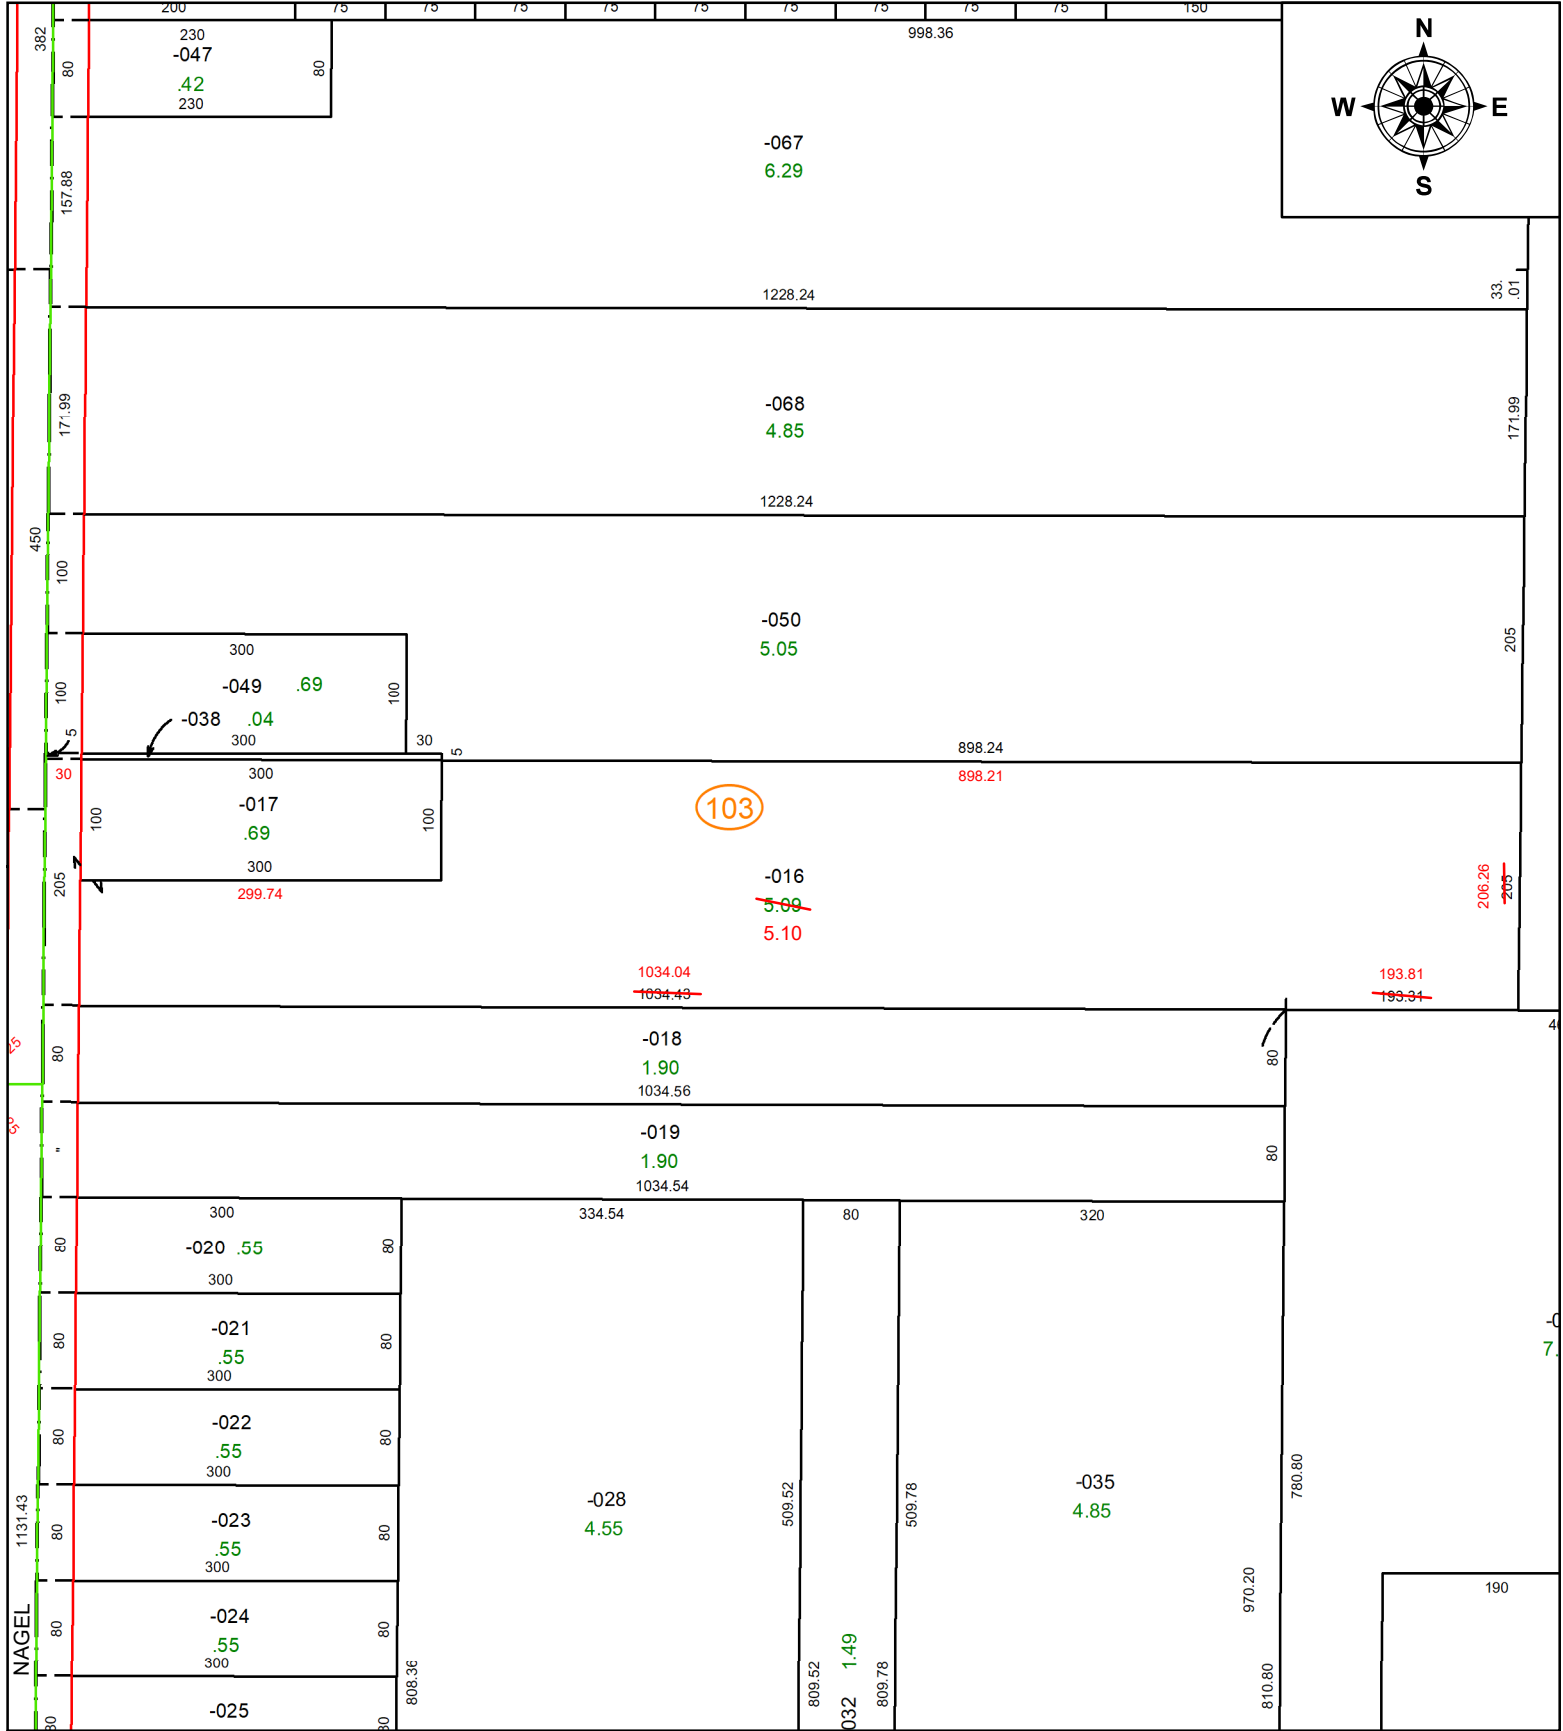

SPLITS/DEEDS PROCESSED
 LORAIN COUNTY TAX MAP DEPARTMENT
 226 MIDDLE AVE. ELYRIA, OH

SURVEYED BY: KYLE R. DANALS **SURVEY #:** 51310
CLOSURE: I:608296
MAP PAGE(S): 0400026
APPROVED BY: BB **DATE:** 10/29/2024
SCALE: 1" = 160' **PRIOR INSTRUMENT:** #20180698393