
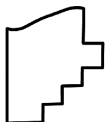
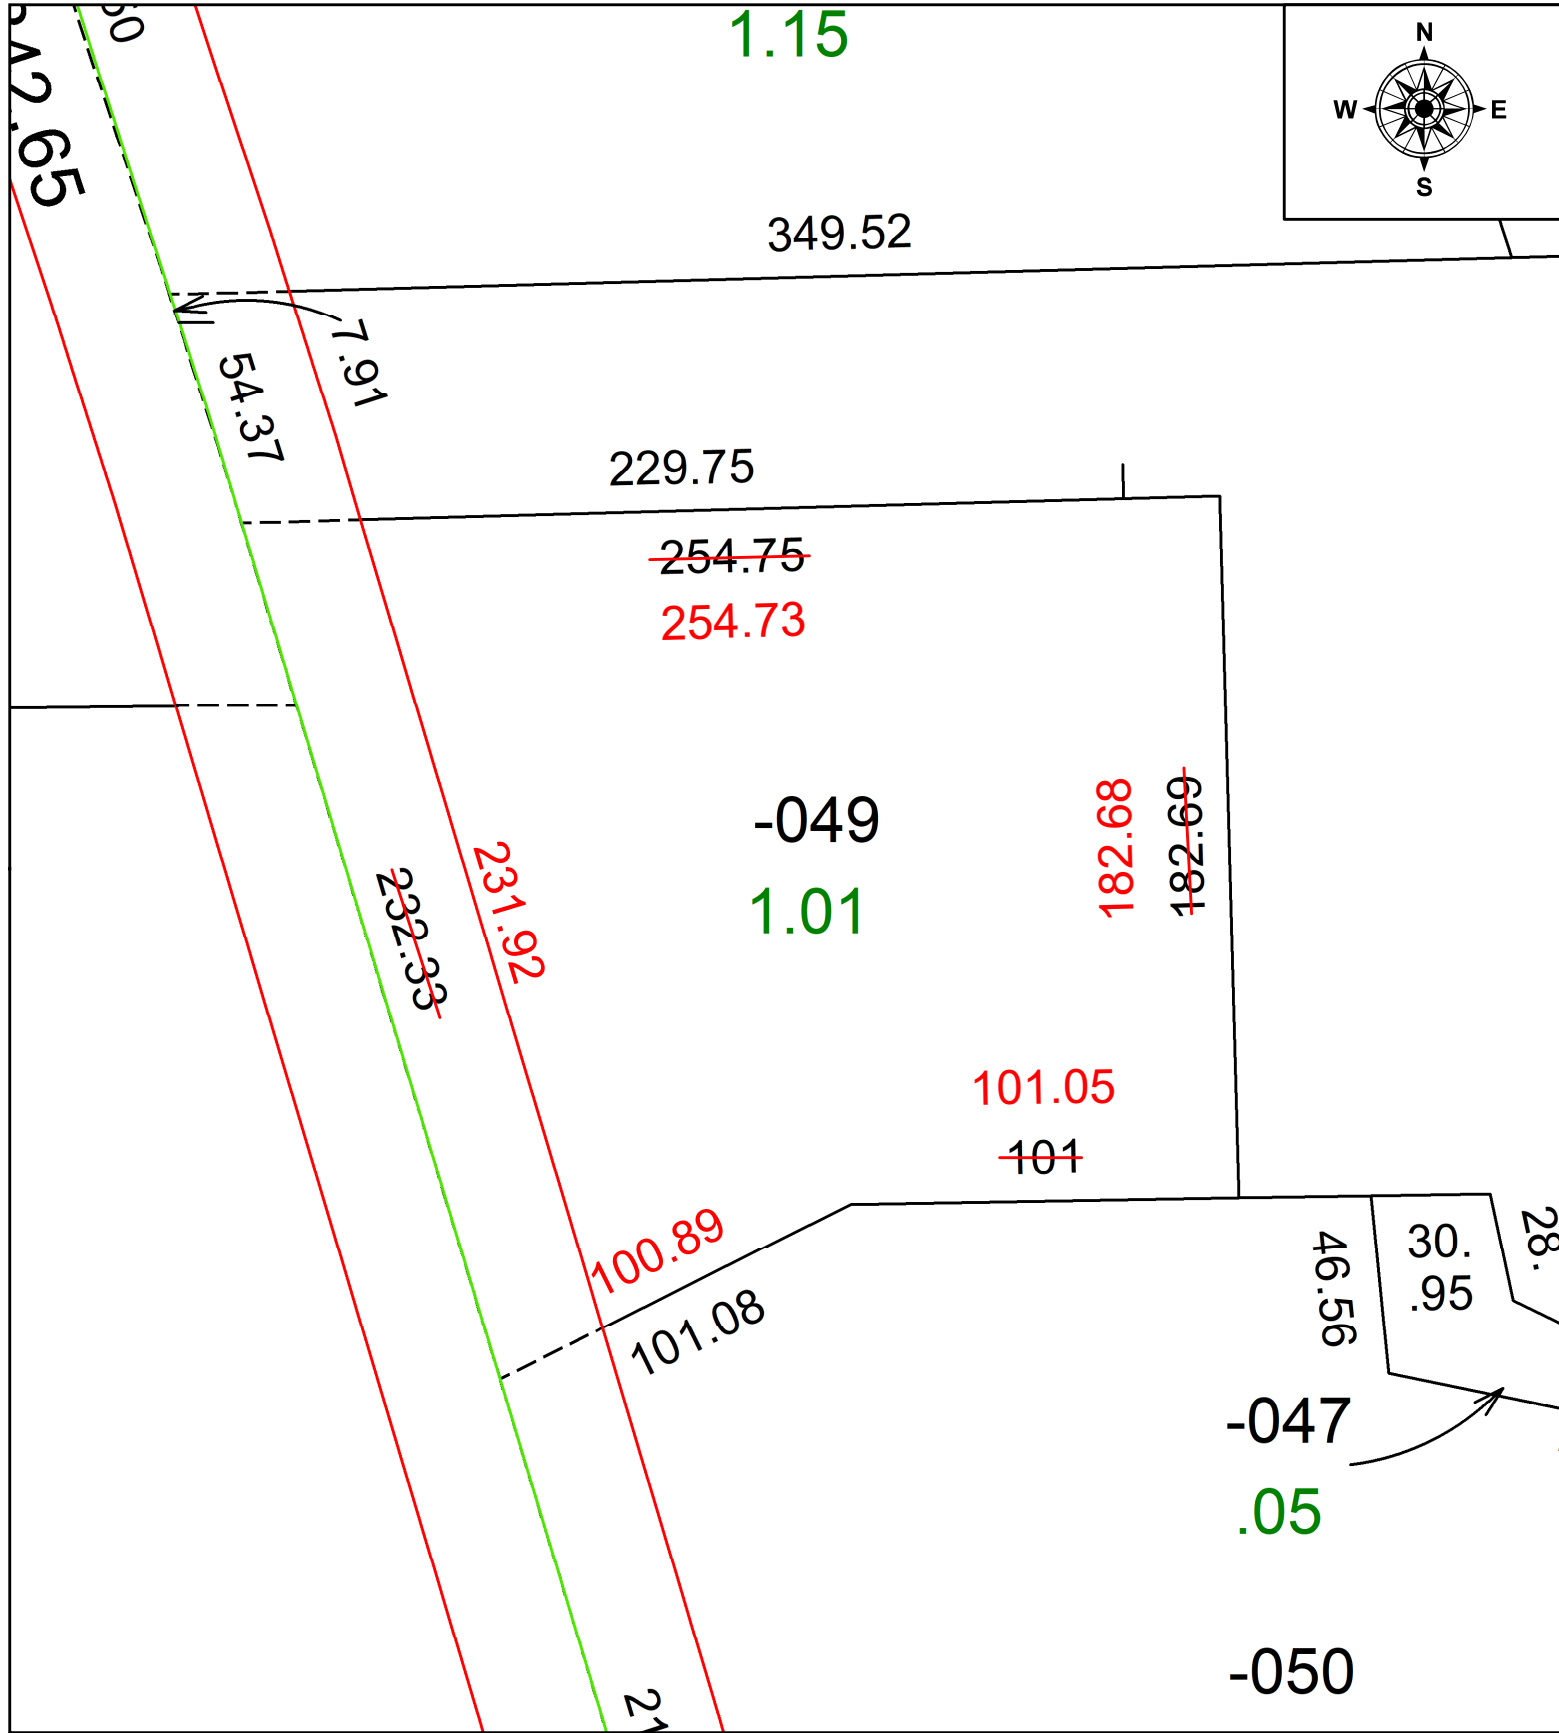


PARENT PARCEL: 07-00-045-110-049

CHILD PARCEL: **MAP CORRECTION ONLY**

STARTING POINT: C/L OF CASE AND OTTEN RD

24-05392-C

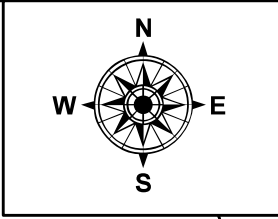

SPLITS/DEEDS PROCESSED
LORAIN COUNTY TAX MAP DEPARTMENT
226 MIDDLE AVE. ELYRIA, OH

SURVEYED BY: ROBERT M. RUFFING SURV # 51306
CLOSURE: 1: 183850
MAP PAGE(S): 07-00-045
APPROVED BY: AC DATE: October 28, 2024
SCALE: 1 in = 50 ft PRIOR INSTRUMENT: 2016-0579808