
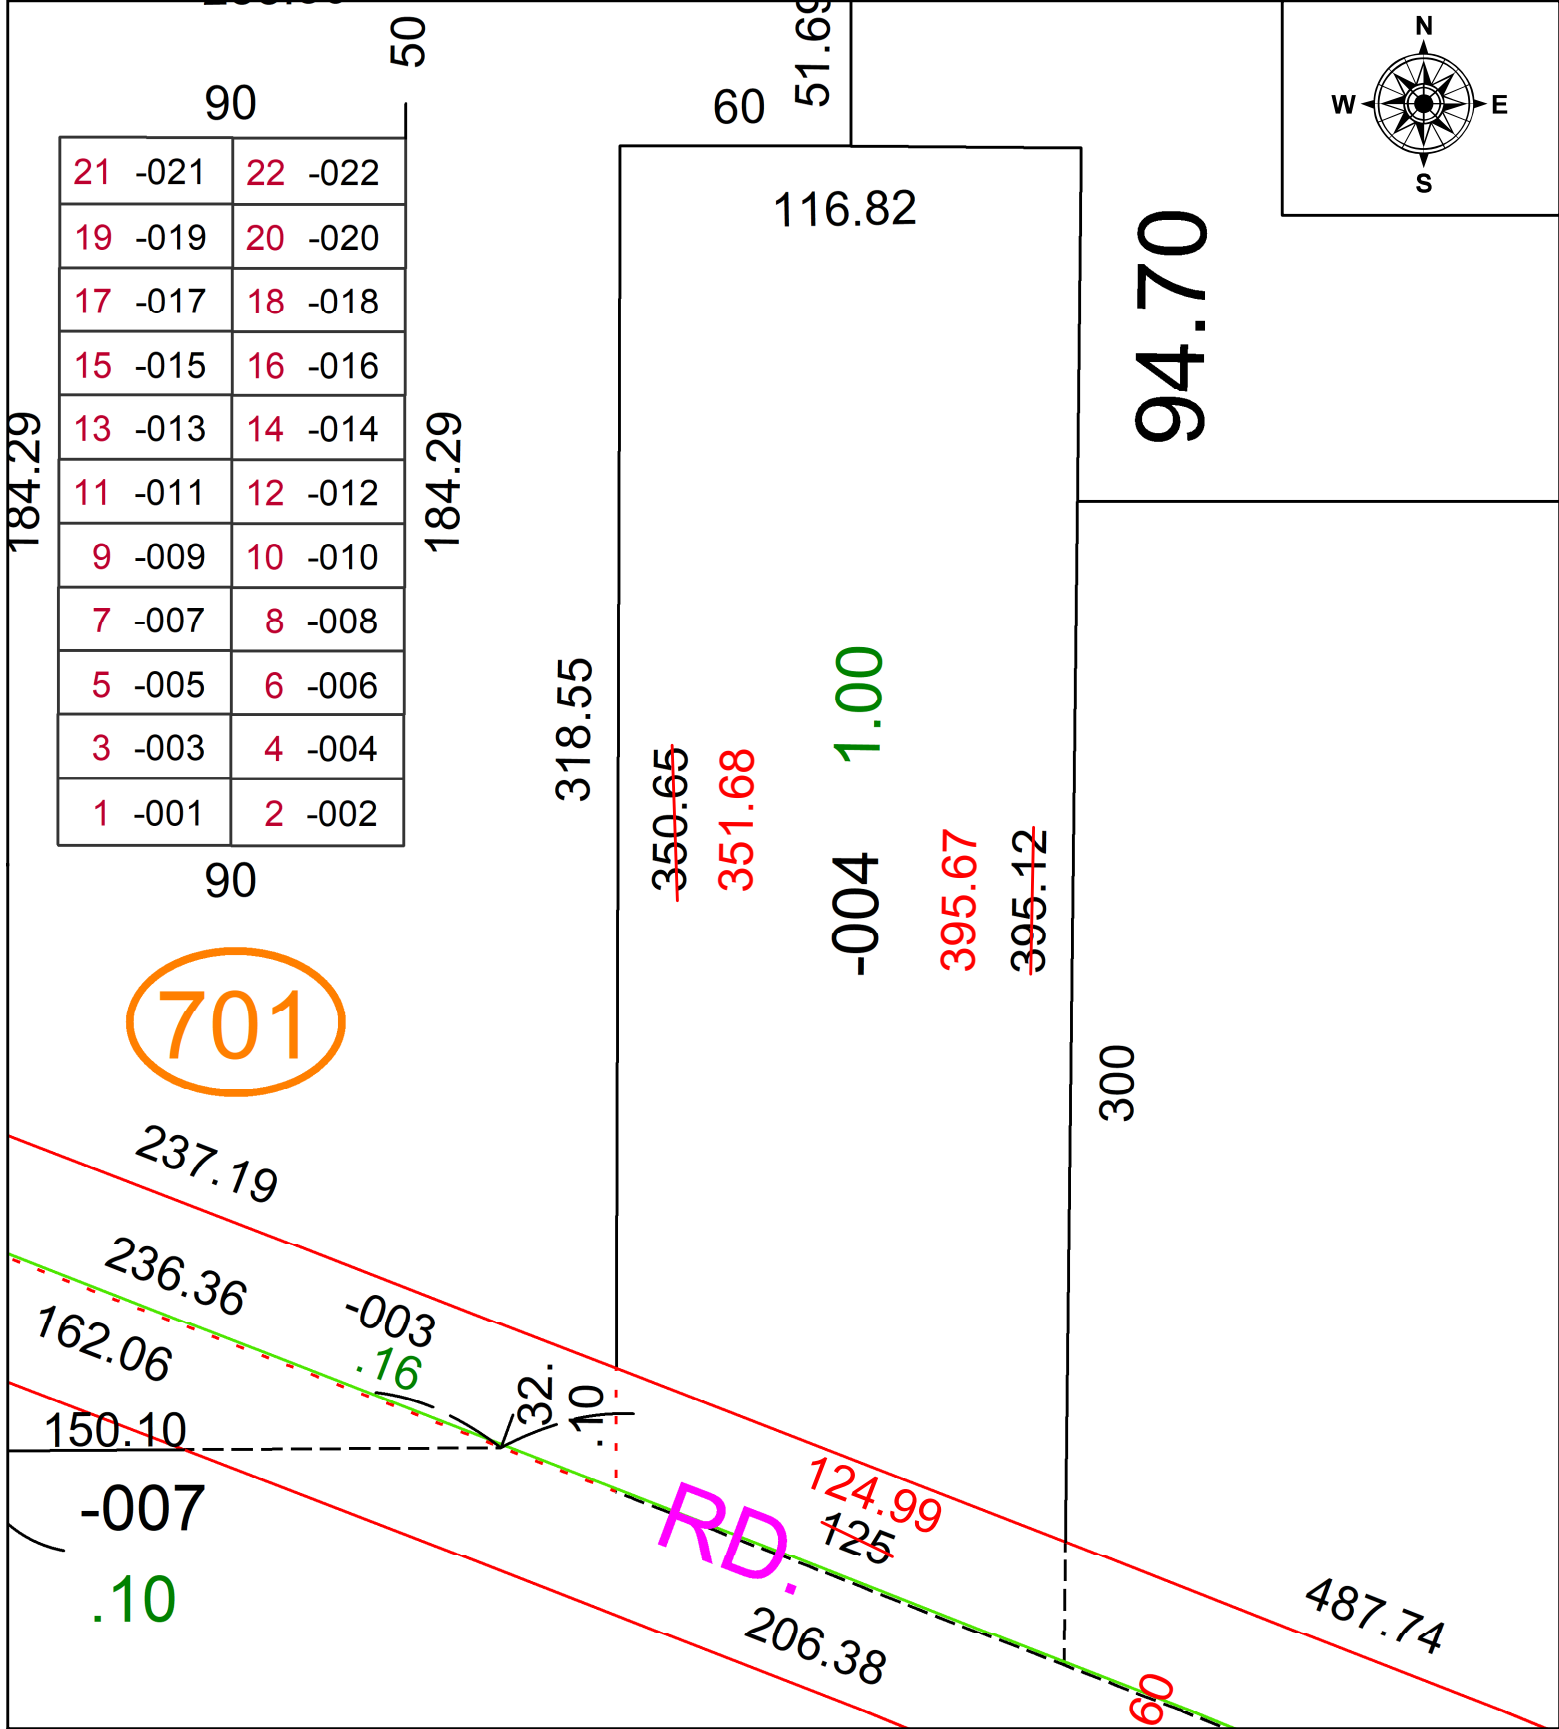
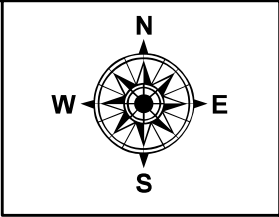


PARENT PARCEL: 07-00-026-101-004
 CHILD PARCEL: **MAP CORRECTION ONLY**
 STARTING POINT: C/L OF SUGAR RIDGE AND AVON-BELDEN RD

24-05399-C

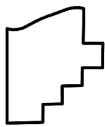

 **SPLITS/DEEDS PROCESSED**
 LORAIN COUNTY TAX MAP DEPARTMENT
 226 MIDDLE AVE. ELYRIA, OH

SURVEYED BY: KYLE R. DANALS SURV # 51320
 CLOSURE: 1: 290506
 MAP PAGE(S): 07-00-026
 APPROVED BY: AC DATE: November 06, 2024
 SCALE: 1 in = 50 ft PRIOR INSTRUMENT: 2013- 0476779