


PARENT PARCEL: 06-25-006-108-004 & -020


CHILD PARCEL: FR & DPTH TO AC CORR PER SURVEYOR THOMAS SIMON

STARTING POINT: NORTHEAST CORNER OF S/L 6 IN SUNSET PARK ALLOTMENT PV 10, PG. 9

24-05400-C

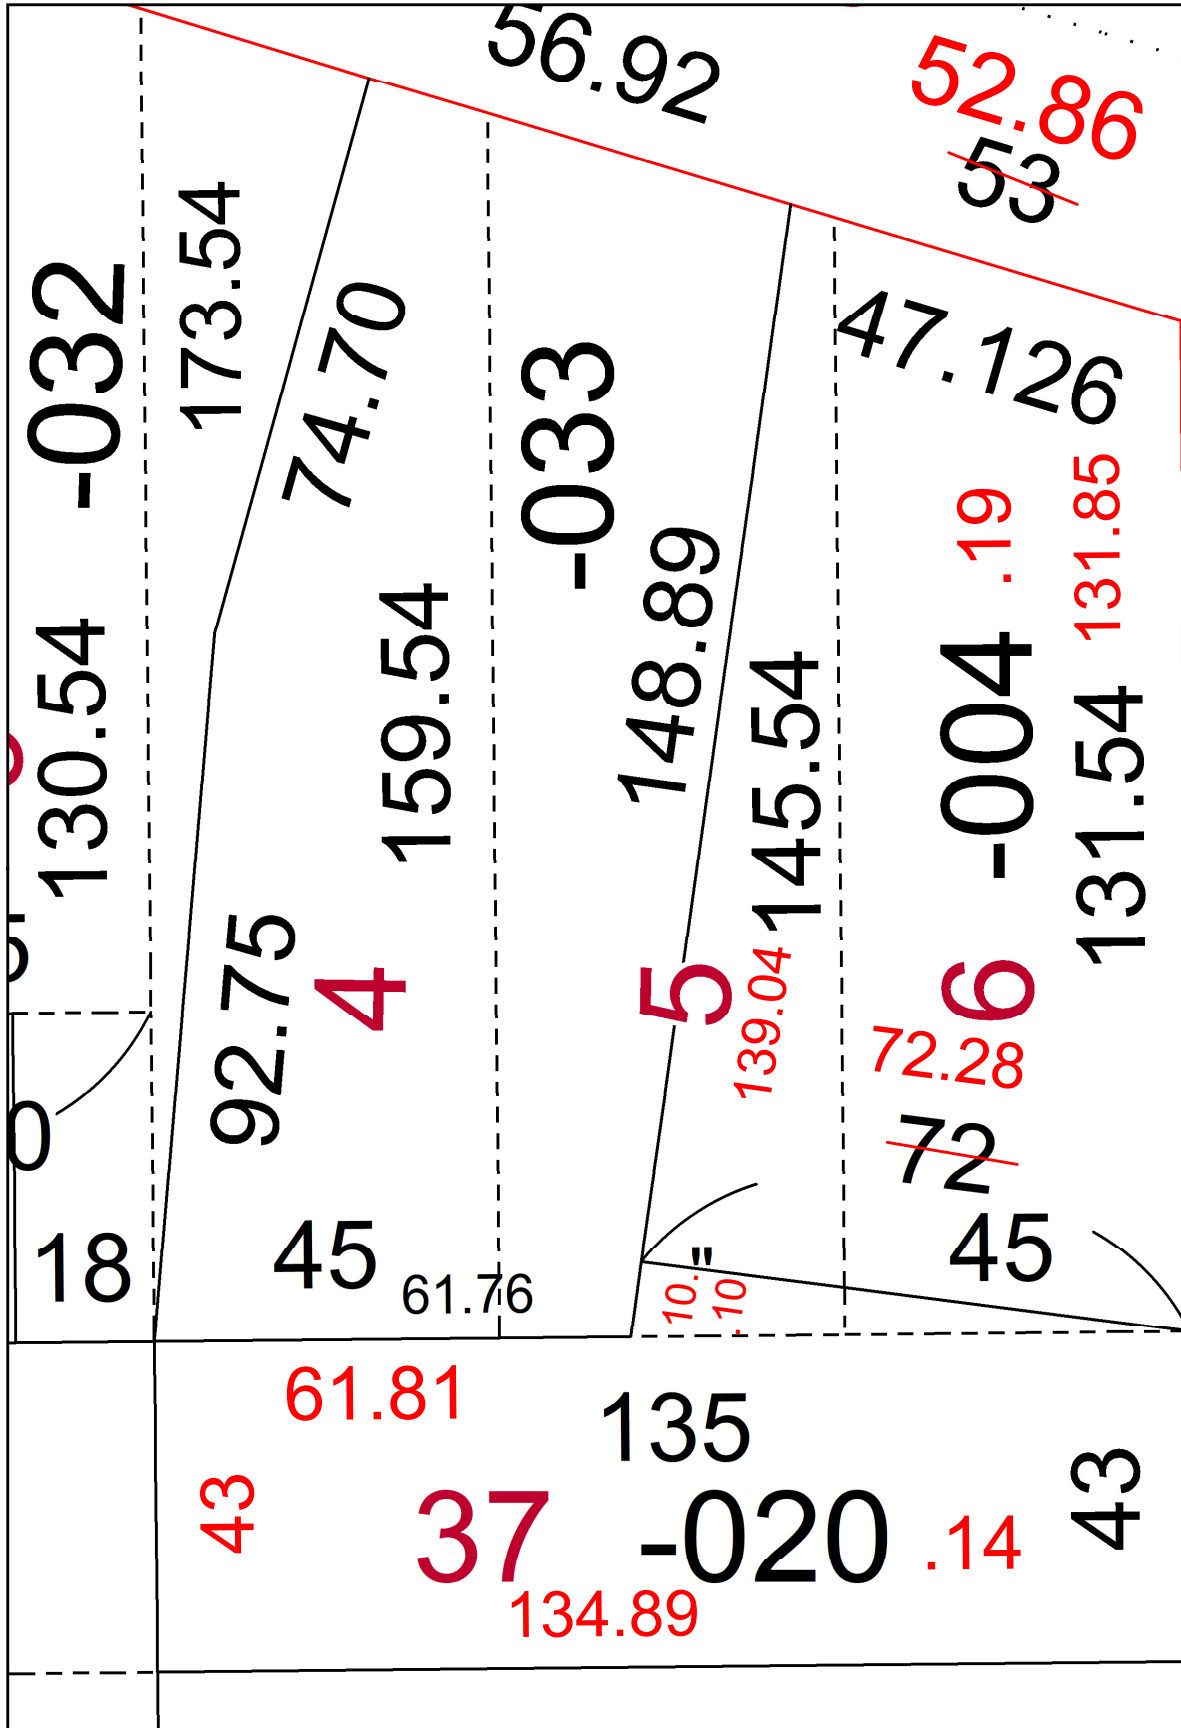

AVE. 50

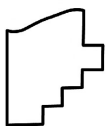

**SPLITS/DEEDS PROCESSED**  
LORAIN COUNTY TAX MAP DEPARTMENT  
226 MIDDLE AVE. ELYRIA, OH

SURVEYED BY:	THOMAS SIMON	SURVEY #	51324
CLOSURE:	1: 85782		
MAP PAGE(S):		06-25-006	
APPROVED BY:	WRZ	DATE:	11/13/2024
SCALE:	1" = 25'	PRIOR INSTRUMENT:	#2024-0032593