
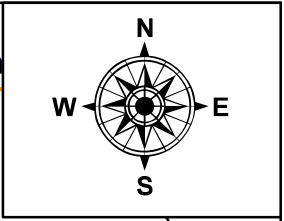


PARENT PARCEL: 11-00-051-000-033

CHILD PARCEL: **MAP CORRECTION ONLY**

24-05402-C

STARTING POINT: INTERSECTION OF BUTTERNUT RIDGE RD AND WESTERLY LINE OF LOT 51

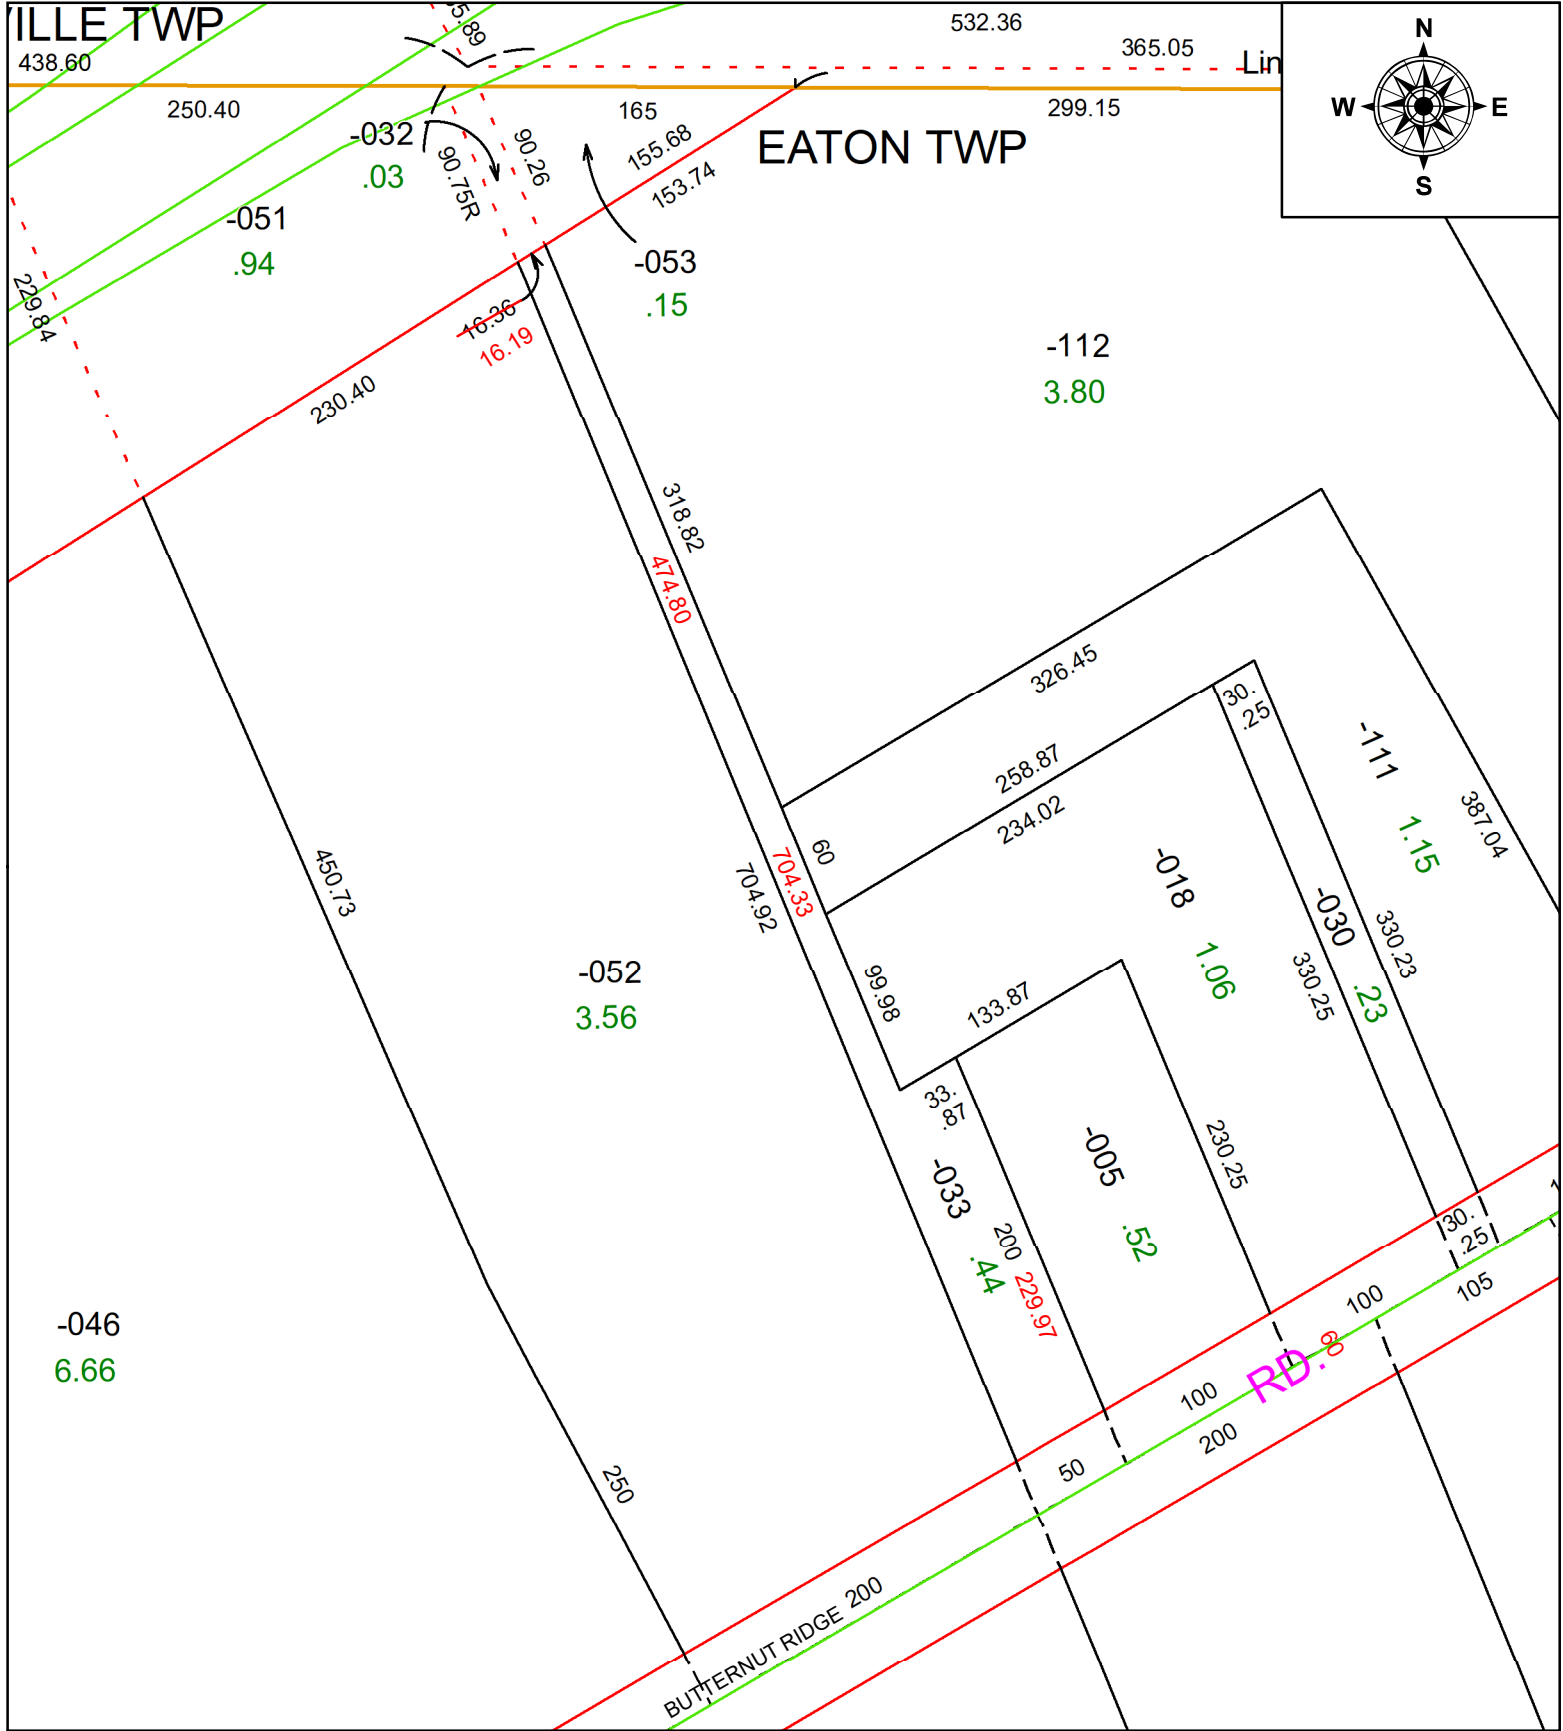

SPLITS/DEEDS PROCESSED
 LORAIN COUNTY TAX MAP DEPARTMENT
 226 MIDDLE AVE. ELYRIA, OH

SURVEYED BY: MICHAEL SHELESTOVICH **SURVEY #:** 51329
CLOSURE: 1: 895049
MAP PAGE(S): 1100051
APPROVED BY: BB **DATE:** 11/21/2024
SCALE: 1" = 100' **PRIOR INSTRUMENT:** #20240017501