


PARENT PARCEL: 09-00-095-103-040

CHILD PARCEL: MAP CORRECTION ONLY


STARTING POINT: INSECTION ROOSEVELT CIR ABD WEST HAMILTON ST

24-05408-C

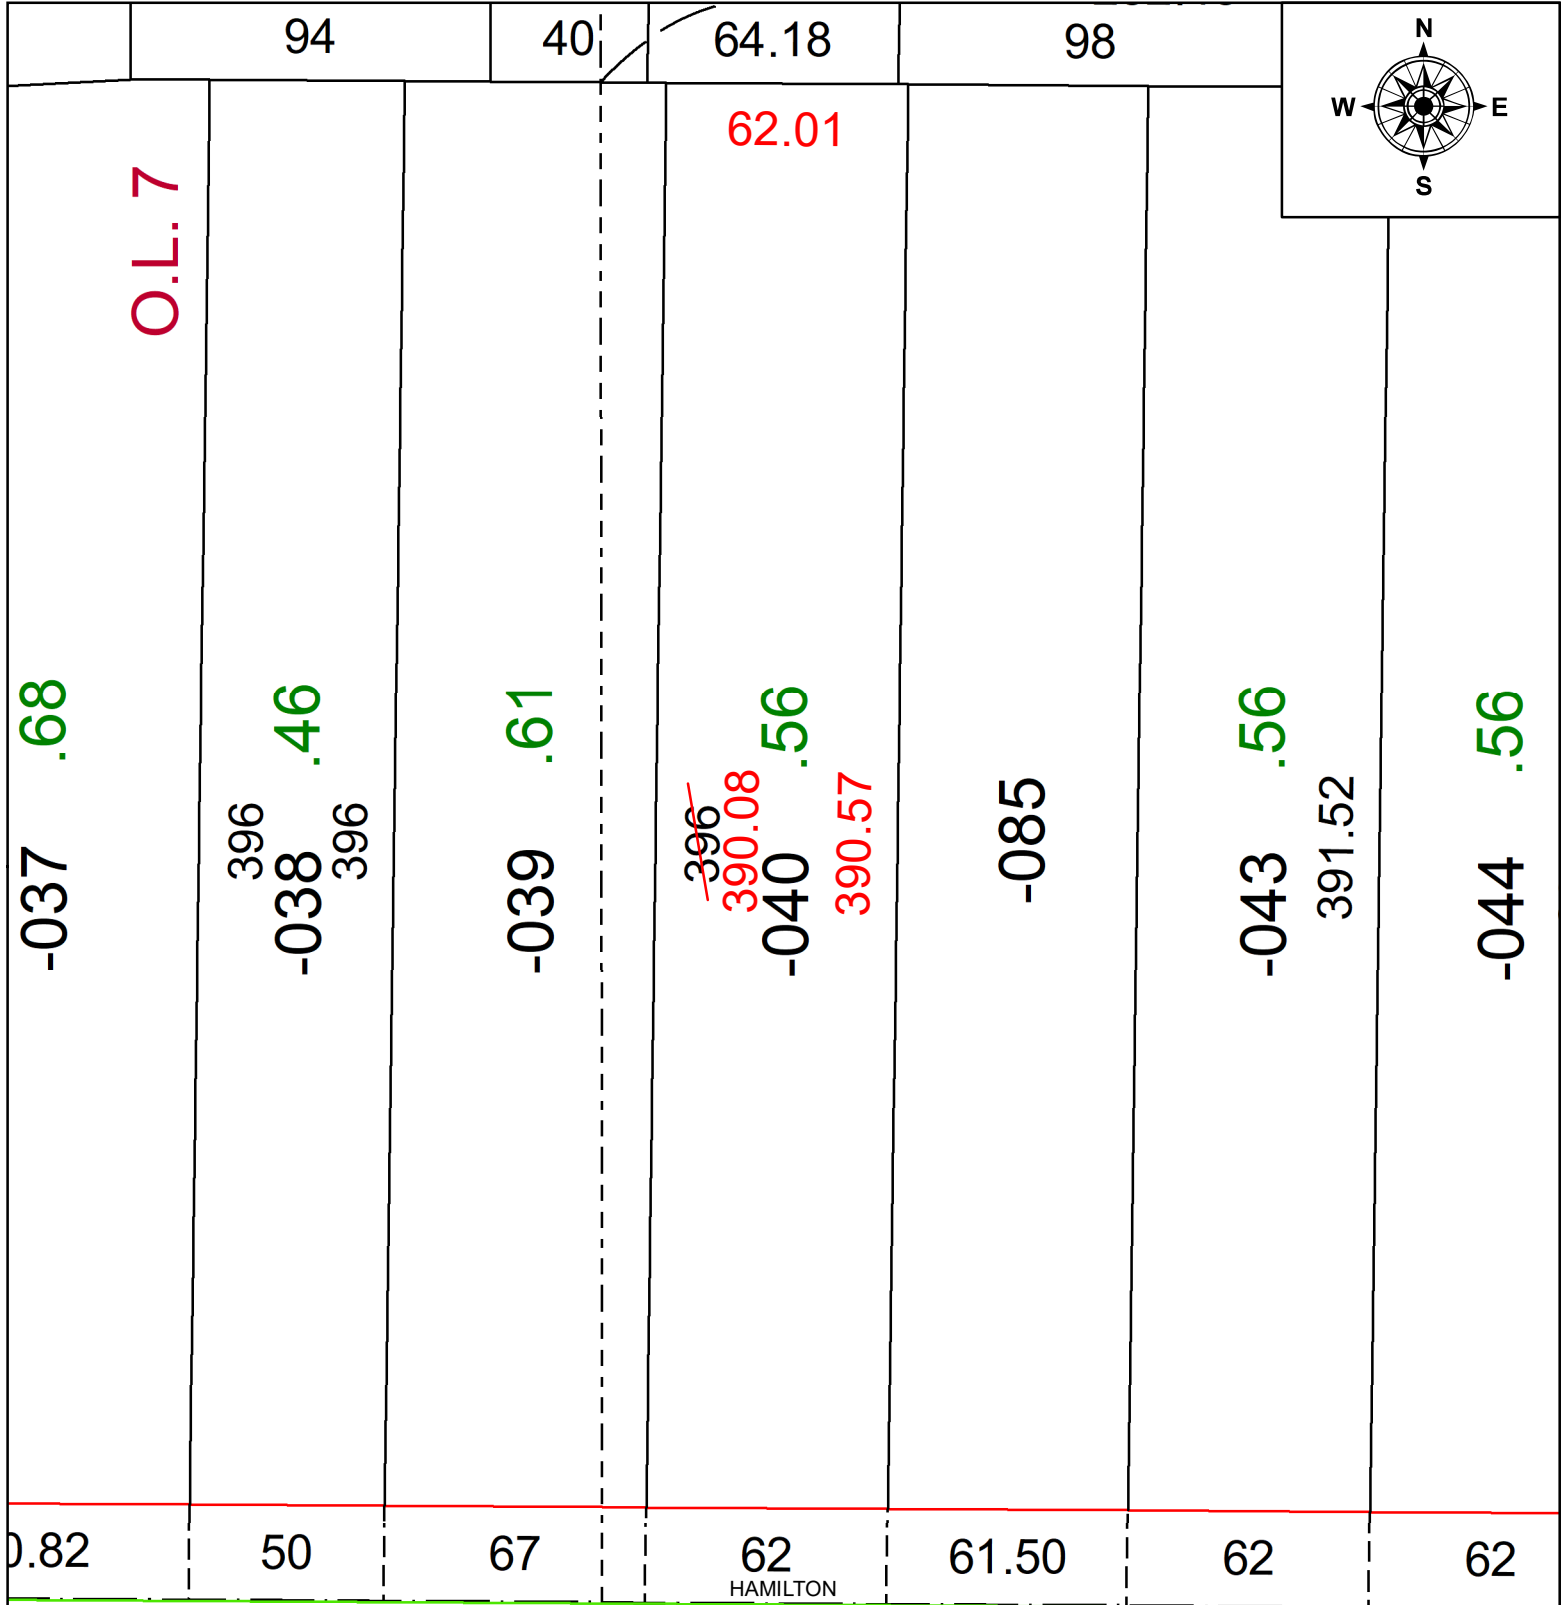

0.82      50      67      62      61.50      62      62

HAMILTON

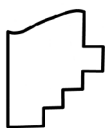

**SPLITS/DEEDS PROCESSED**  
 LORAIN COUNTY TAX MAP DEPARTMENT  
 226 MIDDLE AVE. ELYRIA, OH

**SURVEYED BY:** THOMAS A. SIMON      **SURVEY #:** 51333  
**CLOSURE:** 1: 185443  
**MAP PAGE(S):** 0900095  
**APPROVED BY:** BB      **DATE:** 11/27/2024  
**SCALE:** 1" = 50'      **PRIOR INSTRUMENT:** #20240009129