
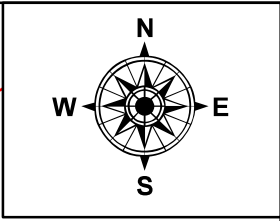


PARENT PARCEL: 07-00-021-118-042 & 07-00-021-119-001
 CHILD PARCEL: 07-00-021-118-052 THRU -054 & 07-00-021-119-160
 STARTING POINT: MAG. NAIL, CL OF ROOT RD. & CL OF CENTER RIDGE RD..

24-05411-V

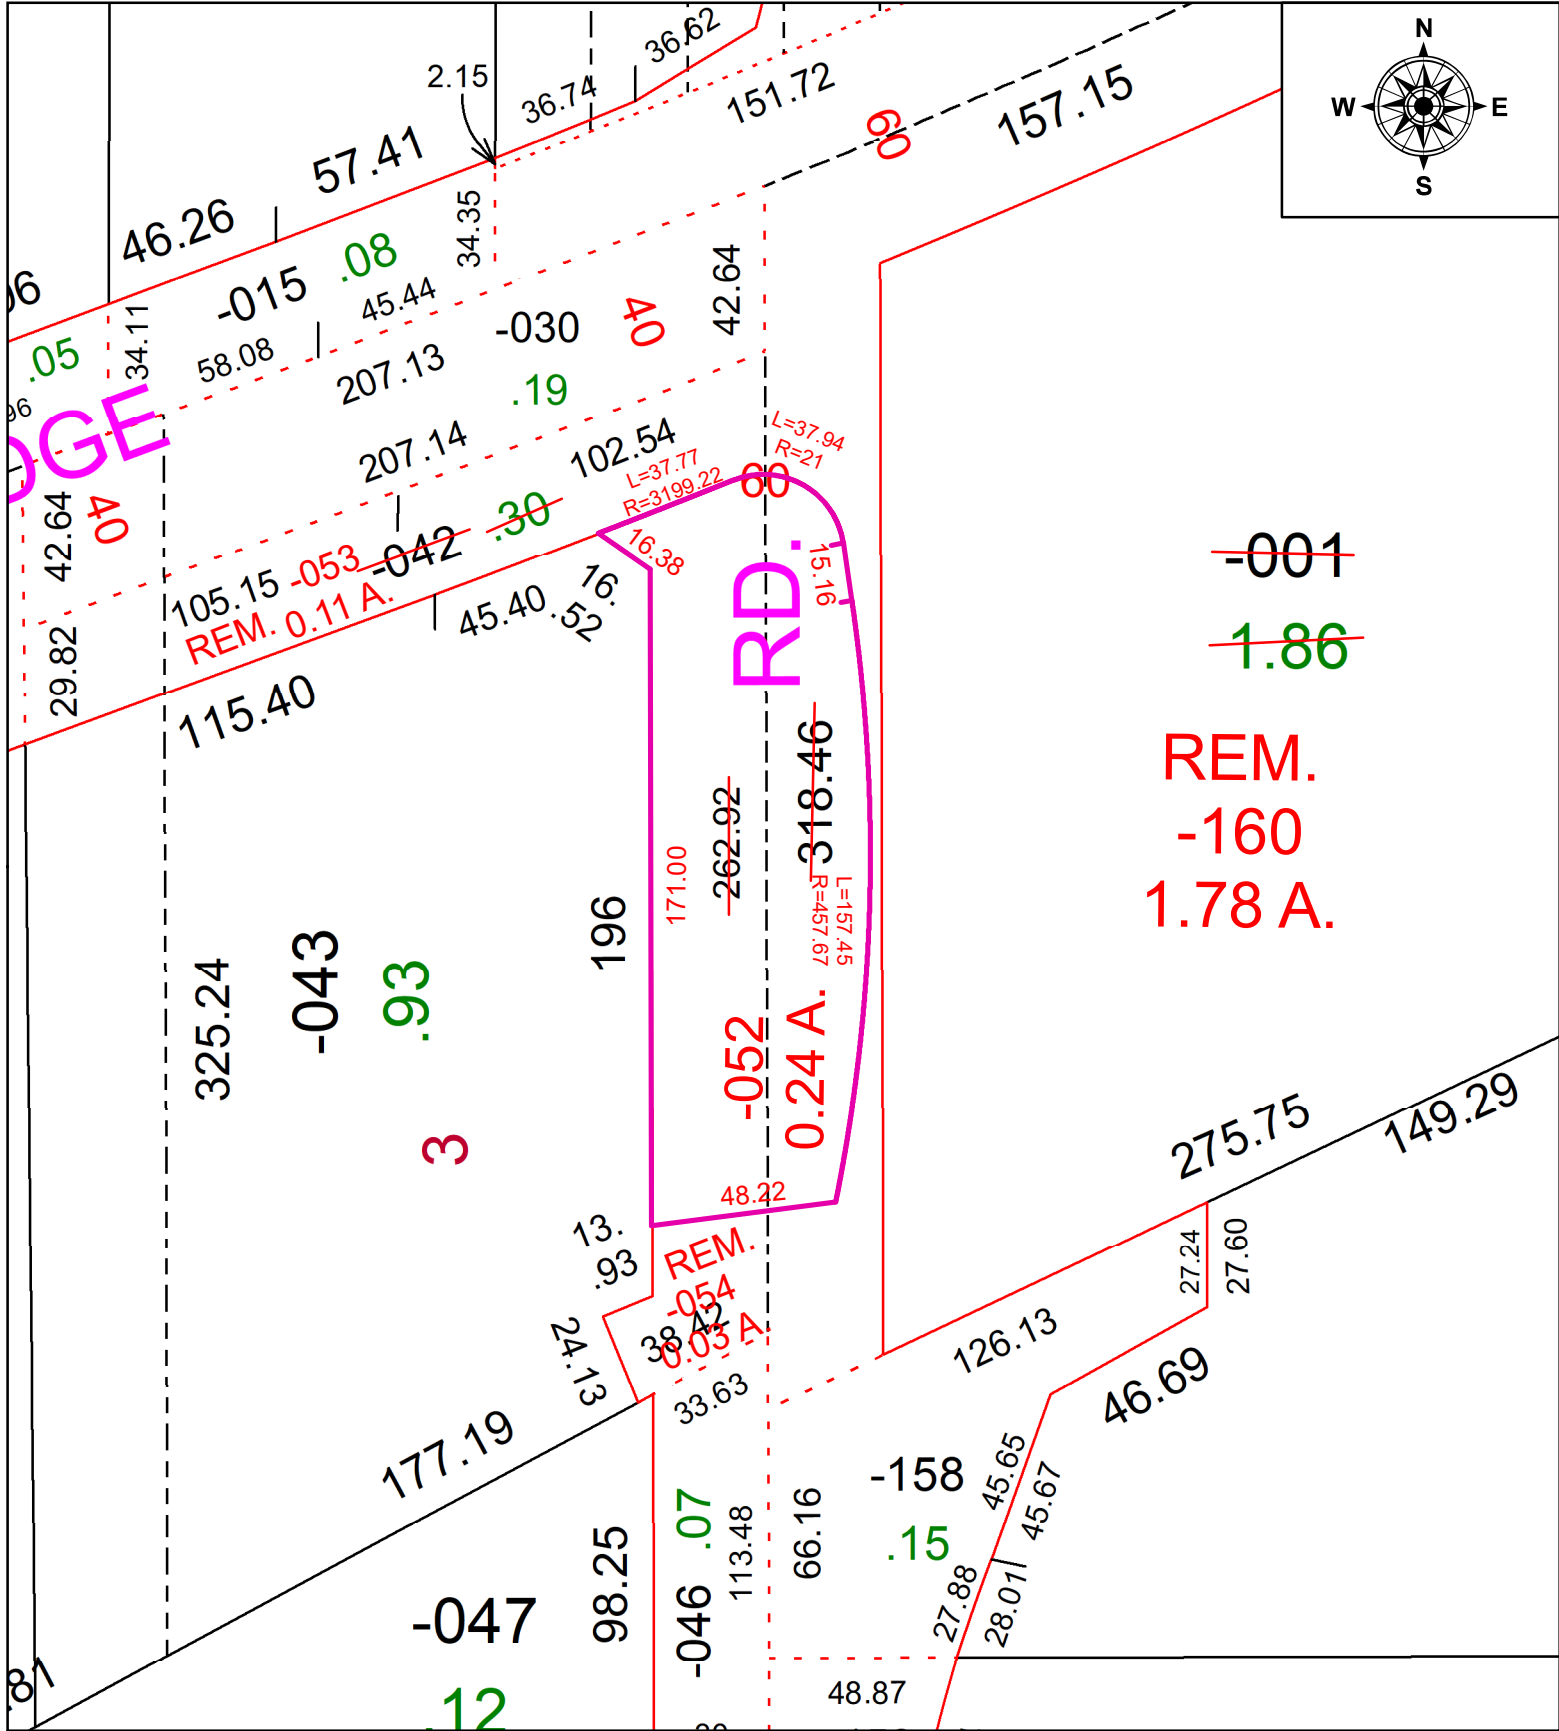

SPLITS/DEEDS PROCESSED
 LORAIN COUNTY TAX MAP DEPARTMENT
 226 MIDDLE AVE. ELYRIA, OH

SURVEYED BY: AMY KELLY
 CLOSURE: 1:161788
 MAP PAGE(S): 07-00-021
 APPROVED BY: TJS DATE: 12/9/2024
 SCALE: 1" = 50' PRIOR INSTRUMENT: 2017-0645224