


PARENT PARCEL: 06-25-016-108-041 UNCOMBINATION PER PRIOR INSTR. #2024-0035360

CHILD PARCEL: 06-25-016-108-049 & -050

STARTING POINT: N/A

24-05416-U

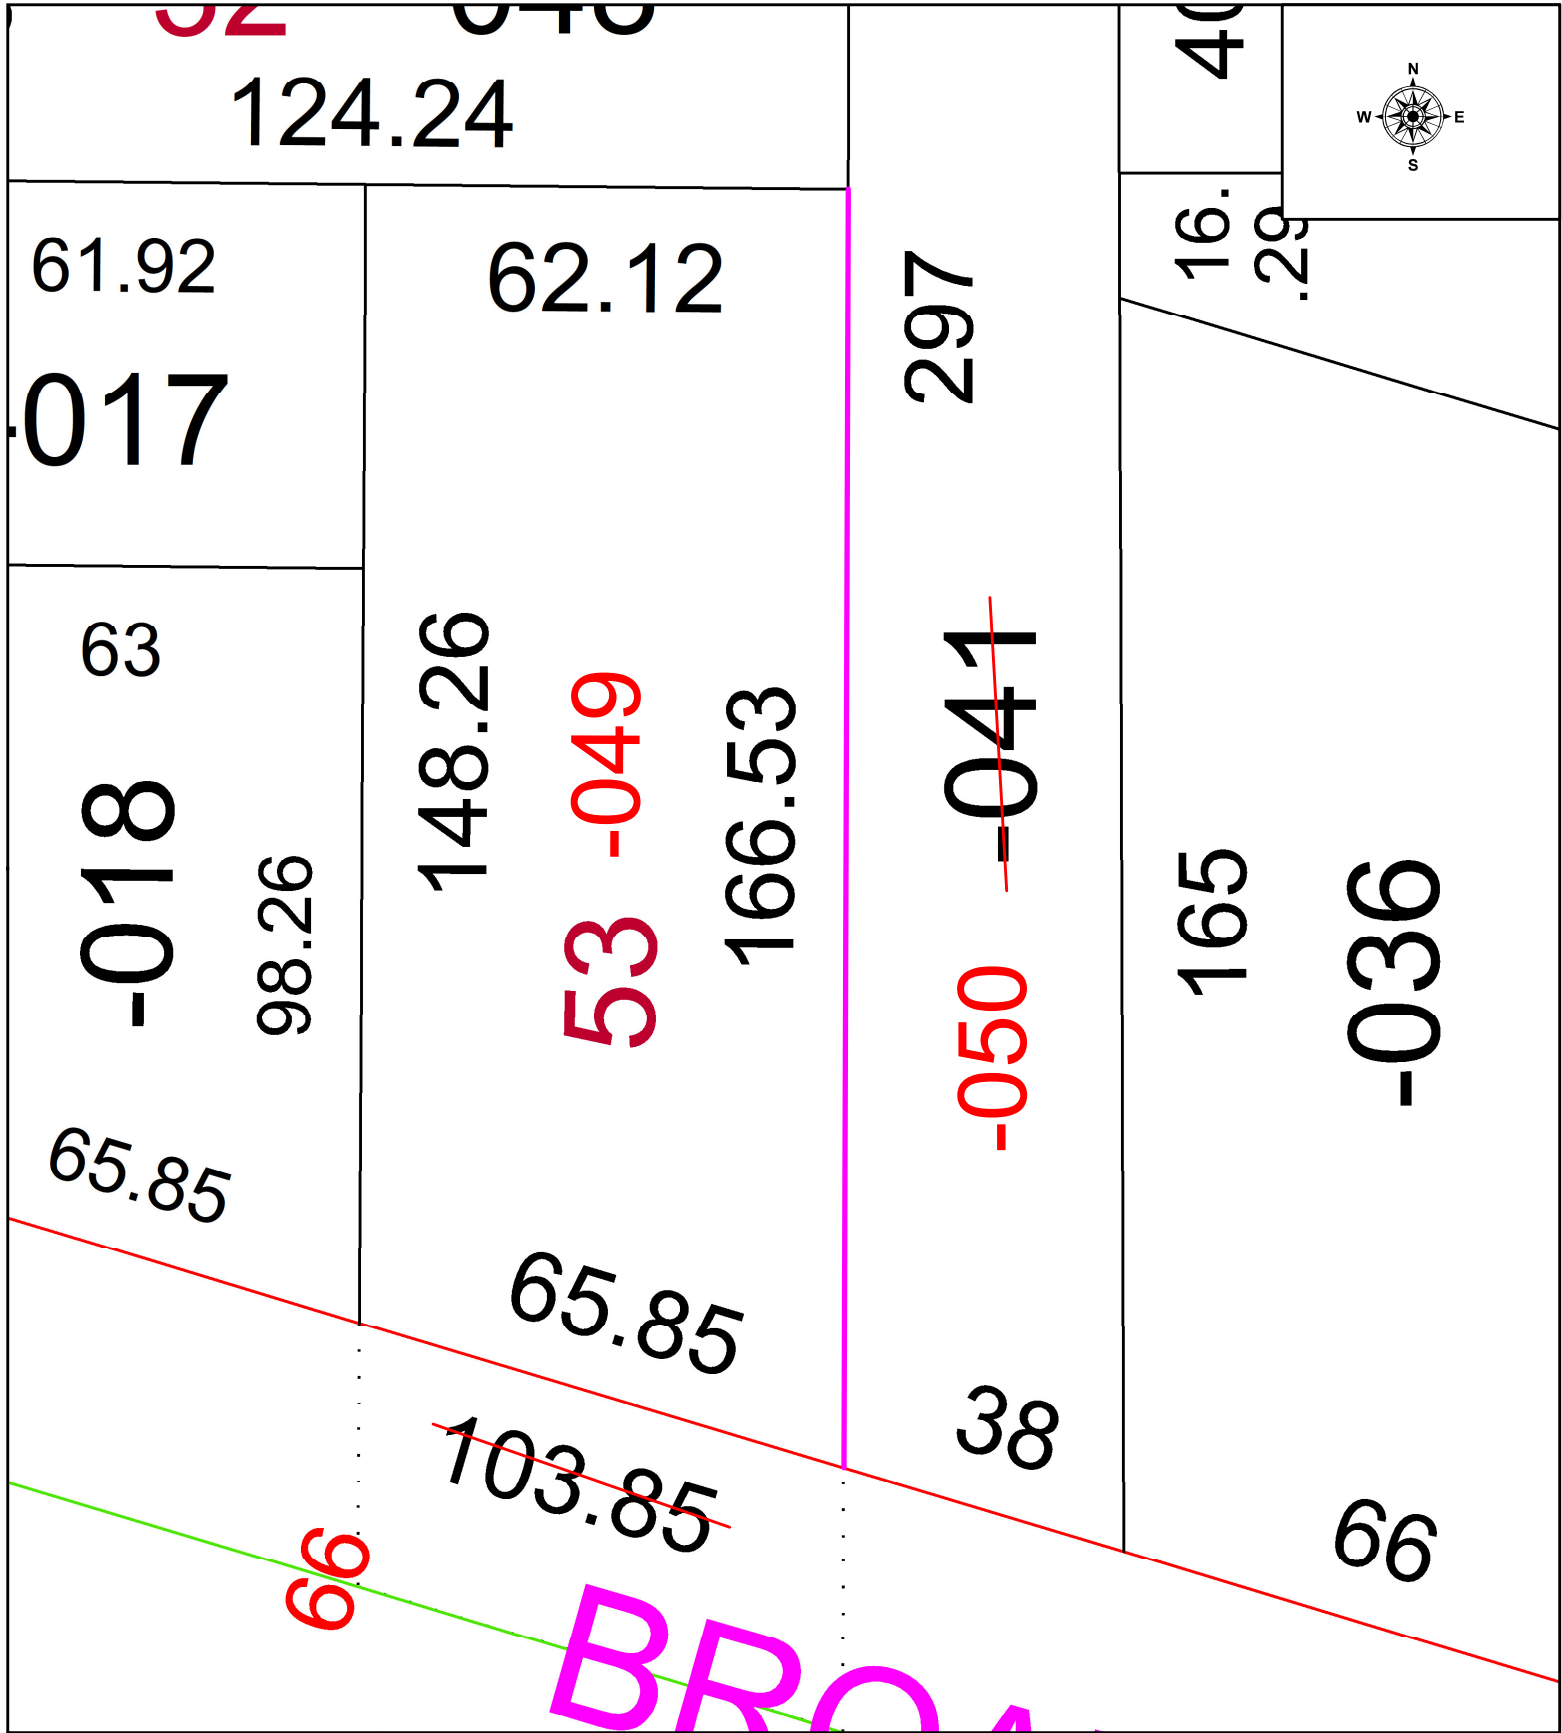

SPLITS/DEEDS PROCESSED
 LORAIN COUNTY TAX MAP DEPARTMENT
 226 MIDDLE AVE. ELYRIA, OH

SURVEYED BY: N/A SURVEY # N/A
 CLOSURE: 1:
 MAP PAGE(S): 06-25-016
 APPROVED BY: WRZ DATE: 12/4/2024
 SCALE: 1" = 25 PRIOR INSTRUMENT: #2024-0035360